

RECEIVED

SEP 26 2007

POLARIS ENGINEERING  
& SURVEYING

APPROVED AS NOTED

WILLOWICK BUILDING DEPT

Signature

*Daniel Ruth*

Date

9/25/07

Stormwater Management Plan  
Approved as shown and/or noted  
JAMES R. GILLS, P.E.  
County Drainage Engineer



By *J.S.* Date 10/3/07

SITE PLAN FOR:  
SUBLOT No. 41, Add.#204  
PPN: 28-A-041-N-00-041-0  
SHORELAND CROSSINGS No.2  
CITY OF WILLOWICK - LAKE COUNTY - OHIO

SURVEYOR CERTIFICATION

I HEREBY CERTIFY THAT I HAVE SURVEYED THE PREMISES AND PREPARED THE ATTACHED PLAT IN ACCORDANCE WITH THE PROVISIONS OF CHAPTER 4733-37 OF THE OHIO ADMINISTRATIVE CODE AND THE DIMENSIONS OF THE LOTS AND ROAD ARE IN FEET AND DECIMAL PARTS THEREOF, ALL OF WHICH ARE CORRECT TO THE BEST OF MY KNOWLEDGE AND BELIEF. IRON MONUMENTS OR PINS AS INDICATED WERE FOUND OR SET AS SHOWN HEREON.

*[Signature]* 9-5-07  
DATE 9/5/07 P.S. #7087 DATE

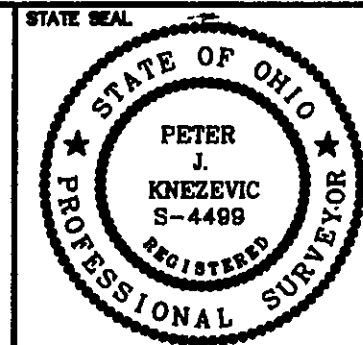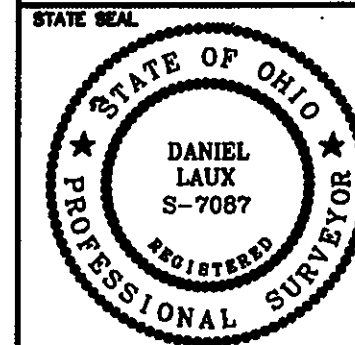

DESIGN CERTIFICATION

THIS PLAN WAS PREPARED BY ME,  
AND IS CORRECT TO THE BEST  
OF MY KNOWLEDGE AND BELIEF.

*Peter J. Knezevic* 9-5-07  
PETER J. KNEZEVIC, P.S.4499 DATE

"AS-BUILT" CERTIFICATION

I HEREBY CERTIFY THAT THE CIRCLED INFORMATION  
IS EXISTING AS OBTAINED ON THE SITE  
AND IS CORRECT TO THE BEST OF MY KNOWLEDGE  
AND BELIEF.

NAME DATE

Prepared By:  
PETER J. KNEZEVIC, P.S.  
30102 Rickey Lane  
Wickliffe, Ohio 44092  
(440)944-3794

Prepared For:  
B.R. Knez Construction, Inc.  
3375 Blackmore Road  
Perry Township, Ohio 44081  
(440)259-0067

BENCHMARK:

B.M. = T.B.M Set On Rim Ex. San. Manhole  
Located Opposite S/L 41  
Elevation 820.24

DATE: 9/5/07  
SCALE: HOR. 1"=30'  
VERT. 1"=0'  
FILENAME: subplot\_41 topo.dwg  
COMPUTER: S  
CREW CHIEF: R.D.W.

CONTRACT No.

07067-S/L 41

SHEET OF  
1 1

APPROVED

BY *Polaris Engineering*  
*Chg* 9/26/07

DATE

THIS APPROVAL IS FOR GENERAL PLAN & SCOPE ONLY AND DOES NOT RELIEVE THE AUTHOR OF THESE DOCUMENTS FROM PROFESSIONAL RESPONSIBILITY FOR ACCURACY OF DESIGN, CONFORMITY TO APPLICABLE ORDINANCES AND ERRORS OR OMISSIONS

GRAPHIC SCALE



( IN FEET )  
1 inch = 30 ft.



2 WORKING DAYS  
BEFORE YOU DIG



CALL TOLL FREE 800-362-2764

OHIO UTILITIES PROTECTION SERVICE  
NON-MEMBERS MUST BE CALLED DIRECT

NOTE: HOUSE DIMENSIONS AND FLOOR  
ELEVATIONS TO BE VERIFIED BY  
ARCHITECT & BUILDER.

NOTE:  
Backflow Preventor Required  
For Sanitary Connections.

EXISTING UNDERGROUND UTILITIES NOTE:  
THE SIZE AND LOCATION, BOTH HORIZONTAL AND VERTICAL  
OF THE UNDERGROUND UTILITIES SHOWN HEREON, HAVE BEEN  
OBTAINED BY A SEARCH OF AVAILABLE RECORDS. VERIFICATION  
BY FIELD OBSERVATION HAS BEEN CONDUCTED WHERE PRACTICAL.  
HOWEVER, DESIGNER DOES NOT GUARANTEE THE COMPLETENESS  
NOR ACCURACY THEREOF.

Site & Grade Hse. 9-5-07