


Stormwater Management Plan  
Approved as shown and/or noted  
JAMES R. GILLS, P.E.  
County Drainage Engineer  
By L.S. Date 9/14/07

NOT PART OF SUBDIVISION  
91,389 sq.ft.  
2.0680 acres

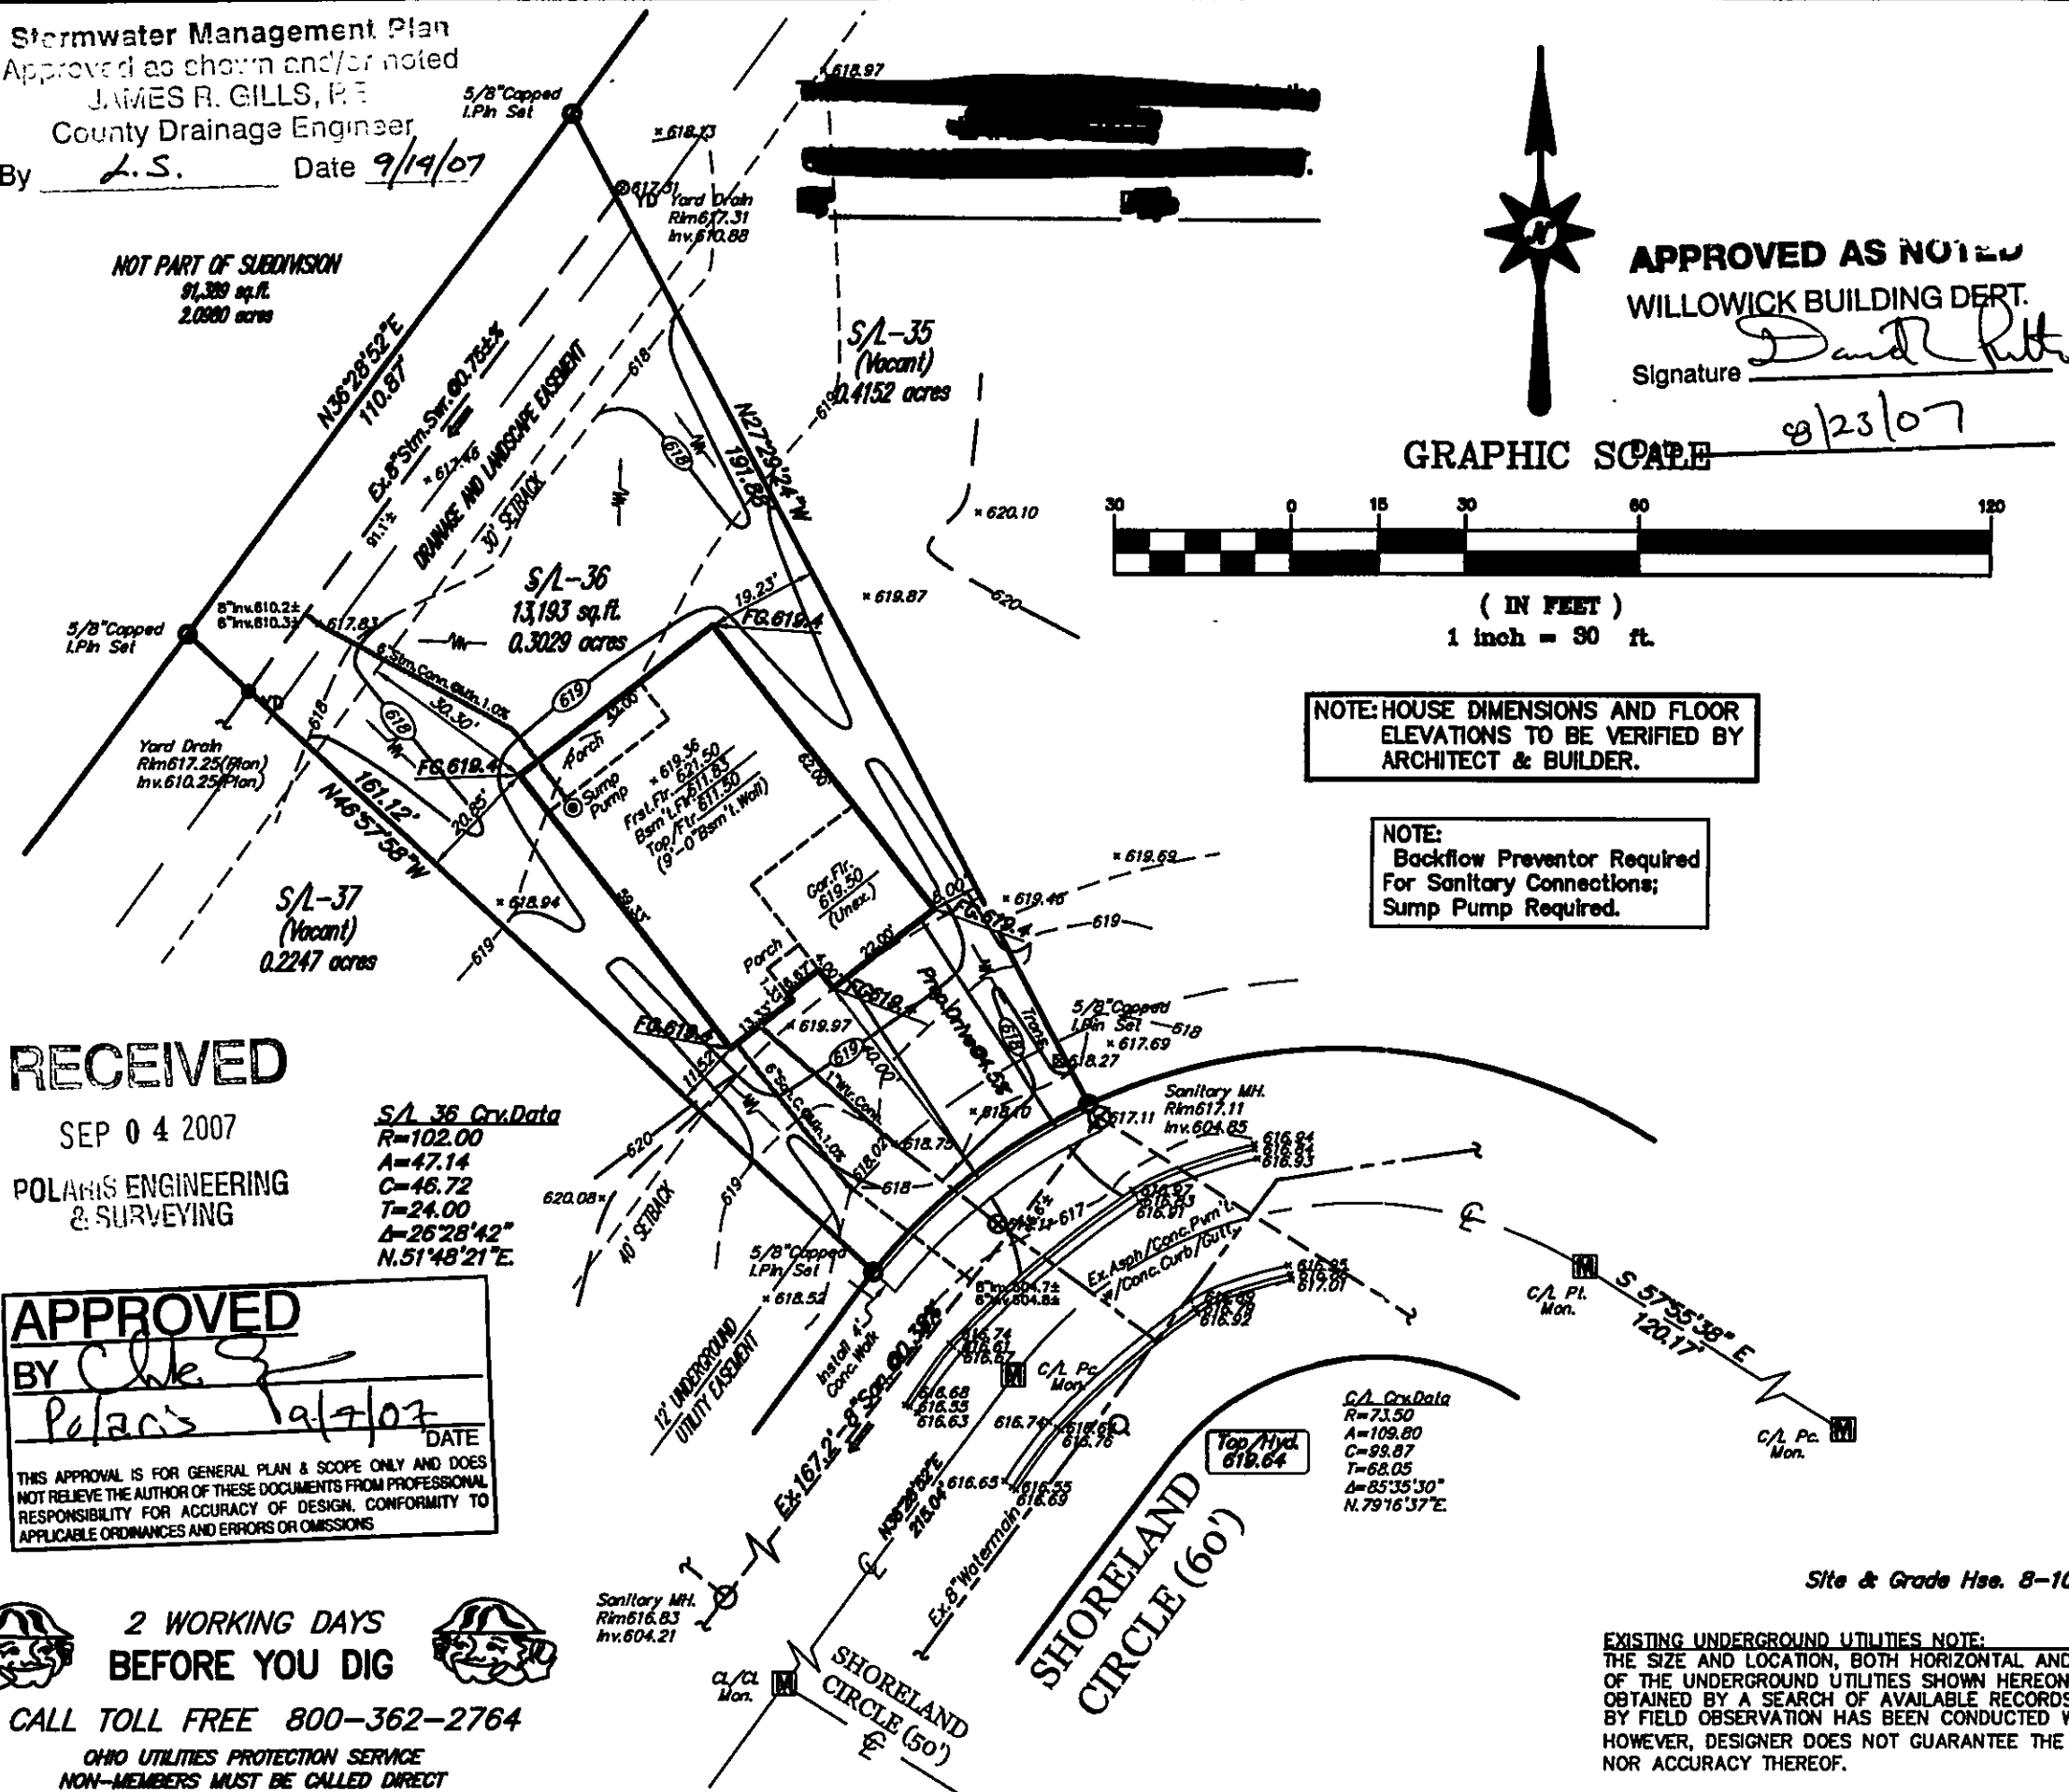

SITE PLAN FOR:  
SUBLOT No. 36  
SHORELAND CROSSINGS No.2  
CITY OF WILLOWICK - LAKE COUNTY - OHIO

SURVEYOR CERTIFICATION


I HEREBY CERTIFY THAT I HAVE SURVEYED THE PREMISES AND PREPARED THE ATTACHED PLAN IN ACCORDANCE WITH THE PROVISIONS OF CHAPTER 4733-37 OF THE OHIO ADMINISTRATIVE CODE AND THE DIMENSIONS OF THE LOTS AND ROAD ARE IN FEET AND DECIMAL PARTS THEREOF, ALL OF WHICH ARE CORRECT TO THE BEST OF MY KNOWLEDGE AND BELIEF, FROM MONUMENTS OR PINS AS INDICATED WERE FOUND OR SET AS SHOWN HEREON.

Dan Laux 8-9-07  
DANIEL LAUX P.S. #7087 DATE

STATE SEAL



STATE SEAL

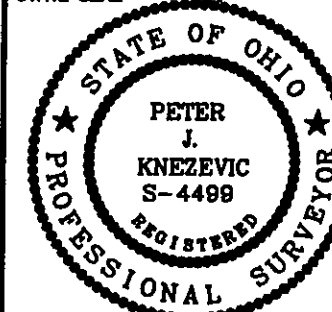

DESIGN CERTIFICATION

THIS PLAN WAS PREPARED BY ME,  
AND IS CORRECT TO THE BEST  
OF MY KNOWLEDGE AND BELIEF.

Peter J. Knezevic 9-7-07  
PETER J. KNEZEVIC, P.S.4499 DATE

"AS-BUILT" CERTIFICATION

I HEREBY CERTIFY THAT THE CIRCLED INFORMATION  
IS EXISTING AS OBTAINED ON THE SITE  
AND IS CORRECT TO THE BEST OF MY KNOWLEDGE  
AND BELIEF.

NAME

DATE

Prepared By:

PETER J. KNEZEVIC, P.S.  
30102 Rickey Lane  
Wickliffe, Ohio 44092  
(440)944-3794

Prepared For:

B.R. Knez Construction, Inc.  
3375 Blackmore Road  
Perry Township, Ohio 44081  
(440)259-0087

BENCHMARK:

B.M. = T.B.M. Set On Top Of Hydrant  
Located Opposite Of S/L 36  
Elevation 619.64

DATE: 8/10/07

SCALE: HOR. 1"=30'

VERT. 1"=5'

FILENAME: sublot\_36\_topo.dwg

COMPUTER: S

CREW CHIEF: P.C.S.

CONTRACT No.

07067-S/L 36

SHEET

OF

1

1



2 WORKING DAYS  
BEFORE YOU DIG



CALL TOLL FREE 800-362-2764

OHIO UTILITIES PROTECTION SERVICE  
NON-MEMBERS MUST BE CALLED DIRECT

EXISTING UNDERGROUND UTILITIES NOTE:  
THE SIZE AND LOCATION, BOTH HORIZONTAL AND VERTICAL  
OF THE UNDERGROUND UTILITIES SHOWN HEREON, HAVE BEEN  
OBTAINED BY A SEARCH OF AVAILABLE RECORDS. VERIFICATION  
BY FIELD OBSERVATION HAS BEEN CONDUCTED WHERE PRACTICAL.  
HOWEVER, DESIGNER DOES NOT GUARANTEE THE COMPLETENESS  
NOR ACCURACY THEREOF.