


**NOTES:**  
Backflow Preventor Required For Sanitary Connections.  
Cleanouts shall be provided for sanitary & storm connections. Cleanouts to be located @ the back of utility or drainage easement, respectively. All Cleanout Risers should be 6" diameter and have Cast Iron Caps.  
Sanitary Connections Shall Be 6" At Minimum 1.0%  
Storm Connections Shall Be 6" At Minimum 1.0%  
Water Connections To Be 1"

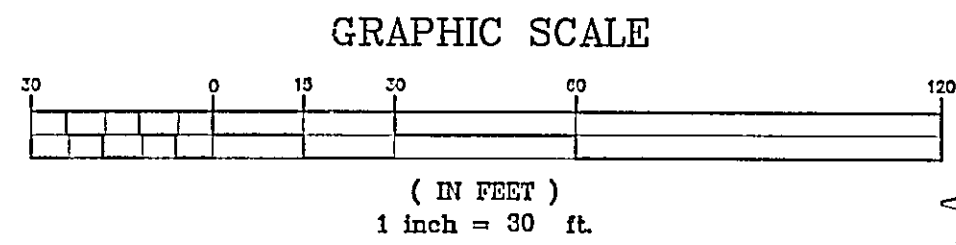

**2 WORKING DAYS BEFORE YOU DIG**  
CALL TOLL FREE 800-362-2764  
OHIO UTILITIES PROTECTION SERVICE  
NON-MEMBERS MUST BE CALLED DIRECT

Stormwater Management Plan  
Approved as shown and/or noted  
**JAMES R. GILLS, P.E.**  
County Drainage Engineer  
L.S. Date 3/30/09

**REVIEWED BY:**  
Polaris Engineering & Surveying, Inc.  
*Chuck Szabo* 3/13/09  
Name \_\_\_\_\_ Date \_\_\_\_\_  
This Review is for general plan & accepts only and does not relieve the author of these documents from professional responsibility for accuracy of design conformity to applicable ordinances and errors or omissions.

**NOTE: HOUSE DIMENSIONS AND FLOOR ELEVATIONS TO BE VERIFIED BY ARCHITECT & BUILDER.**


**NOTE:**  
Backflow Preventor Required For Sanitary Connections.

**EXISTING UNDERGROUND UTILITIES NOTE:**  
THE SIZE AND LOCATION, BOTH HORIZONTAL AND VERTICAL OF THE UNDERGROUND UTILITIES SHOWN HEREON, HAVE BEEN OBTAINED BY A SEARCH OF AVAILABLE RECORDS. VERIFICATION BY FIELD OBSERVATION HAS BEEN CONDUCTED WHERE PRACTICAL. HOWEVER, DESIGNER DOES NOT GUARANTEE THE COMPLETENESS NOR ACCURACY THEREOF.

Sito & Grada Hse. 3-19-09

SITE PLAN FOR:  
SUBLOT No.23, Add.#239  
PPN: 28-A-041-N-00-023-0  
**SHORELAND CROSSINGS No.2**  
CITY OF WILLOWICK - LAKE COUNTY - OHIO

**SURVEYOR CERTIFICATION**  
I HEREBY CERTIFY THAT I HAVE SURVEYED THE PREMISES AND PREPARED THE ATTACHED PLAN IN ACCORDANCE WITH THE PROVISIONS OF CHAPTER 4733-37 OF THE OHIO ADMINISTRATIVE CODE AND THE DIMENSIONS OF THE LOTS AND ROAD ARE IN FEET AND DECIMAL PARTS THEREOF, ALL OF WHICH ARE CORRECT TO THE BEST OF MY KNOWLEDGE AND BELIEF, 1804 MONUMENTS OR PINS AS INDICATED WERE FOUND OR SET AS SHOWN HEREON.  
*Daniel Laux*  
DANIEL LAUX P.S. #7087 DATE \_\_\_\_\_

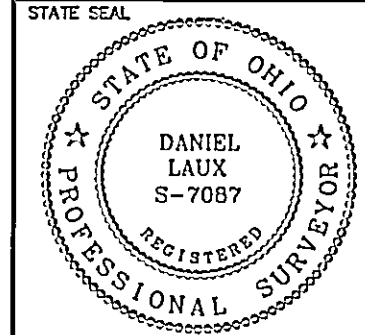

**DESIGN CERTIFICATION**  
THIS PLAN WAS PREPARED BY ME, AND IS CORRECT TO THE BEST OF MY KNOWLEDGE AND BELIEF.  
*Peter J. Knezevic*  
PETER J. KNEZEVIC, P.S.4499 DATE \_\_\_\_\_

**"AS-BUILT" CERTIFICATION**  
I HEREBY CERTIFY THAT THE CIRCLED INFORMATION IS EXISTING AS OBTAINED ON THE SITE AND IS CORRECT TO THE BEST OF MY KNOWLEDGE AND BELIEF.

NAME \_\_\_\_\_ DATE \_\_\_\_\_  
Prepared By: PETER J. KNEZEVIC, P.S.  
30102 Rickay Lane  
Wildliffe, Ohio 44092  
(440)944-3794  
Prepared For: B.R. Knez Construction, Inc.  
8023 Crile Road  
Unit 250  
Concord Township, Ohio 44077  
(440)710-0711

**BENCHMARK:**  
B.M. = T.B.M Set On Top Of Hydrant  
Located As Noted  
Elevation 620.27

DATE: <u>3/19/09</u>	CONTRACT No.
SCALE: HOR. <u>1"=30'</u>	<b>07067-S/L 23</b>
VERT. _____	SHEET
FILENAME: <u>Sublot 23 topo.dwg</u>	OF
COMPUTER: <u>S</u>	1
CREW CHIEF: <u>B.D.V.</u>	1

CURB DATA					
CURB	10' W/	10' E/	10' W/	10' E/	10' E/
C1	11.10	72.00	72.00	101.22	1172.1222
C2	21.52	97.00	11.01	21.51	55125.132