



LAK-2-0.00

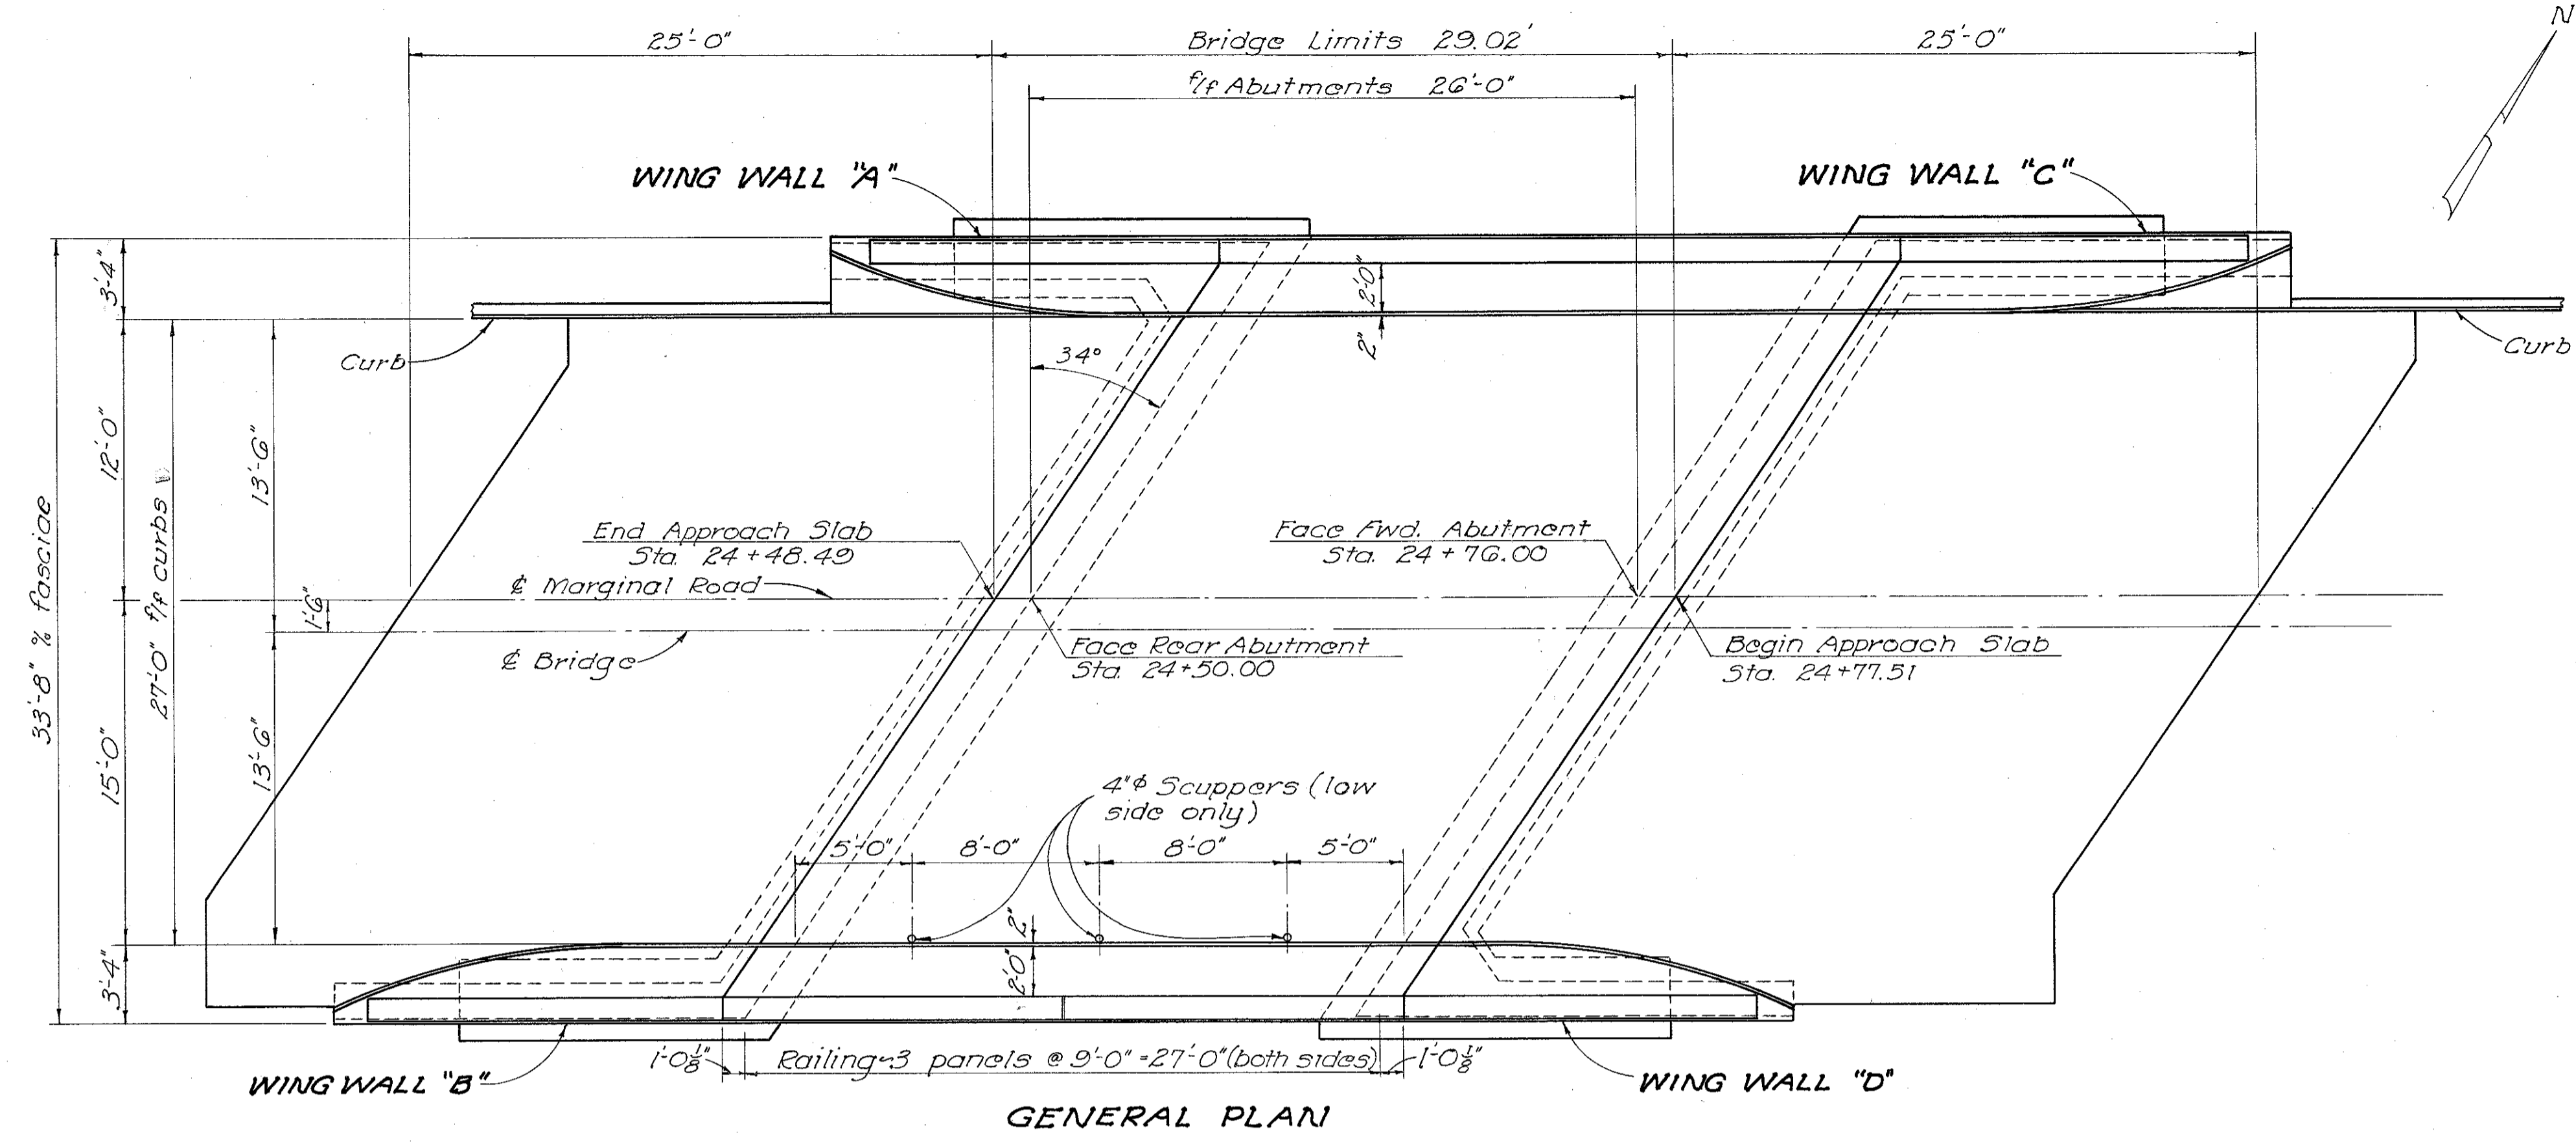

GENERAL PLAN

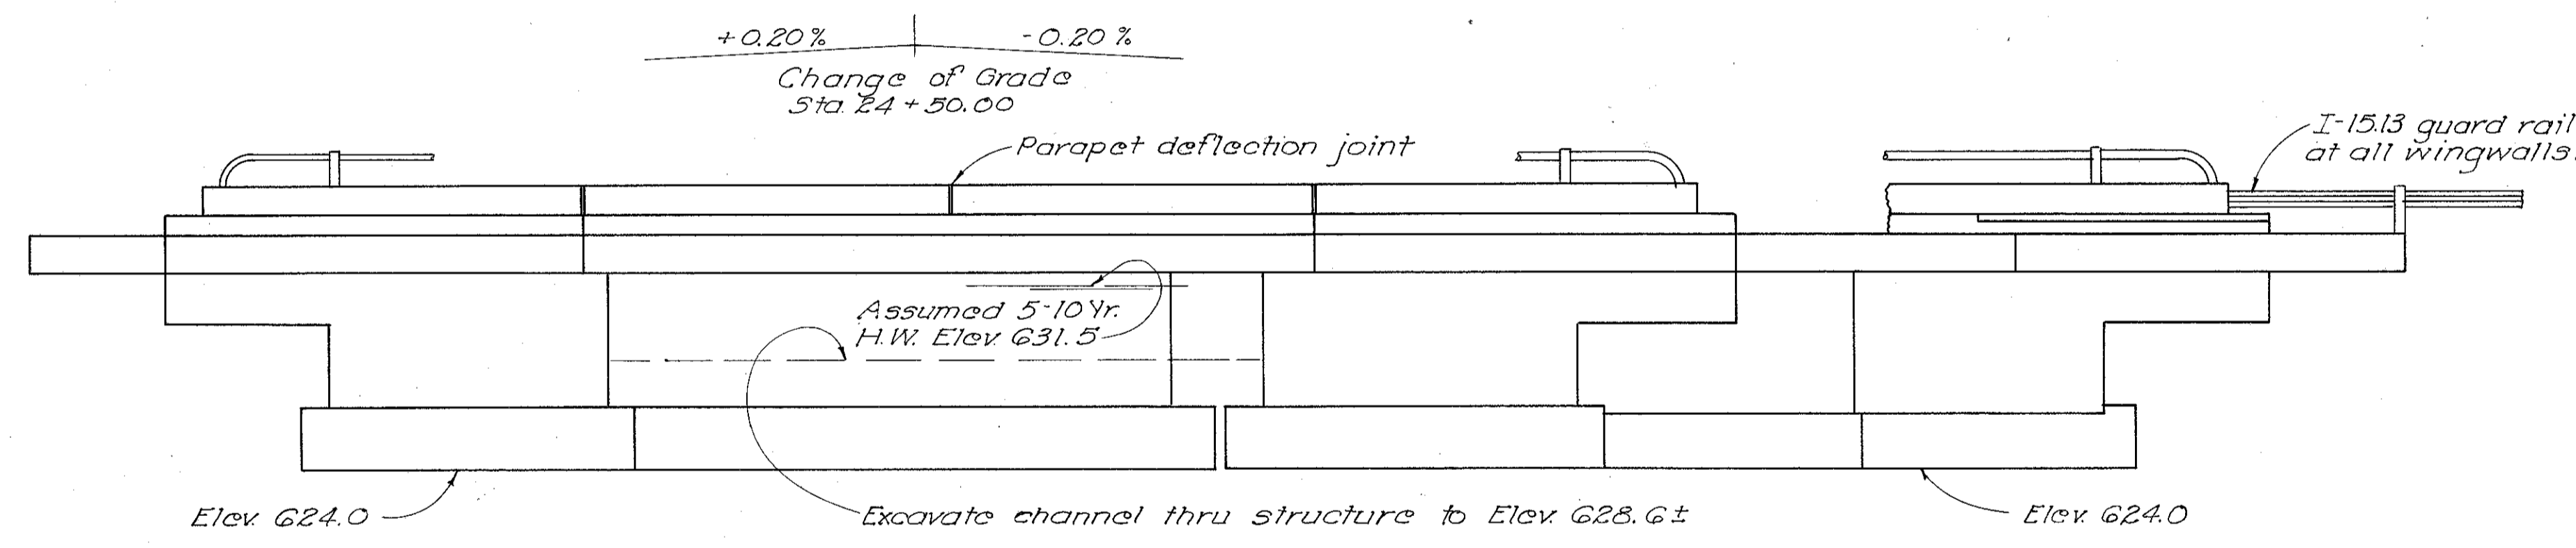

ELEVATION

SUPERSTRUCTURE					Bending Diagrams		ABUTMENTS						
Mark	No.	Length	Weight	Shp.			Mark	No.	Length	Weight	Shp.	R	F
5901	76	31'-0"	8010	B			AG01	94	4'-6"	635	B	47	47
5901	65	39'-7"	3865	S			AG02	4	12'-0"	72	S	2	2
5501	18	28'-6"	535	S			AG03	4	21'-5"	129	S	2	2
5502	58	6'-10"	413	B			A501	32	19'-0"	634	S	16	16
5503	58	3'-9"	227	B			A502	19	4'-9"	94	S	9	10
5504	32	4'-3"	142	B			A503	14	5'-3"	77	S	7	7
RAILING							A504	19	5'-0"	99	S	10	9
R501	16	14'-2"	*	S			A505	14	5'-6"	80	S	7	7
R502	16	14'-11"	*	S			A506	32	3'-5"	114	S	16	16
REPLACEMENT BARS							A507	31	7'-7"	245	S	15	16
RE901	1	6'-10"	-	S			A508	4	19'-0"	79	B	2	2
RE901	1	5'-11"	-	S			A509	4	18'-1"	75	B	2	2
RE501	1	5'-7"	-	S			A510	4	12'-6"	52	B	2	2
REPLACEMENT BARS:							A511	4	11'-7"	48	B	2	2
If reinforcing bars are fabricated from stock which has previously been tested and approved by the Ohio Highway Testing Laboratory, test samples as provided in Sec. 5-4.02 need not be furnished and replacement bars will not be required.							A512	32	4'-3"	142	B	16	16
							A513	12	16'-5"	205	S	6	6
							A514	2	17'-6"	37	S	-	2
							A515	4	17'-10"	74	B	3	1
							A516	2	13'-3"	28	S	1	1
							A517	36	6'-1"	228	B	18	18
							A518	6	5'-10"	37	B	3	3
							A519	6	5'-8"	35	B	3	3
							A520	6	5'-4"	33	B	3	3
							A521	6	4'-11"	31	B	3	3
							A522	6	4'-4"	27	B	3	3
							A523	6	3'-10"	24	B	3	3
							A524	24	5'-9"	144	B	12	12
							A525	4	6'-8"	28	B	2	2
							A526	8	6'-5"	54	B	4	4
							A527	4	6'-4"	26	B	2	2
							A528	31	7'-0"	226	S	16	15
							A529	4	15'-6"	65	B	1	3
							A530	4	20'-7"	86	B	2	2
							A531	4	17'-4"	72	S	2	2
							A532	4	14'-1"	59	B	2	2
							A533	4	10'-10"	45	S	2	2
							A534	2	15'-1"	31	S	2	-

GENERAL NOTES

DESIGN SPECIFICATIONS: This structure conforms to the requirements of "Design Specifications for Highway Structures" of the State of Ohio, Department of Highways, dated 9-1-57, together with current revisions thereof.

ABUTMENT FOOTINGS: shall extend a minimum of 3" into solid shale or to the elevation shown, whichever is lower.

FOUNDATION BEARING PRESSURE: Abutment footings are designed for a maximum bearing pressure of 2½ tons per sq. ft.

CAMBER of ½" at ¼ of the span shall be provided to allow for dead load deflection. This is the amount of camber required before falsework is released. To obtain this, proper allowance shall be made for the deflection of falsework members.

CURBS shall be placed after the shoring under the slab has been released sufficiently to permit the span to attain full dead load deflection.

ESTIMATED QUANTITIES						
Item	Total	Unit	Description	Super.	Abuts.	Gen'l. As Built
E-2	Lump	Sum	Cofferdams, cribs and sheeting			Lump
E-2	175	CuYd.	Unclassified excavation, including shale		175	
E-3	250	CuYd.	Channel excavation		250	60-11-151 99
S-1	61	CuYd.	Class "C" concrete, superstructure	61		
S-1	61	CuYd.	Class "E" concrete, abutment walls		61	
S-1	41	CuYd.	Class "E" concrete, abutment footings		41	
S-3	12	Lin.Ft.	Waterproofing, premolded sealing strip		12	
S-4	17,362	Lb.	Reinforcing steel	13,192	4,170	
S-14	119.04	Lin.Ft.	Railing (aluminum rail and supports and concrete parapet)	58.04	61.00	
S-29	24	CuYd.	Porous backfill		24	
S-29	3	each	Scuppers (4" dia. cast iron or wrought iron pipe)	3		

STATE OF OHIO
DEPARTMENT OF HIGHWAYS
DIVISION OF DESIGN AND CONSTRUCTION
BUREAU OF BRIDGES

GENERAL PLAN, ELEVATION, NOTES, ESTIMATED QUANTITIES & REINFORCING STEEL LIST
BRIDGE No. LAK-2-MARGINAL ROAD
LAKE COUNTY STA. 24+48.49
LAKE COUNTY STA. 24+77.51

DESIGNED	DGM	DRAWN	DGM	TRACED	R.H.D.	CHECKED	R.L.D.	REVIEWED	BFG	DATE	3-4-59	REVISED	
----------	-----	-------	-----	--------	--------	---------	--------	----------	-----	------	--------	---------	--