




SEE THIS SHEET
MATCH LINE STA 8+860

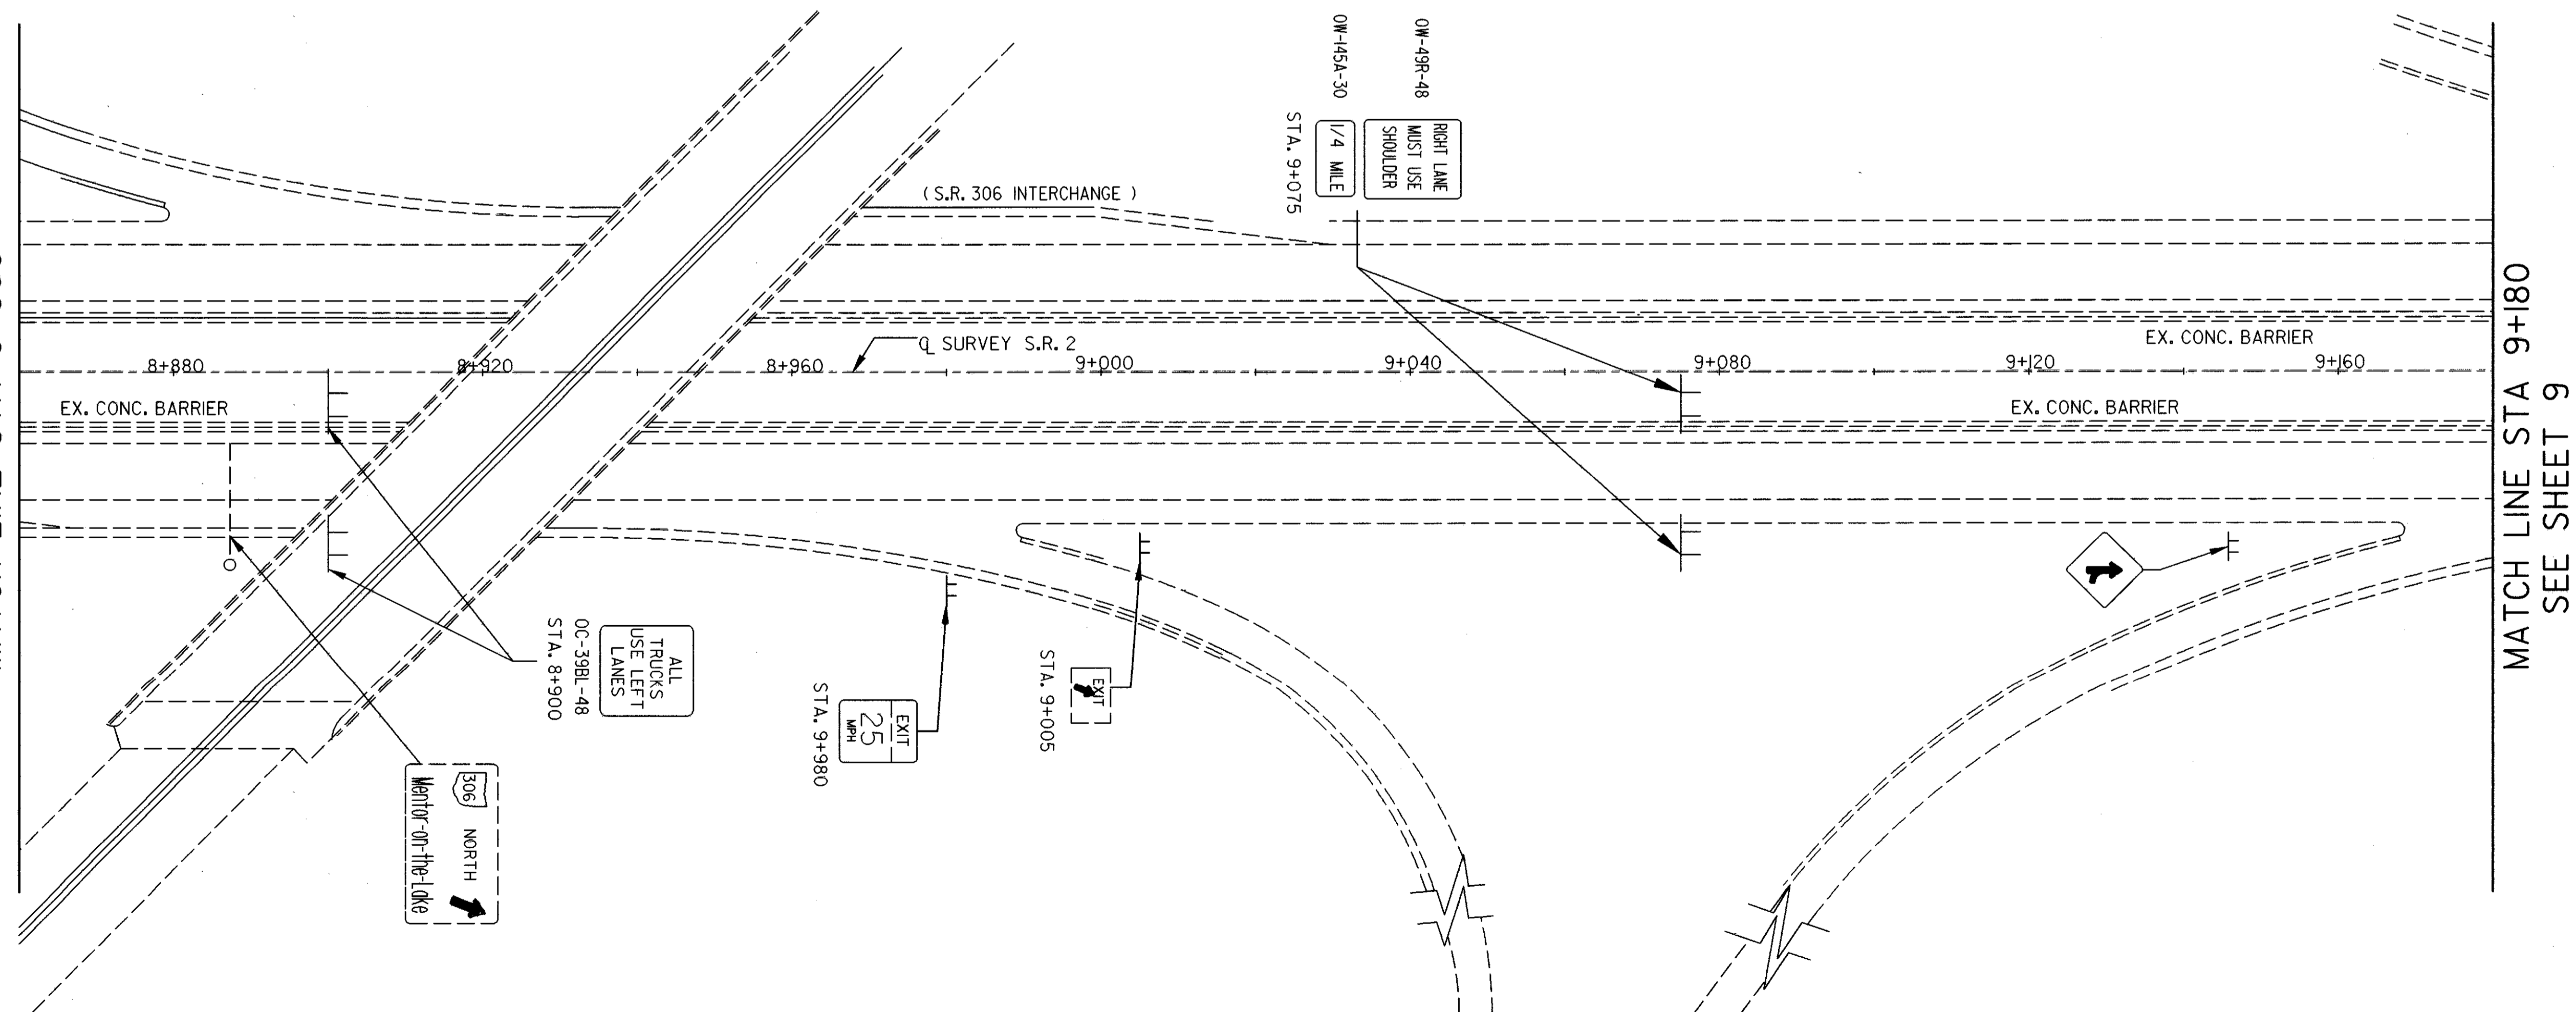

MATCH LINE SEE SHEET

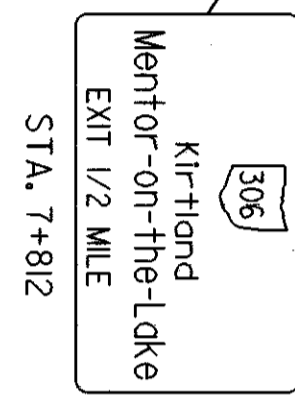


1 MILE
OW-45A-30
STA. 7+870

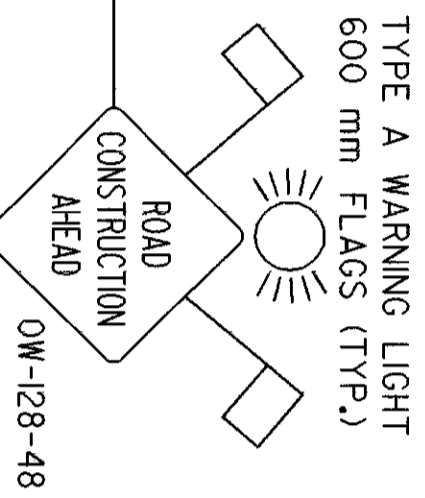

OW-128-48

1/2 MILE
OW-45A-30
STA. 8+775

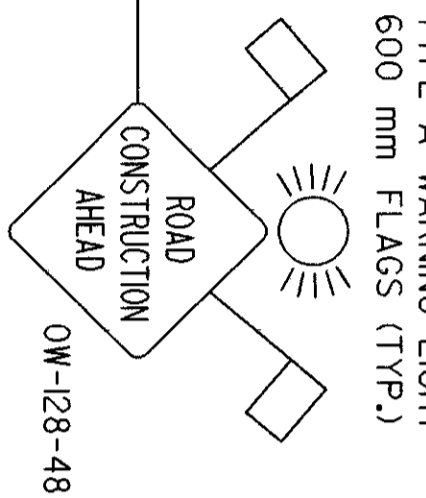

OW-128-48

MATCH LINE STA 8+860
SEE THIS SHEET

MATCH LINE STA 9+180
SEE SHEET 9

AS-BUILT DRAWINGS 11/97