


SEE SHEET 15
 MATCH LINE STA 9+880


SEE THIS SHEET
 MATCH LINE STA 10+220

MATCH LINE STA 10+220
 SEE THIS SHEET

MATCH LINE STA 10+560
 SEE SHEET 17

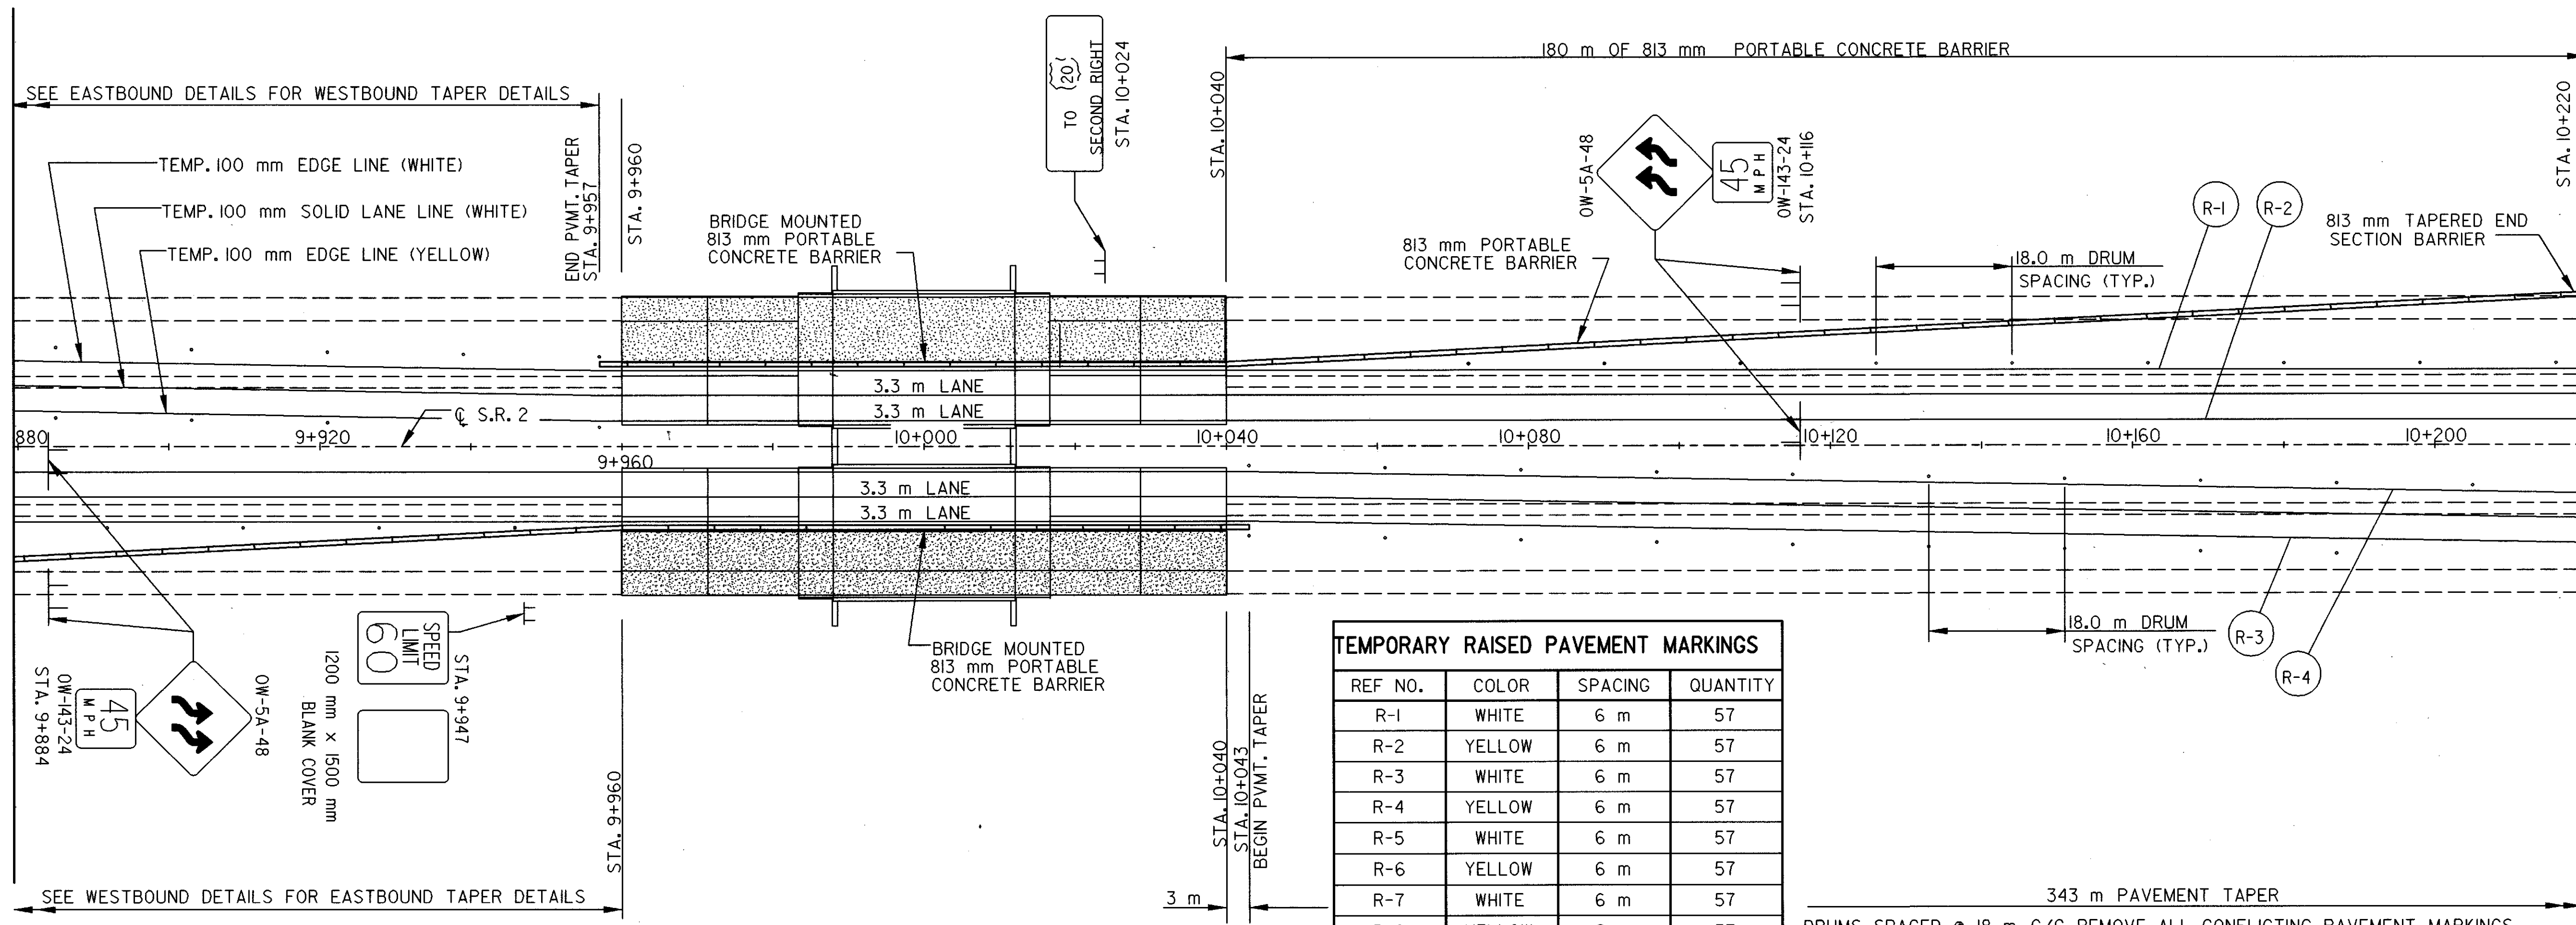

TEMPORARY RAISED PAVEMENT MARKINGS			
REF NO.	COLOR	SPACING	QUANTITY
R-1	WHITE	6 m	57
R-2	YELLOW	6 m	57
R-3	WHITE	6 m	57
R-4	YELLOW	6 m	57
R-5	WHITE	6 m	57
R-6	YELLOW	6 m	57
R-7	WHITE	6 m	57
R-8	YELLOW	6 m	57

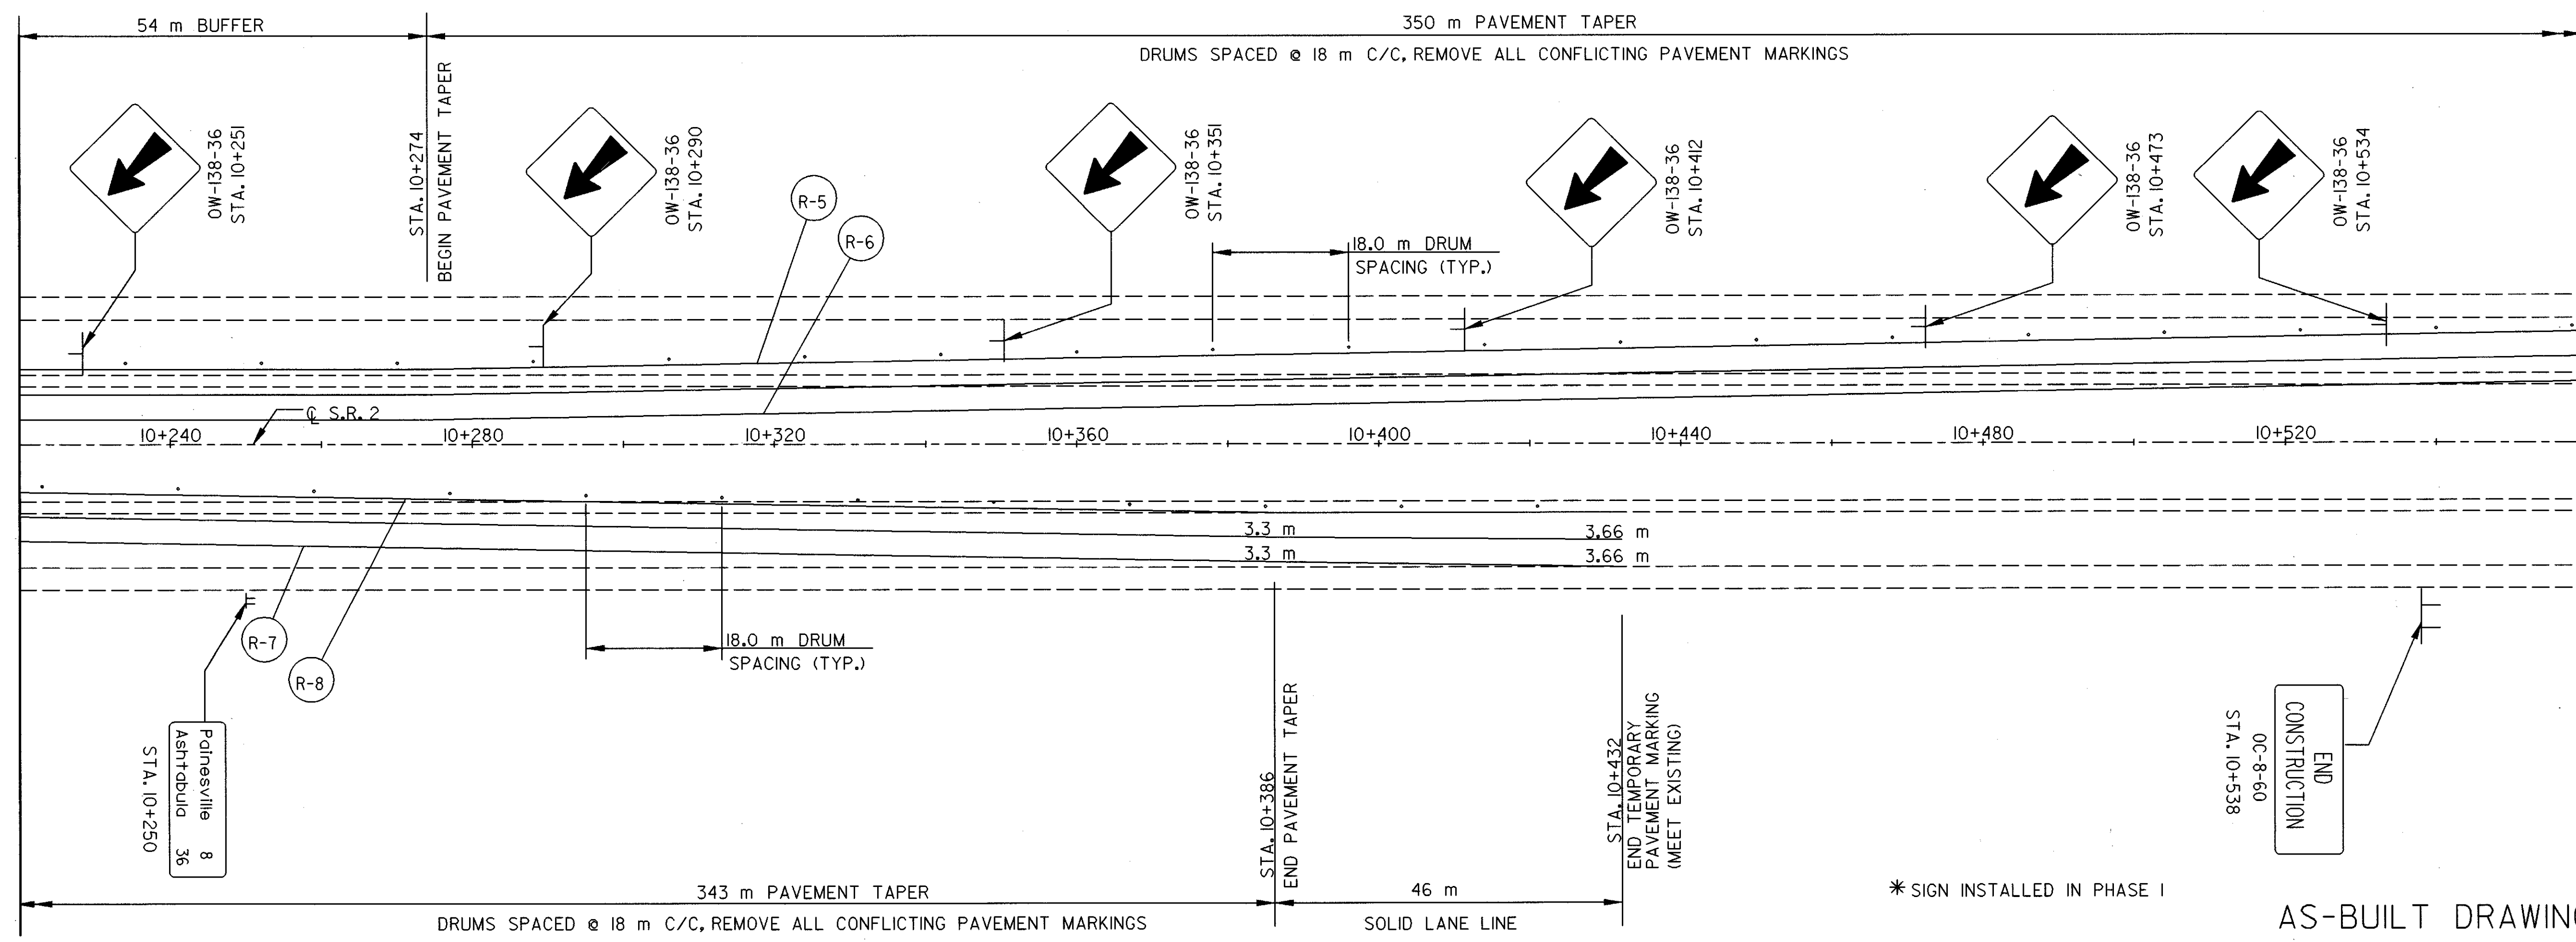

I:\DWG\198324\2\AMP.LDCH SHEET NO. 4

* SIGN INSTALLED IN PHASE I

AS-BUILT DRAWINGS 11/97