


SEE THIS SHEET  
MATCH LINE STA II+580

SEE SHEET 17  
MATCH LINE STA II+240

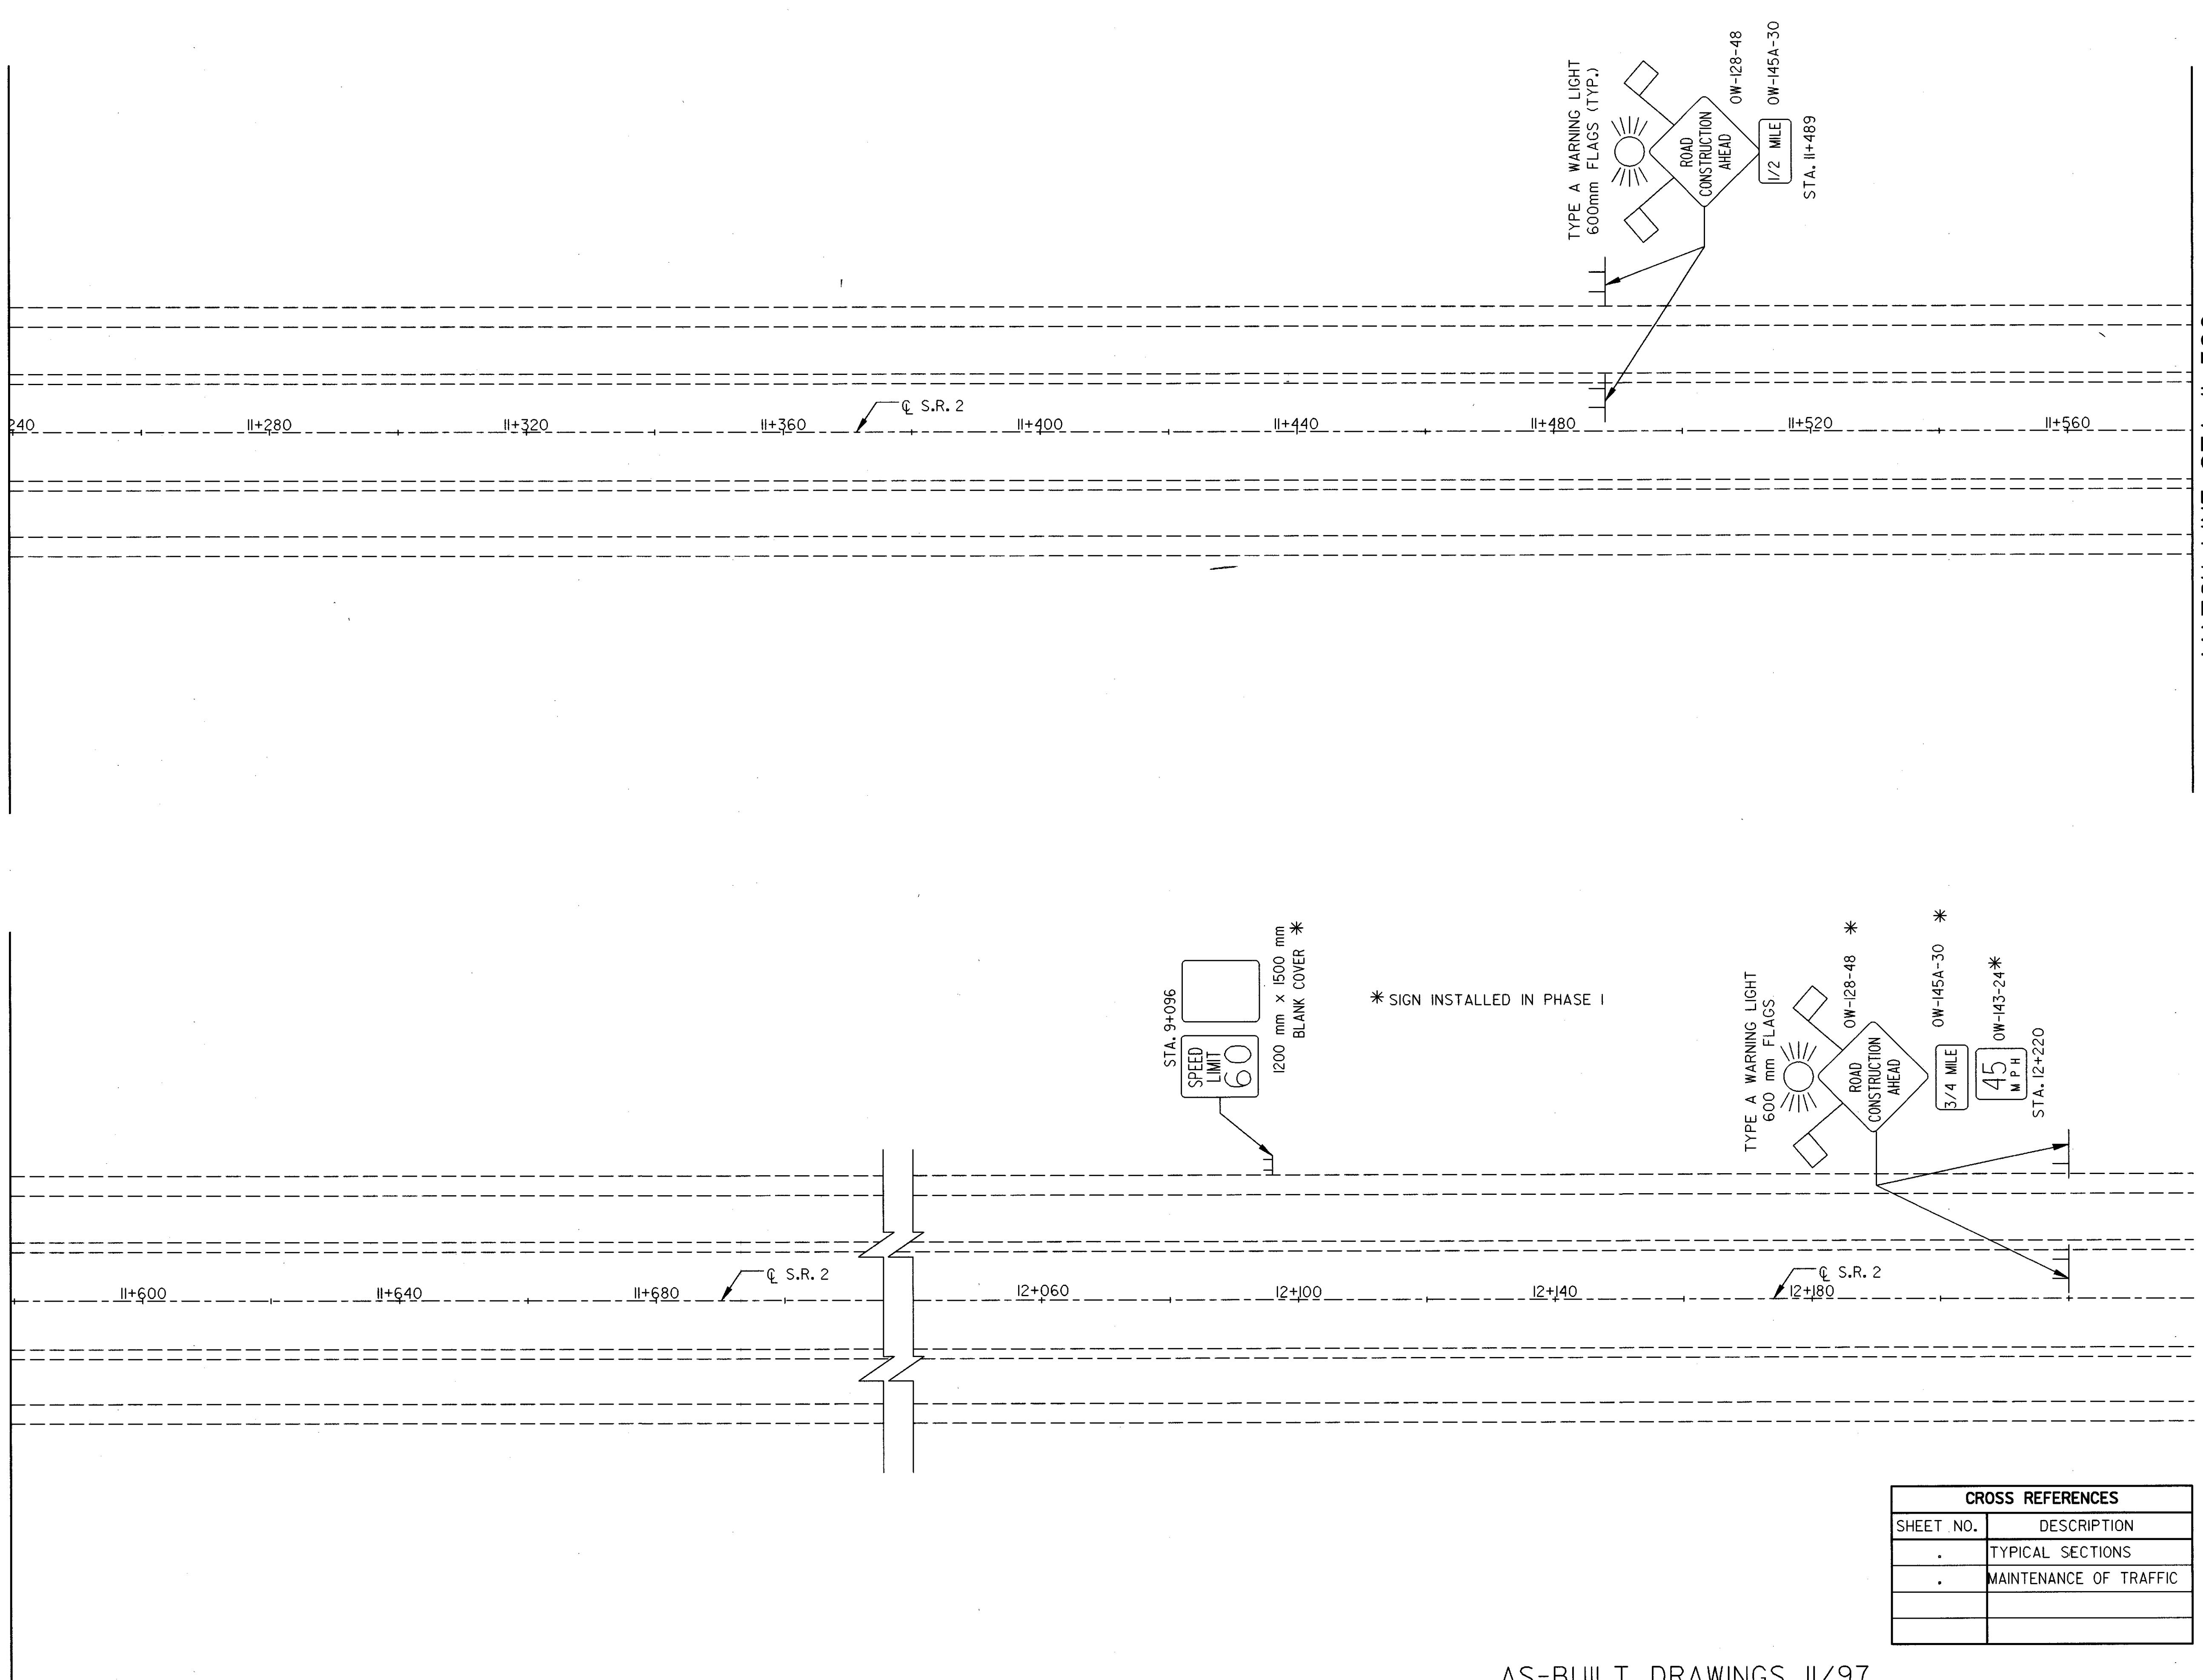

CROSS REFERENCES	
SHEET NO.	DESCRIPTION
.	TYPICAL SECTIONS
.	MAINTENANCE OF TRAFFIC

AS-BUILT DRAWINGS II/97

MATCH LINE STA II+580  
SEE THIS SHEET

CALCULATED  
CHECKED

NORTH

10 0 5 10  
HORIZONTAL  
SCALE IN METERS

MAINTENANCE OF TRAFFIC - PHASE 2  
STA. II+240 TO STA. 12+220

LAK-2-12.231