

Seeding
End Width
Sq. Yds.


2	DMD	F-329 (16)
---	-----	------------

78-R
268

LAKE COUNTY
LAK-2-7.39
REV. 3-17-59

NOTE:
This sheet supersedes
Sheet No. 78

End Sta.	Area		Cu	Yds.
	Cut	Fill		
198	79	1299		
535			52	1141
221	44	1380		
322			26	747
166	51	1310		
169			45	359
215	253	1114		

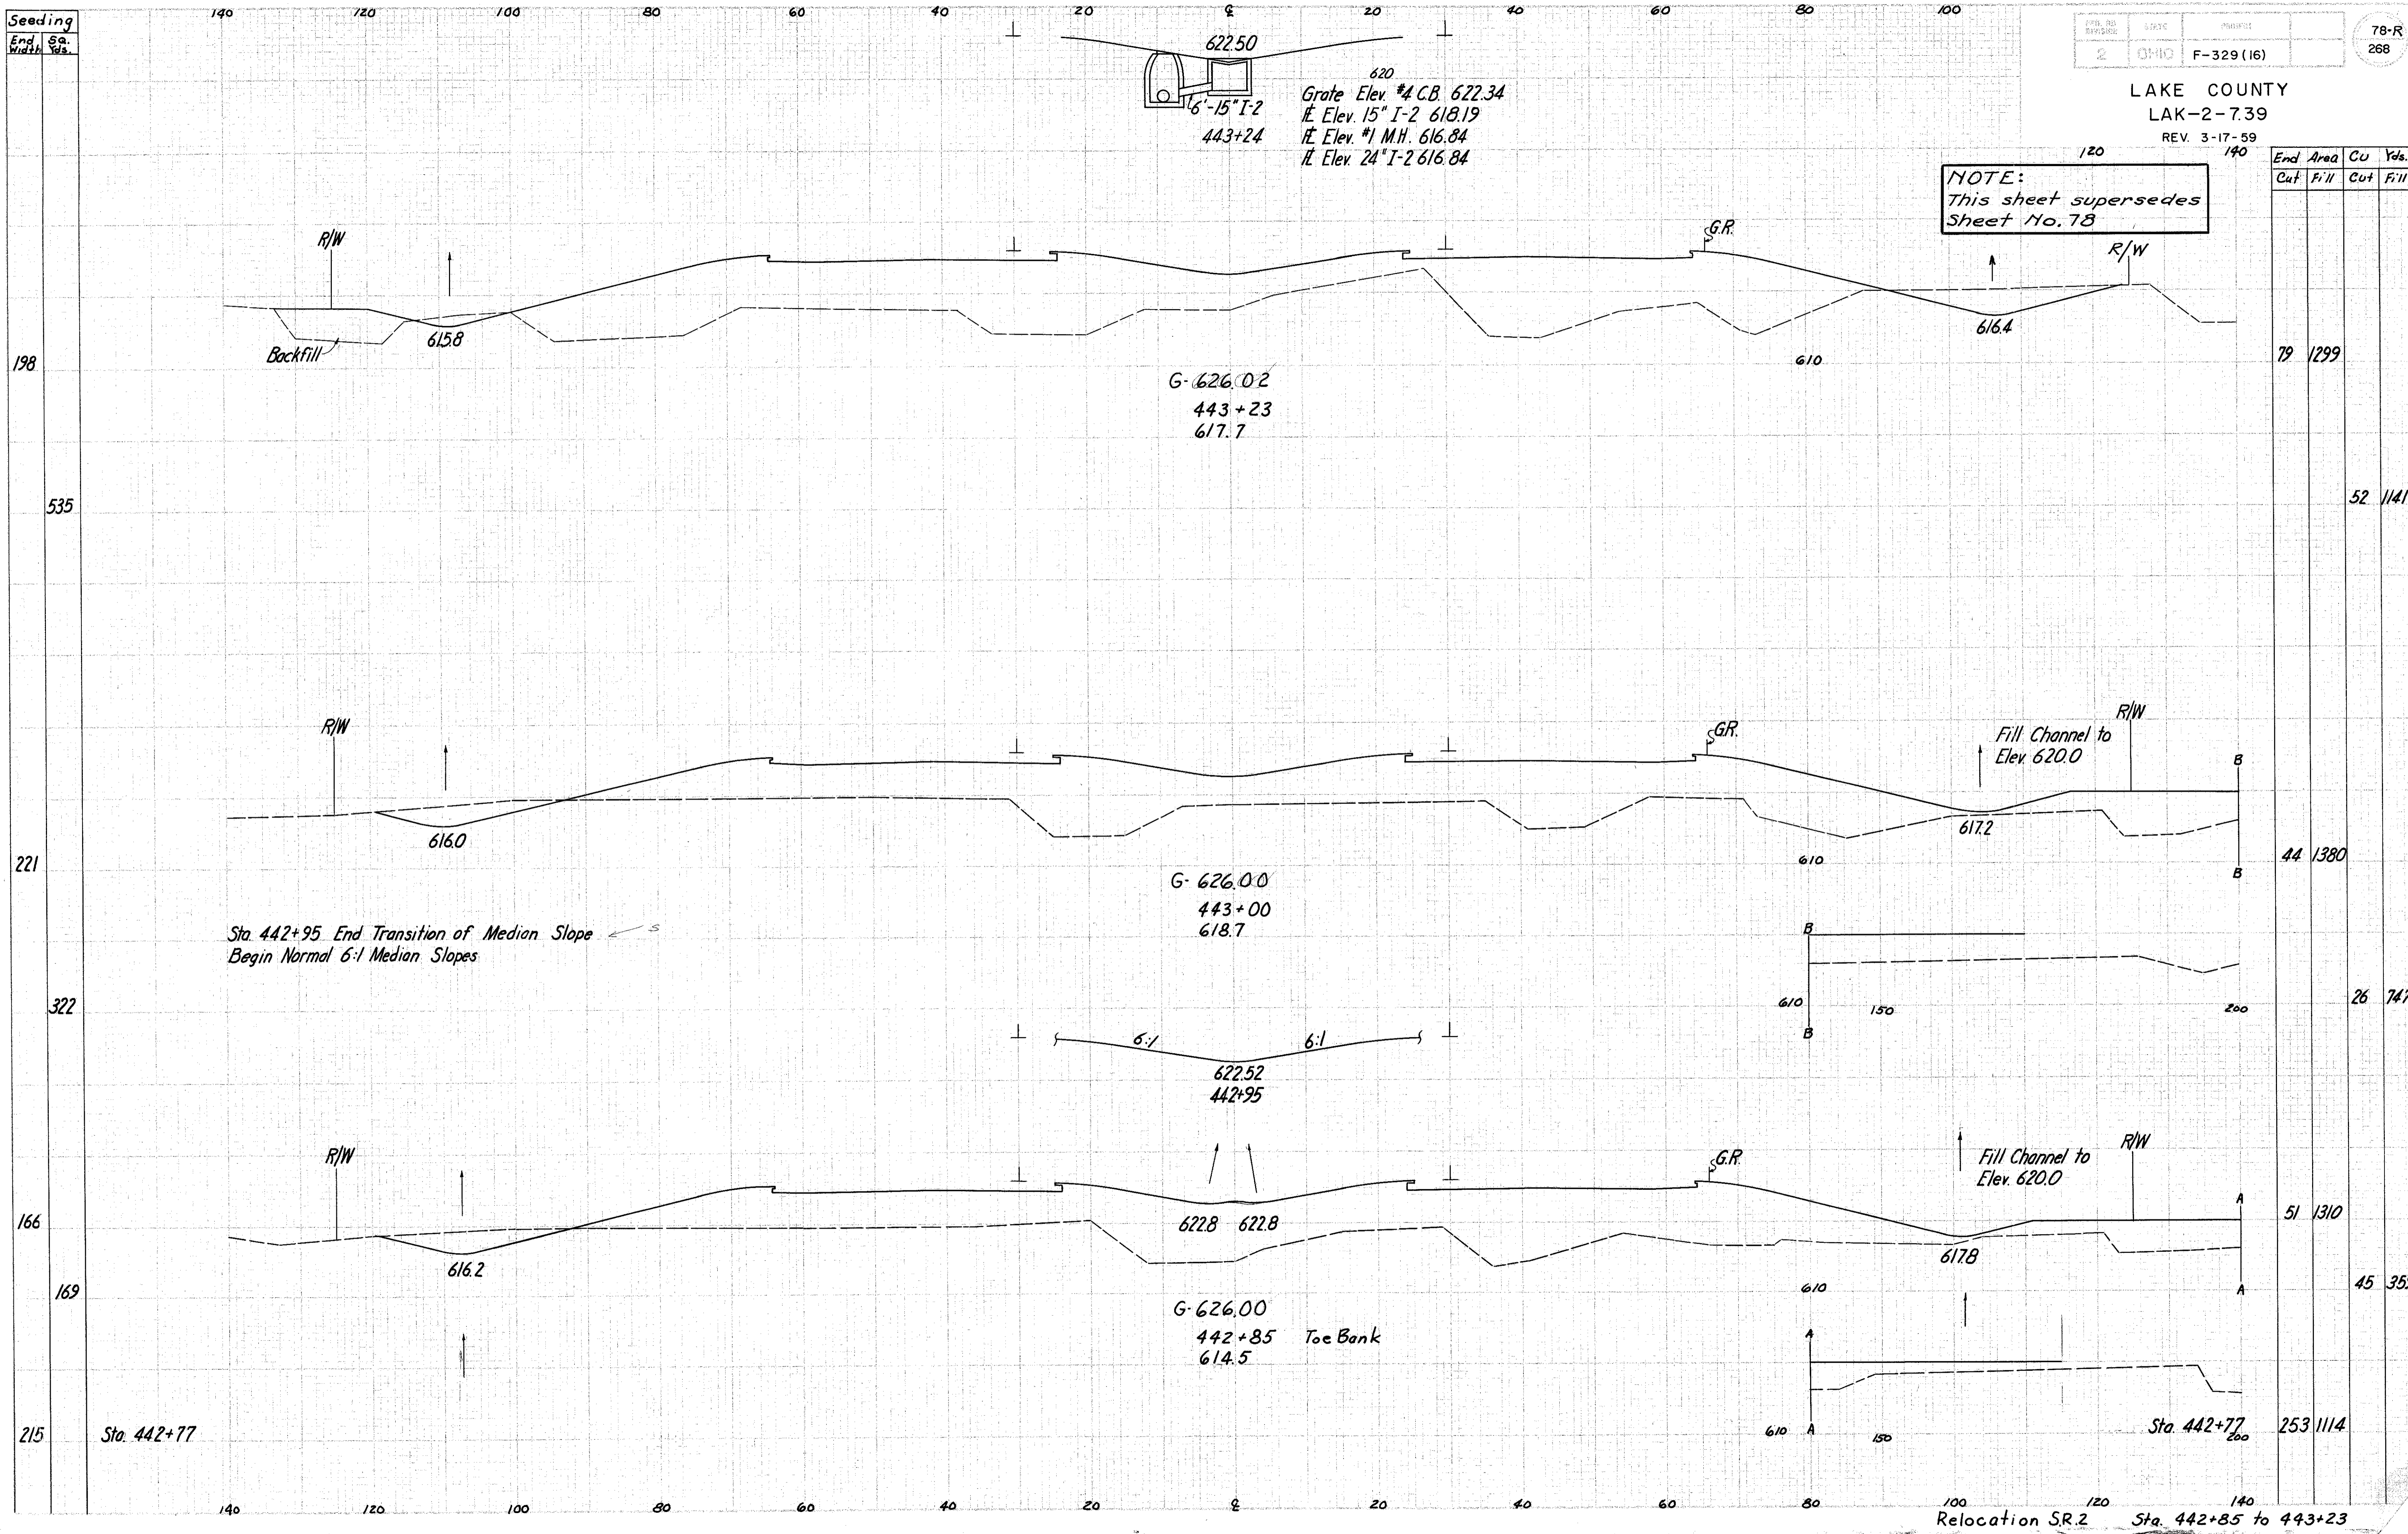

Sta. 442+95 End Transition of Median Slope
Begin Normal 6:1 Median Slopes

620
Grate Elev. #4 C.B. 622.34
Elev. 15" I-2 618.19
Elev. #1 M.H. 616.84
Elev. 24" I-2 616.84

G-626.02
443+23
617.7

G-626.00
443+00
618.7

622.52
442+95

622.8 622.8
G-626.00
442+85
614.5

Toe Bank

Relocation SR.2 Sta. 442+85 to 443+23

Handwritten notes: 2/24/59