



CALC. BY: DATE:	LAKE/ASHTABULA COUNTY LAK/ATB-20-24.89/0.00 R/W ONLY	OHIO F.H.W.A. 5 REGION



**NOTE:**  
 EXISTING RIGHT OF WAY LOCATION AND WIDTH DETERMINED FROM:  
 - PRIOR RIGHT OF WAY PLAN, DATED 1940.  
 - SURVEY BY: WESTERN RESERVE ENGINEERING & SURVEYING CO., 1992

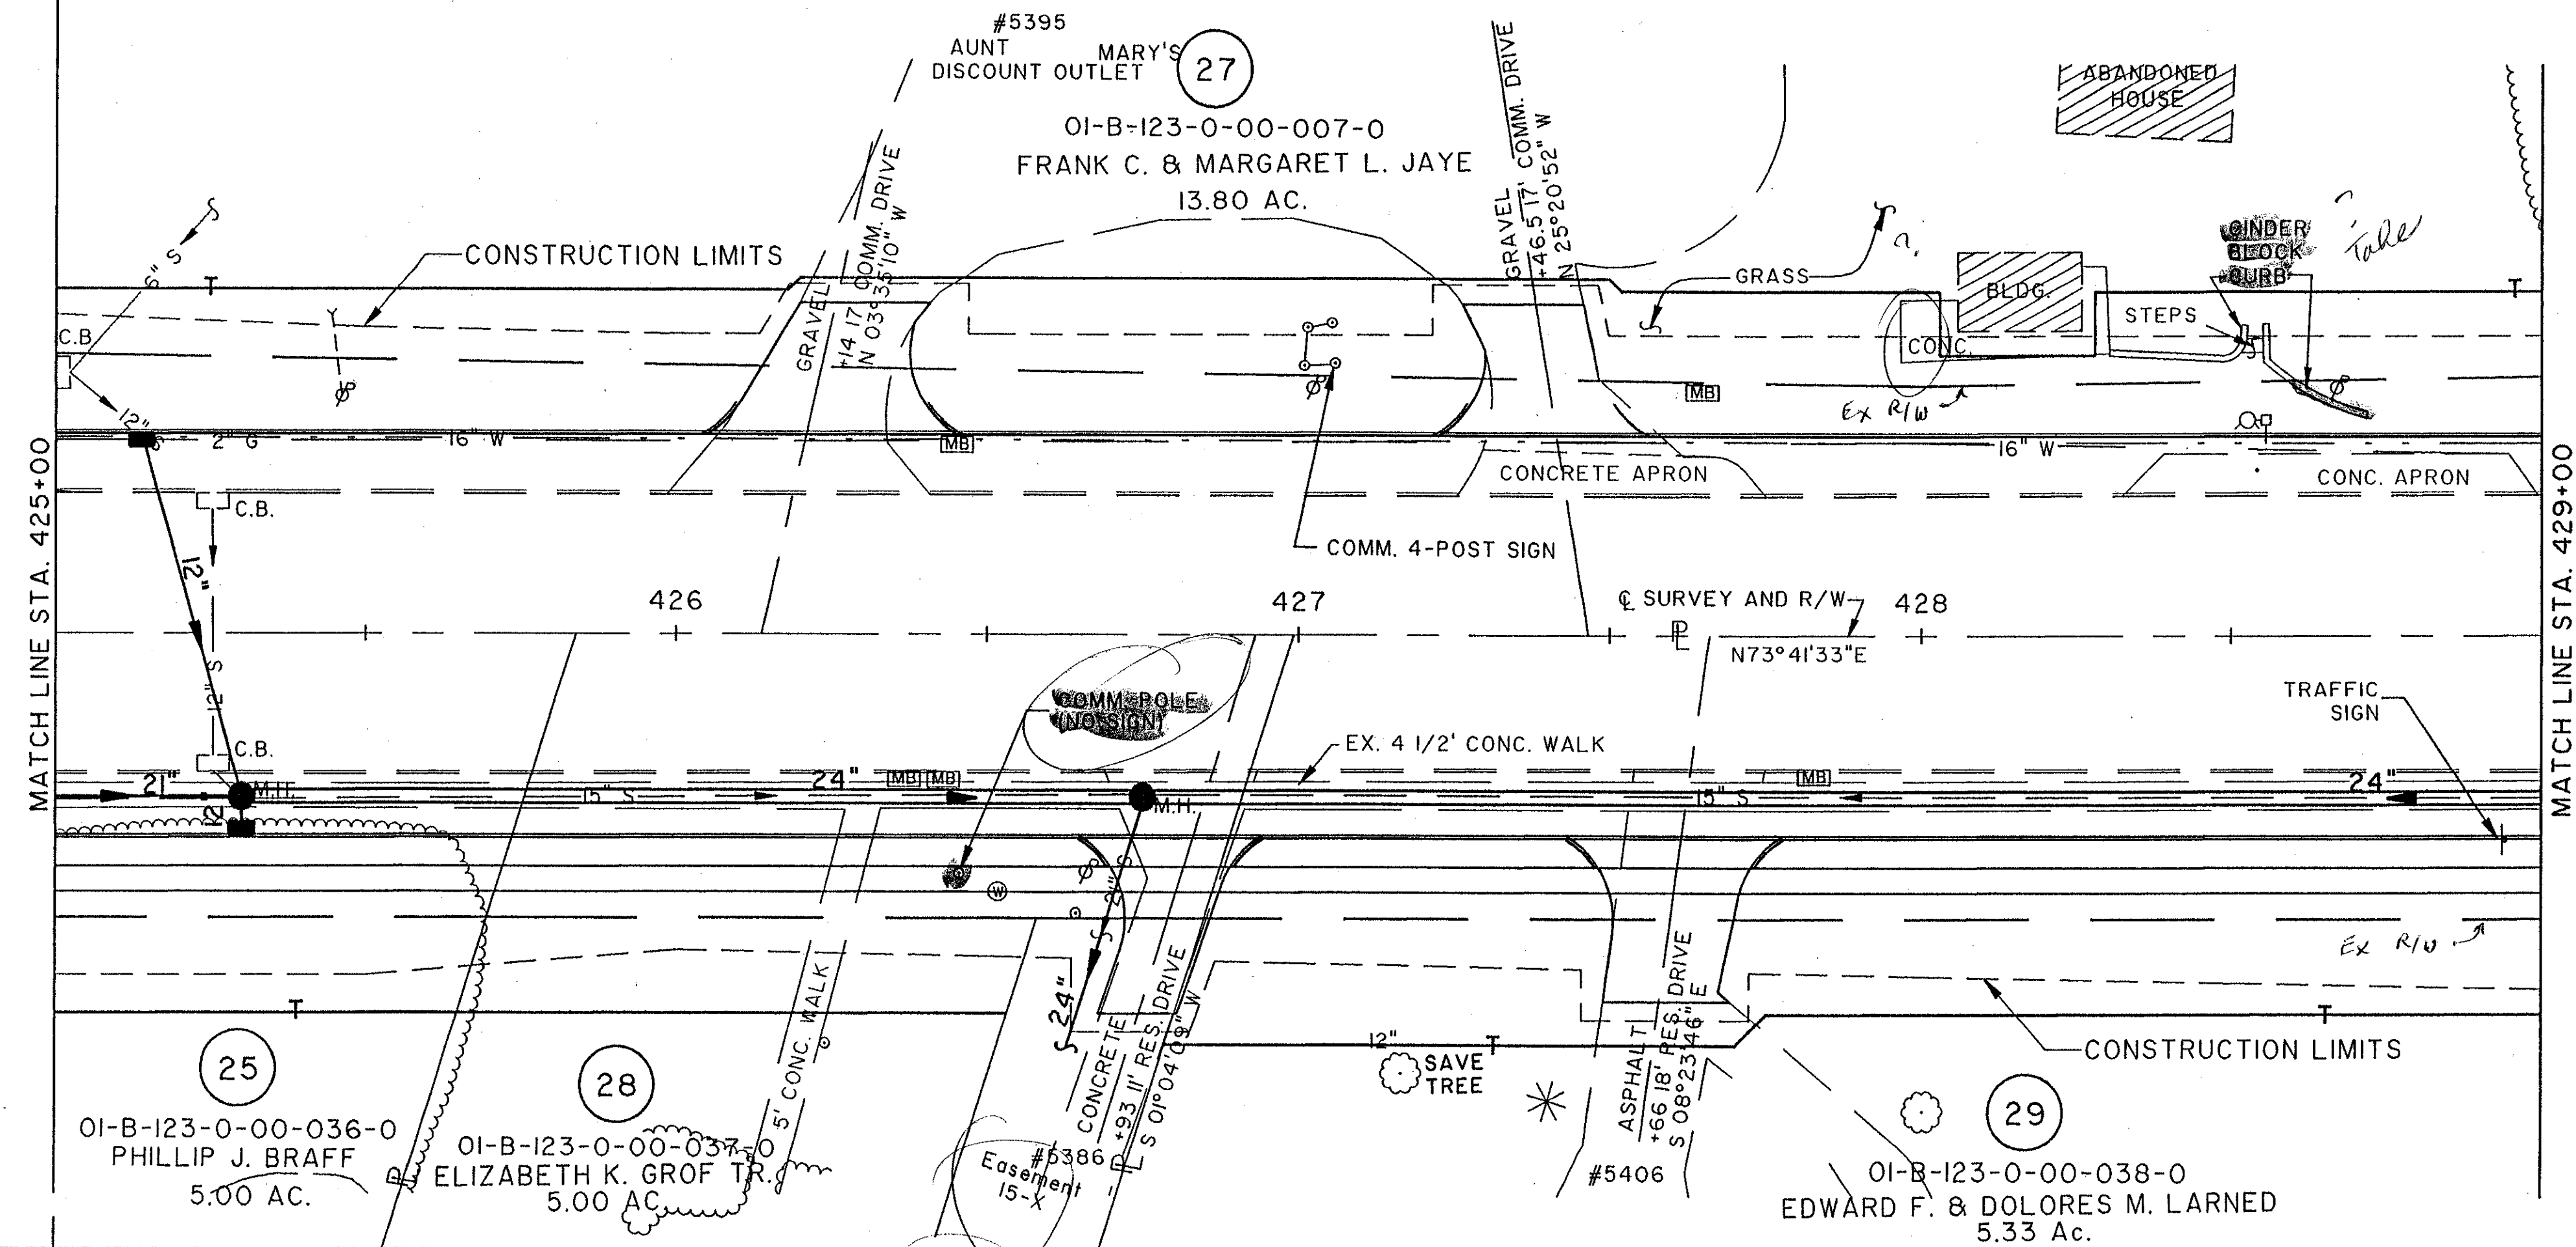

LAKE COUNTY  
 MADISON TOWNSHIP  
 TRACT 4  
 LOT 5

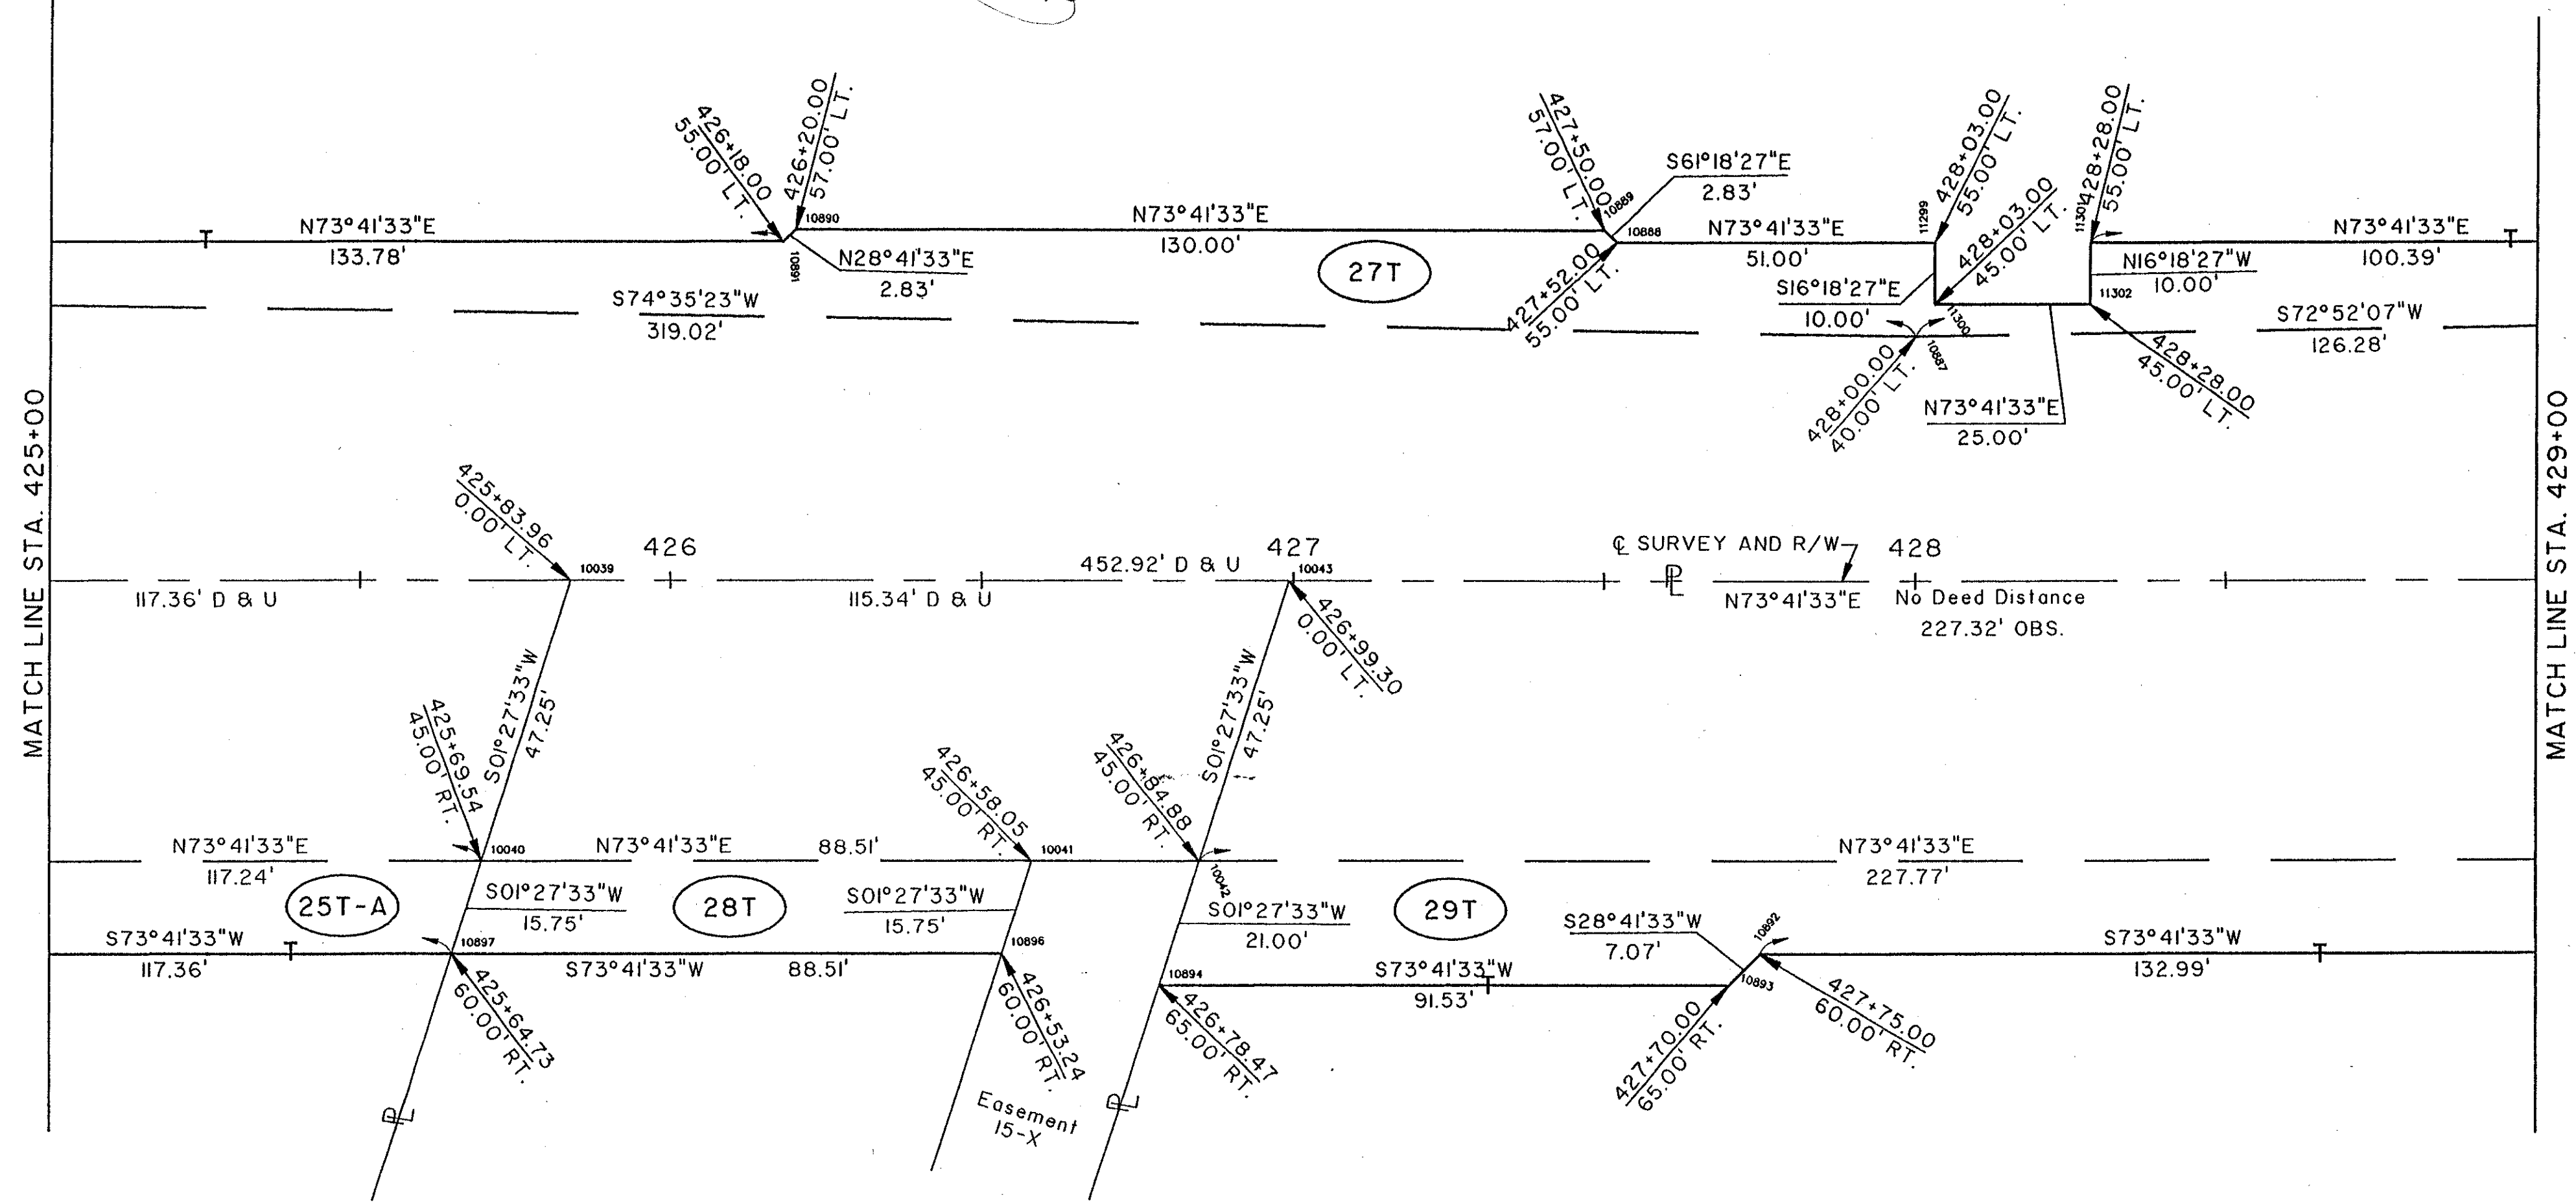

Filename: J:\VOLI\0007\9975\STRUCT\99755863  
 Plot: 2024.dwg, Date: 20/09/99, User: 274 / 02-08-94 (1.5)

REV.	DATE	DESCRIPTION

RIGHT-OF-WAY PLAN U.S. 20 STA. 425+00 TO STA. 429+00