
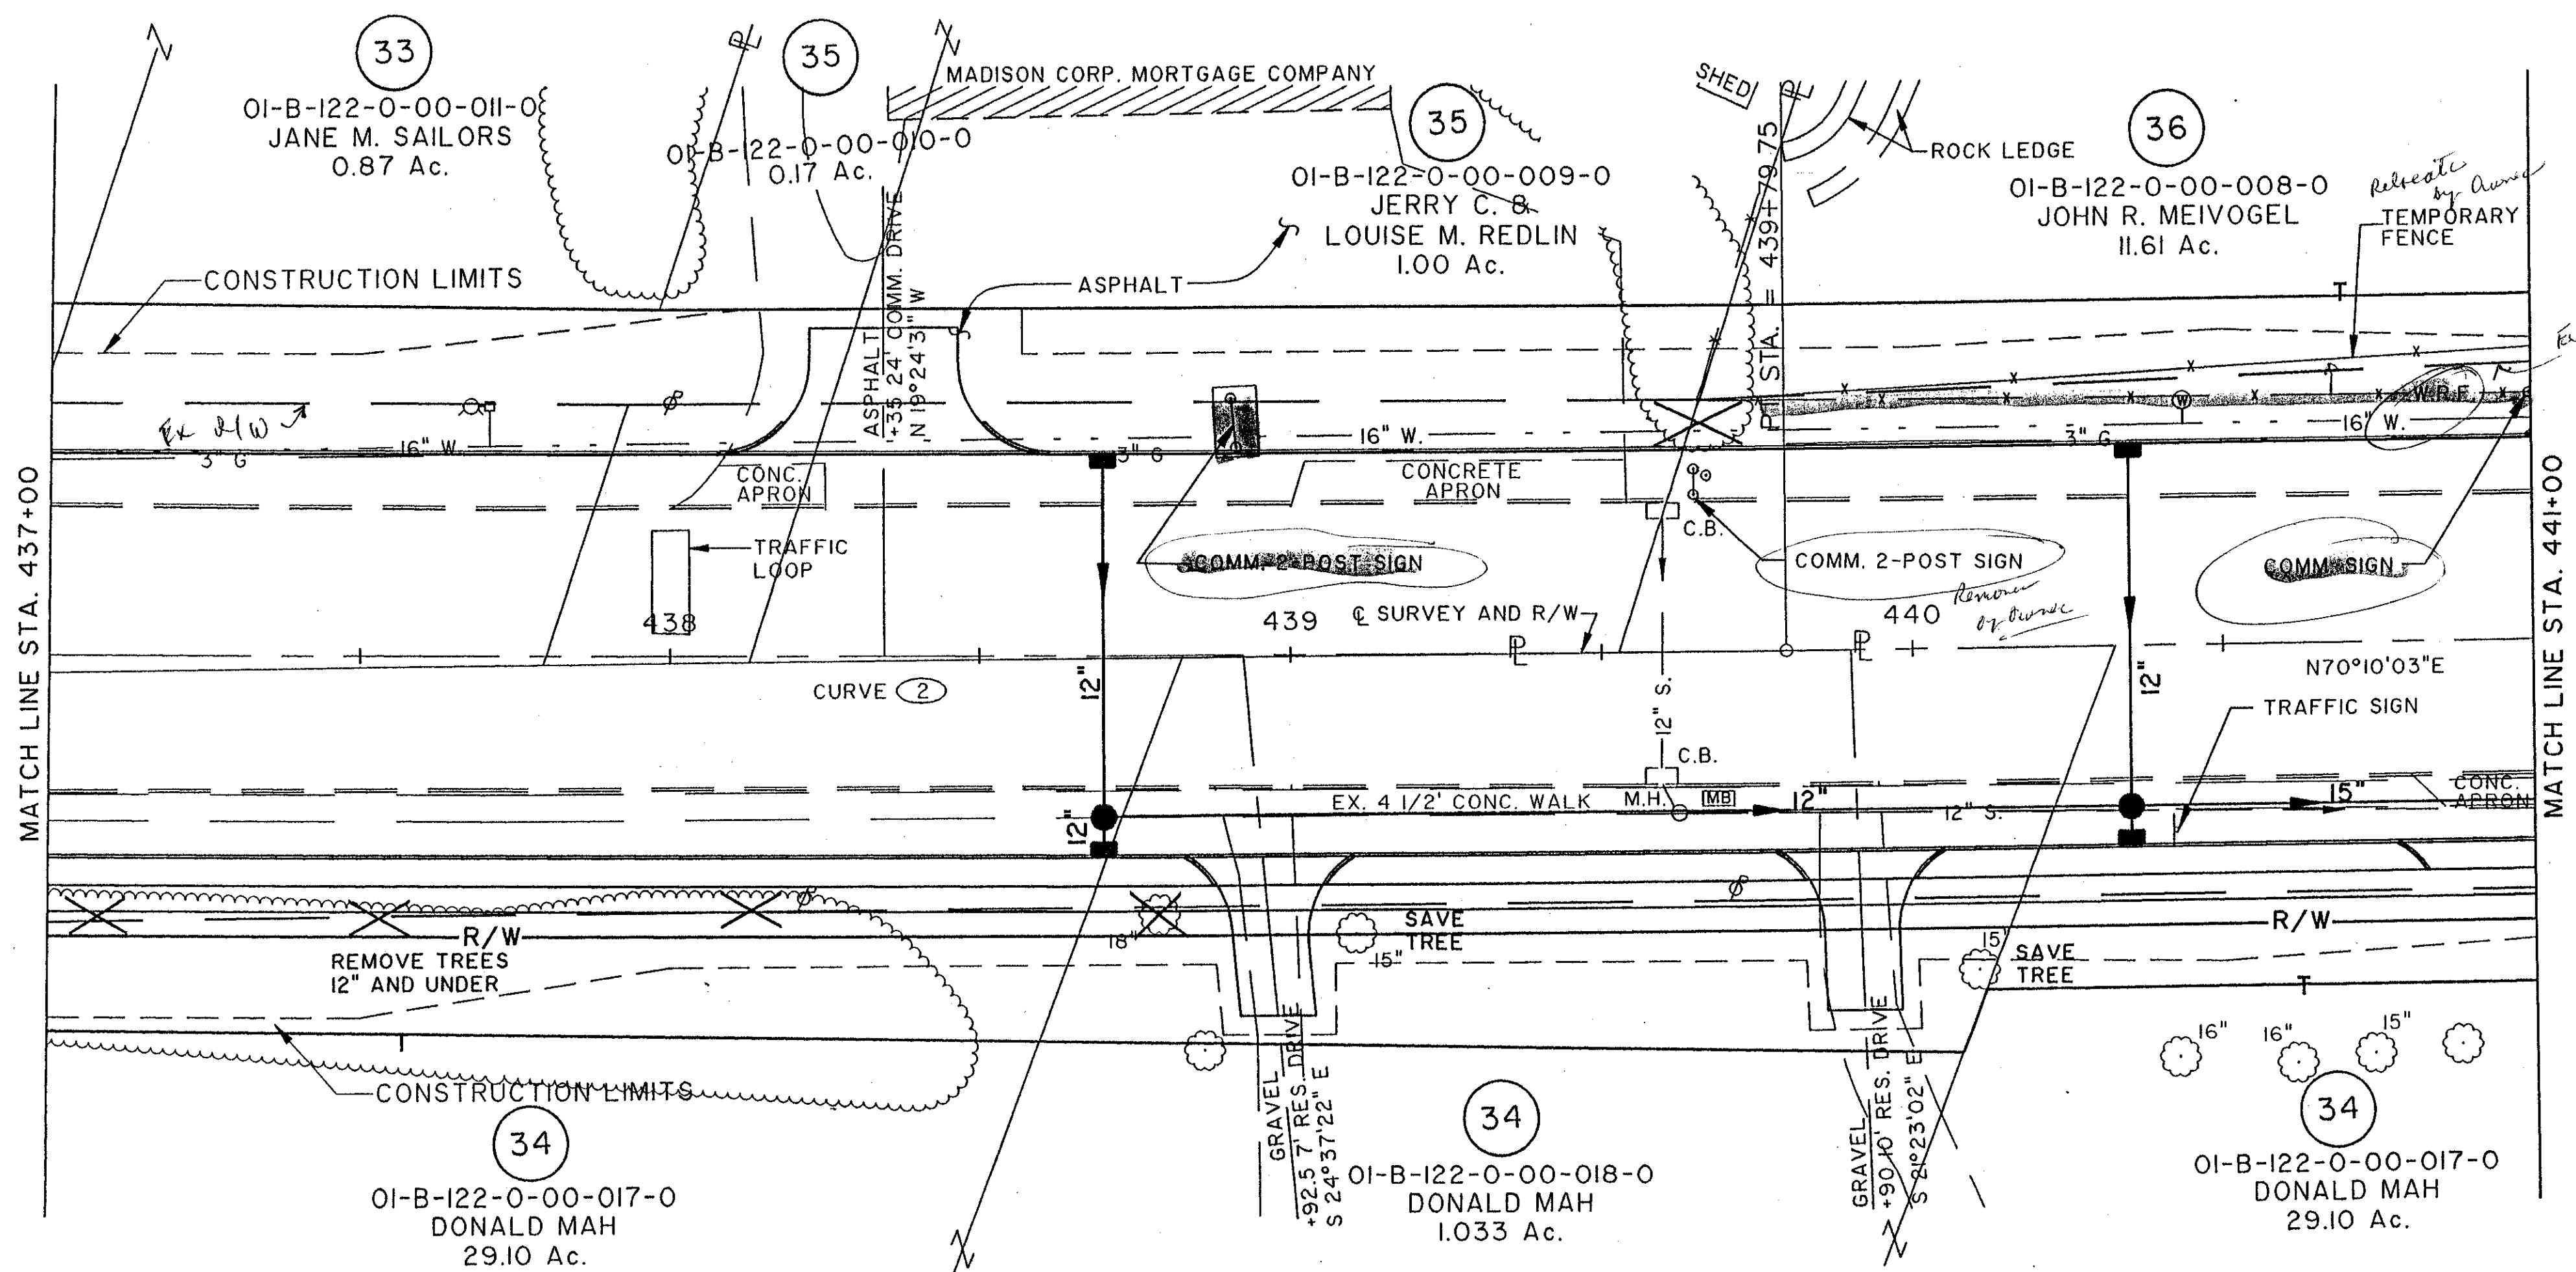



CALC. BY:	LAKE/ASHTABULA COUNTY	OHIO
DATE:	LAK/ATB-20-24.89/0.00	F.H.W.A. 5 REGION
CHK'D BY:	R/W ONLY	
DATE:		
FEDERAL PROJECT	STATE PROJECT	

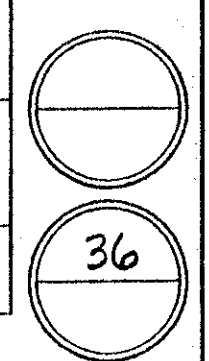

LAKE COUNTY
MADISON TOWNSHIP
TRACT 4
LOT 4

CURVE (2) DATA	
PI STA.	435+63.89
Δ	03°31'30"
R	13523.24'
D	00°25'25"
T	416.12'
L	831.98'
C	831.85'
S	NONE

NOTE:
EXISTING RIGHT OF WAY LOCATION
AND WIDTH DETERMINED FROM:
- PRIOR RIGHT OF WAY PLAN, DATED 1940.
- SURVEY BY: WESTERN RESERVE ENGINEERING
& SURVEYING CO., 1992

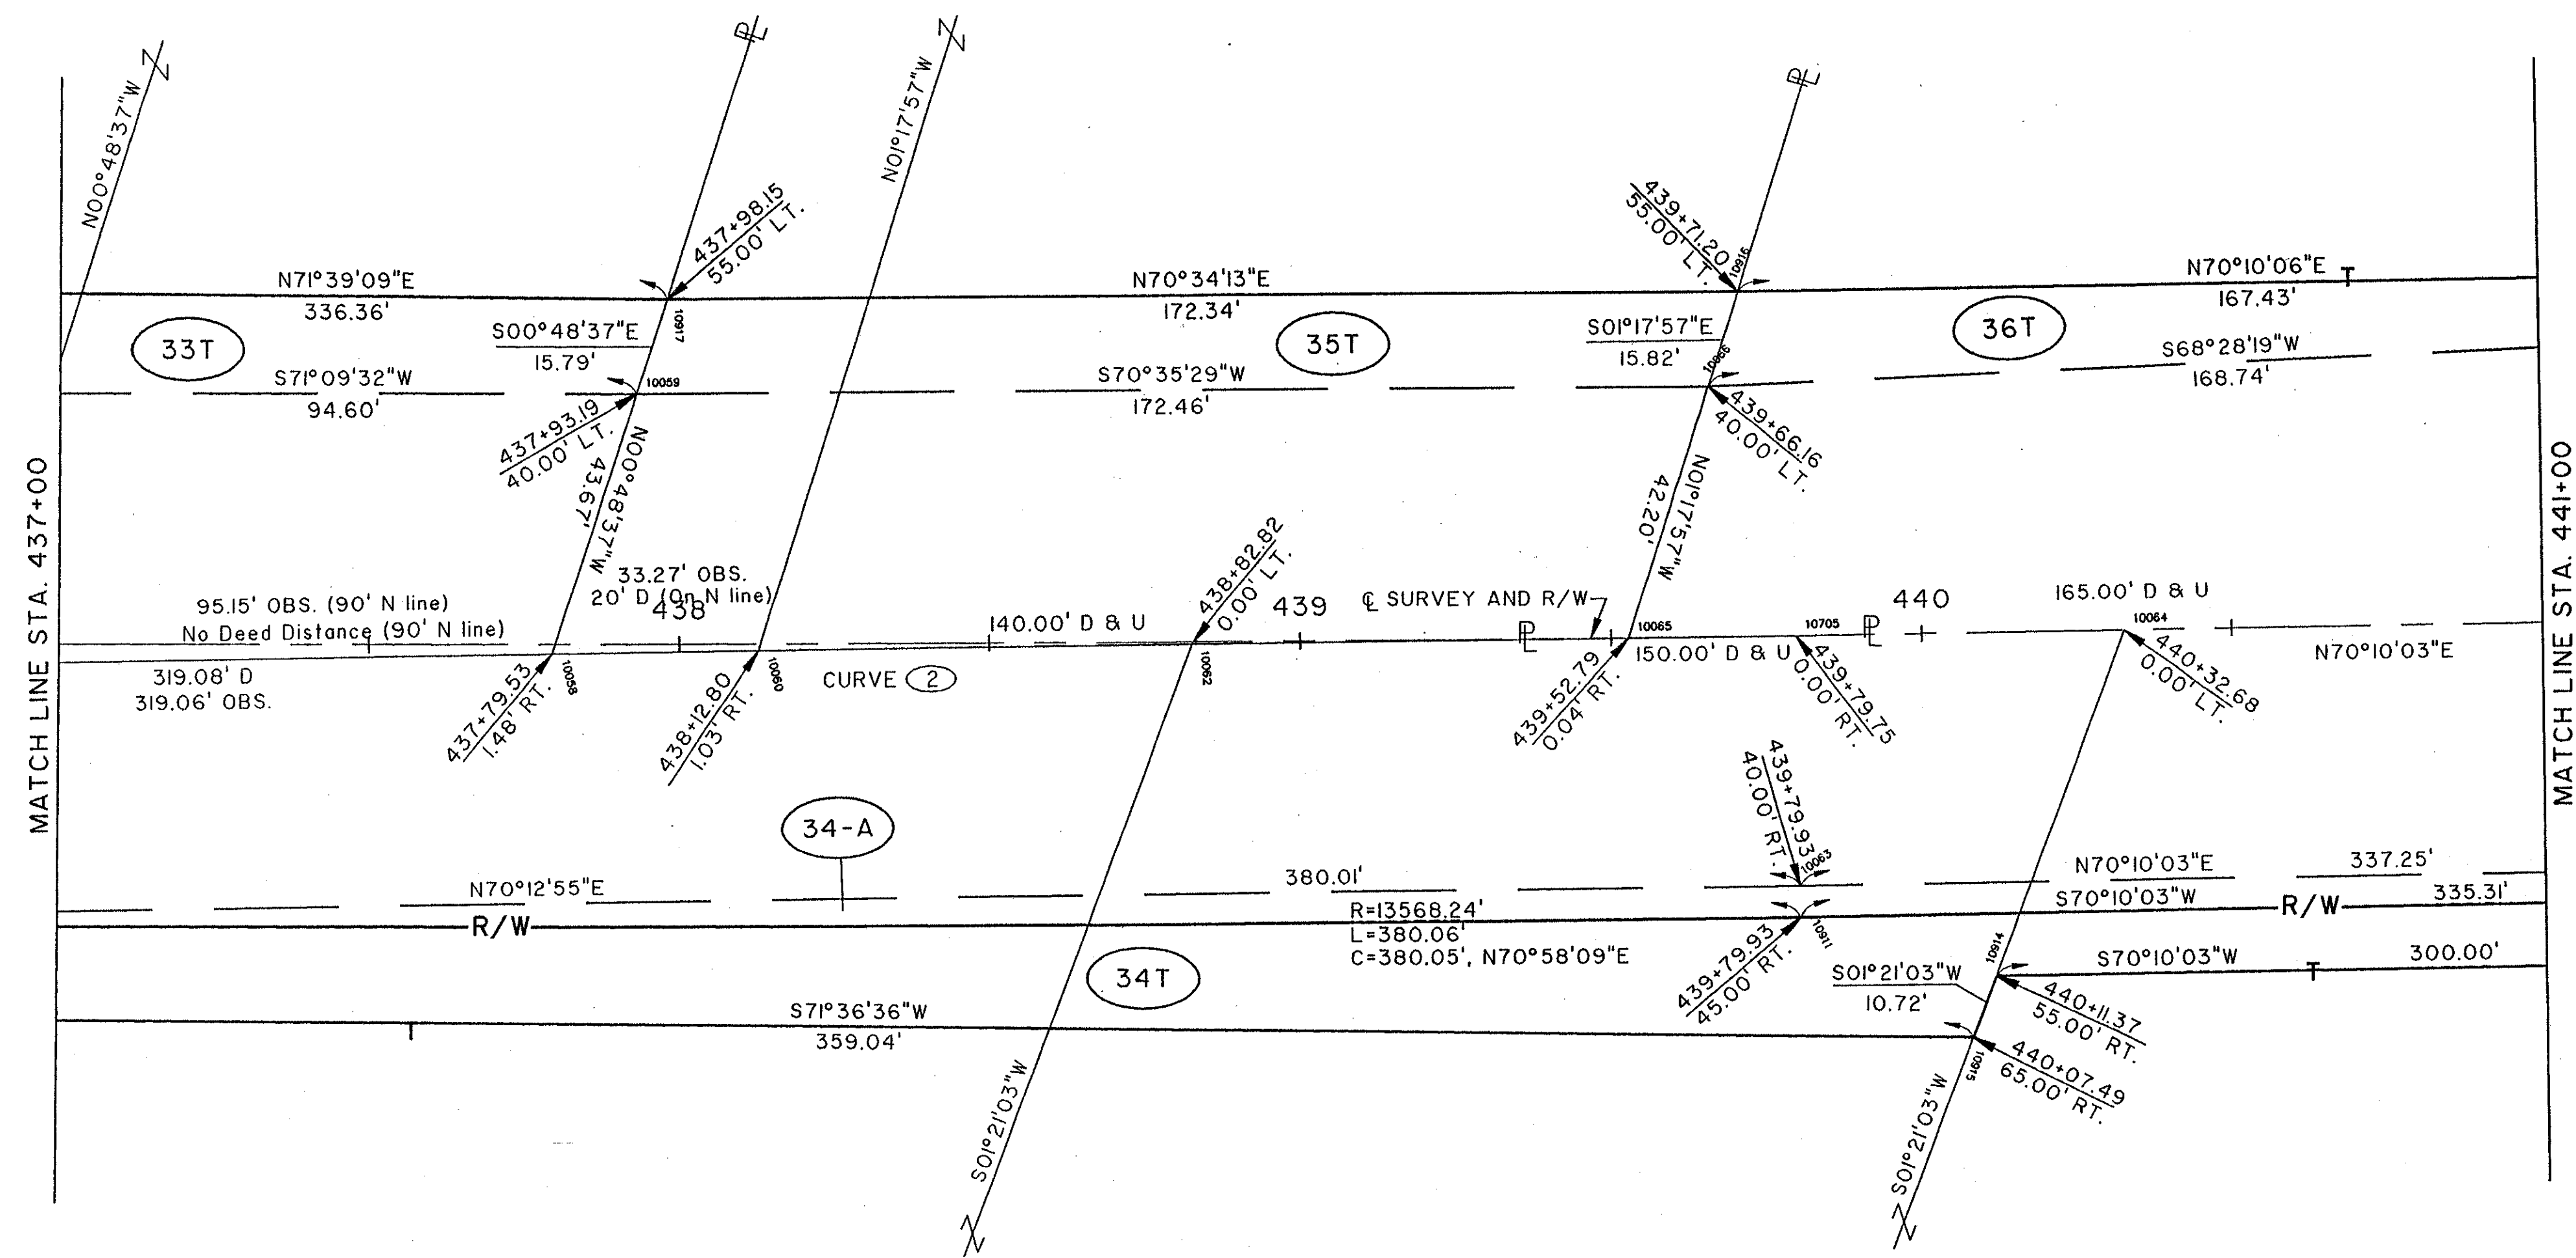

COMPLETION DATE:		
REV.	DATE	DESCRIPTION

File name: K:\M\1\0007\9975\STRUCT\99755686
Plot: 36.dwg / Date: 20 / 02-23-94 (11)