

Parcels 42-WD-1, 42-T-1, 44-WD-1, 44-T-1 acquired after 42-WD, 42-T, 44-WD, 44-T to accommodate revised walk location.




TOWNSHIP 10, RANGE 9  
CONNECTICUT WESTERN RESERVE  
CITY OF MENTOR

FED. RD. DIVISION	STATE	PROJECT
2	OHIO	US-1530(I)

166  
181

LAKE COUNTY  
LAK-615-3.26

13  
28

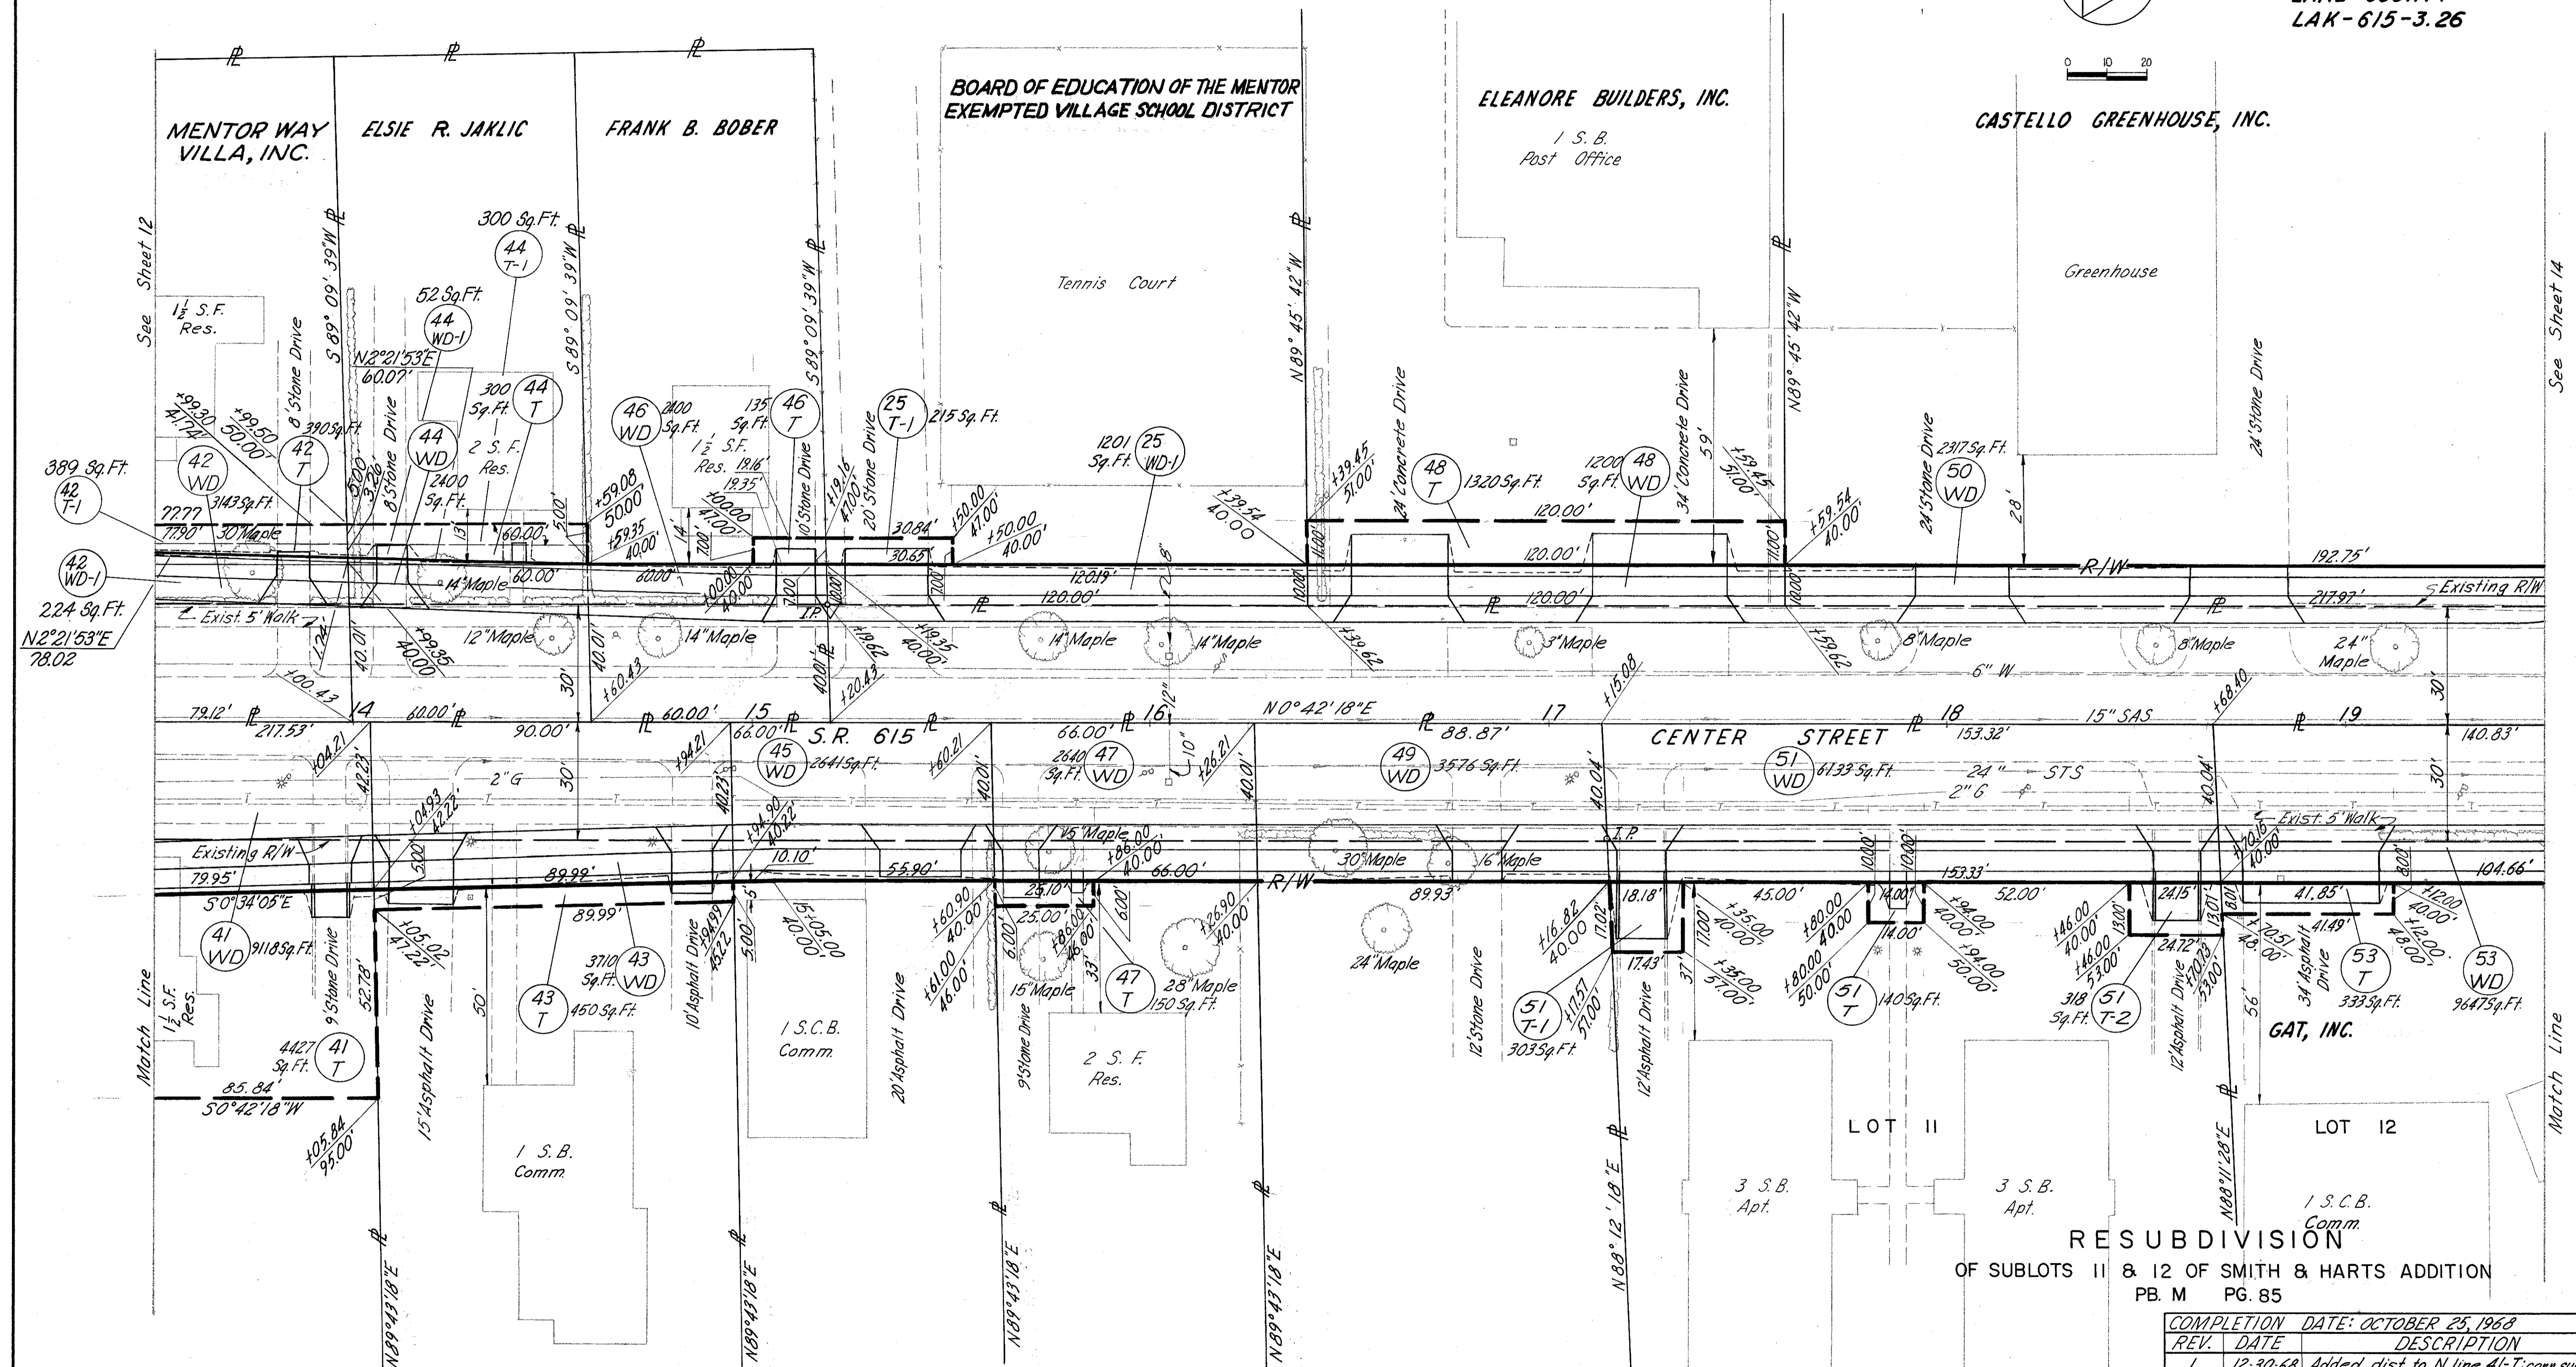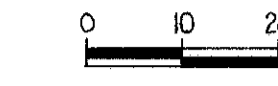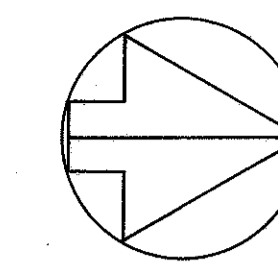

**RESUBDIVISION**  
OF SUBLOTS II & 12 OF SMITH & HARTS ADDITION  
PB. M PG. 85

REV.	DATE	DESCRIPTION
1	12-30-68	Added dist. to N line 41-T; corr. subd. rec. info.
2	3-25-69	Revised owner 42
3	6-23-70	Added 42-WD-1, 42-T-1, 44-WD-1, 44-T-1

IVY G. ROSTOCIL      OHIO WATER SERVICE COMPANY      THOMAS E. OFFI & CECIL G. OFFI      EVALYN HART SPURCK      FRANCIS C. & ALICE J. LUTHER      LORETO & FLORENCE S. IAFELICE

RIGHT OF WAY STA. 13+50 TO 19+50