


FED. RD. DIST. NO.	STATE	PROJECT	FISCAL YEAR
10	OHIO		1940

3
10

Painesville - Warren Rd
S.H. 153 Sec. H & F (Pt)
Lake County

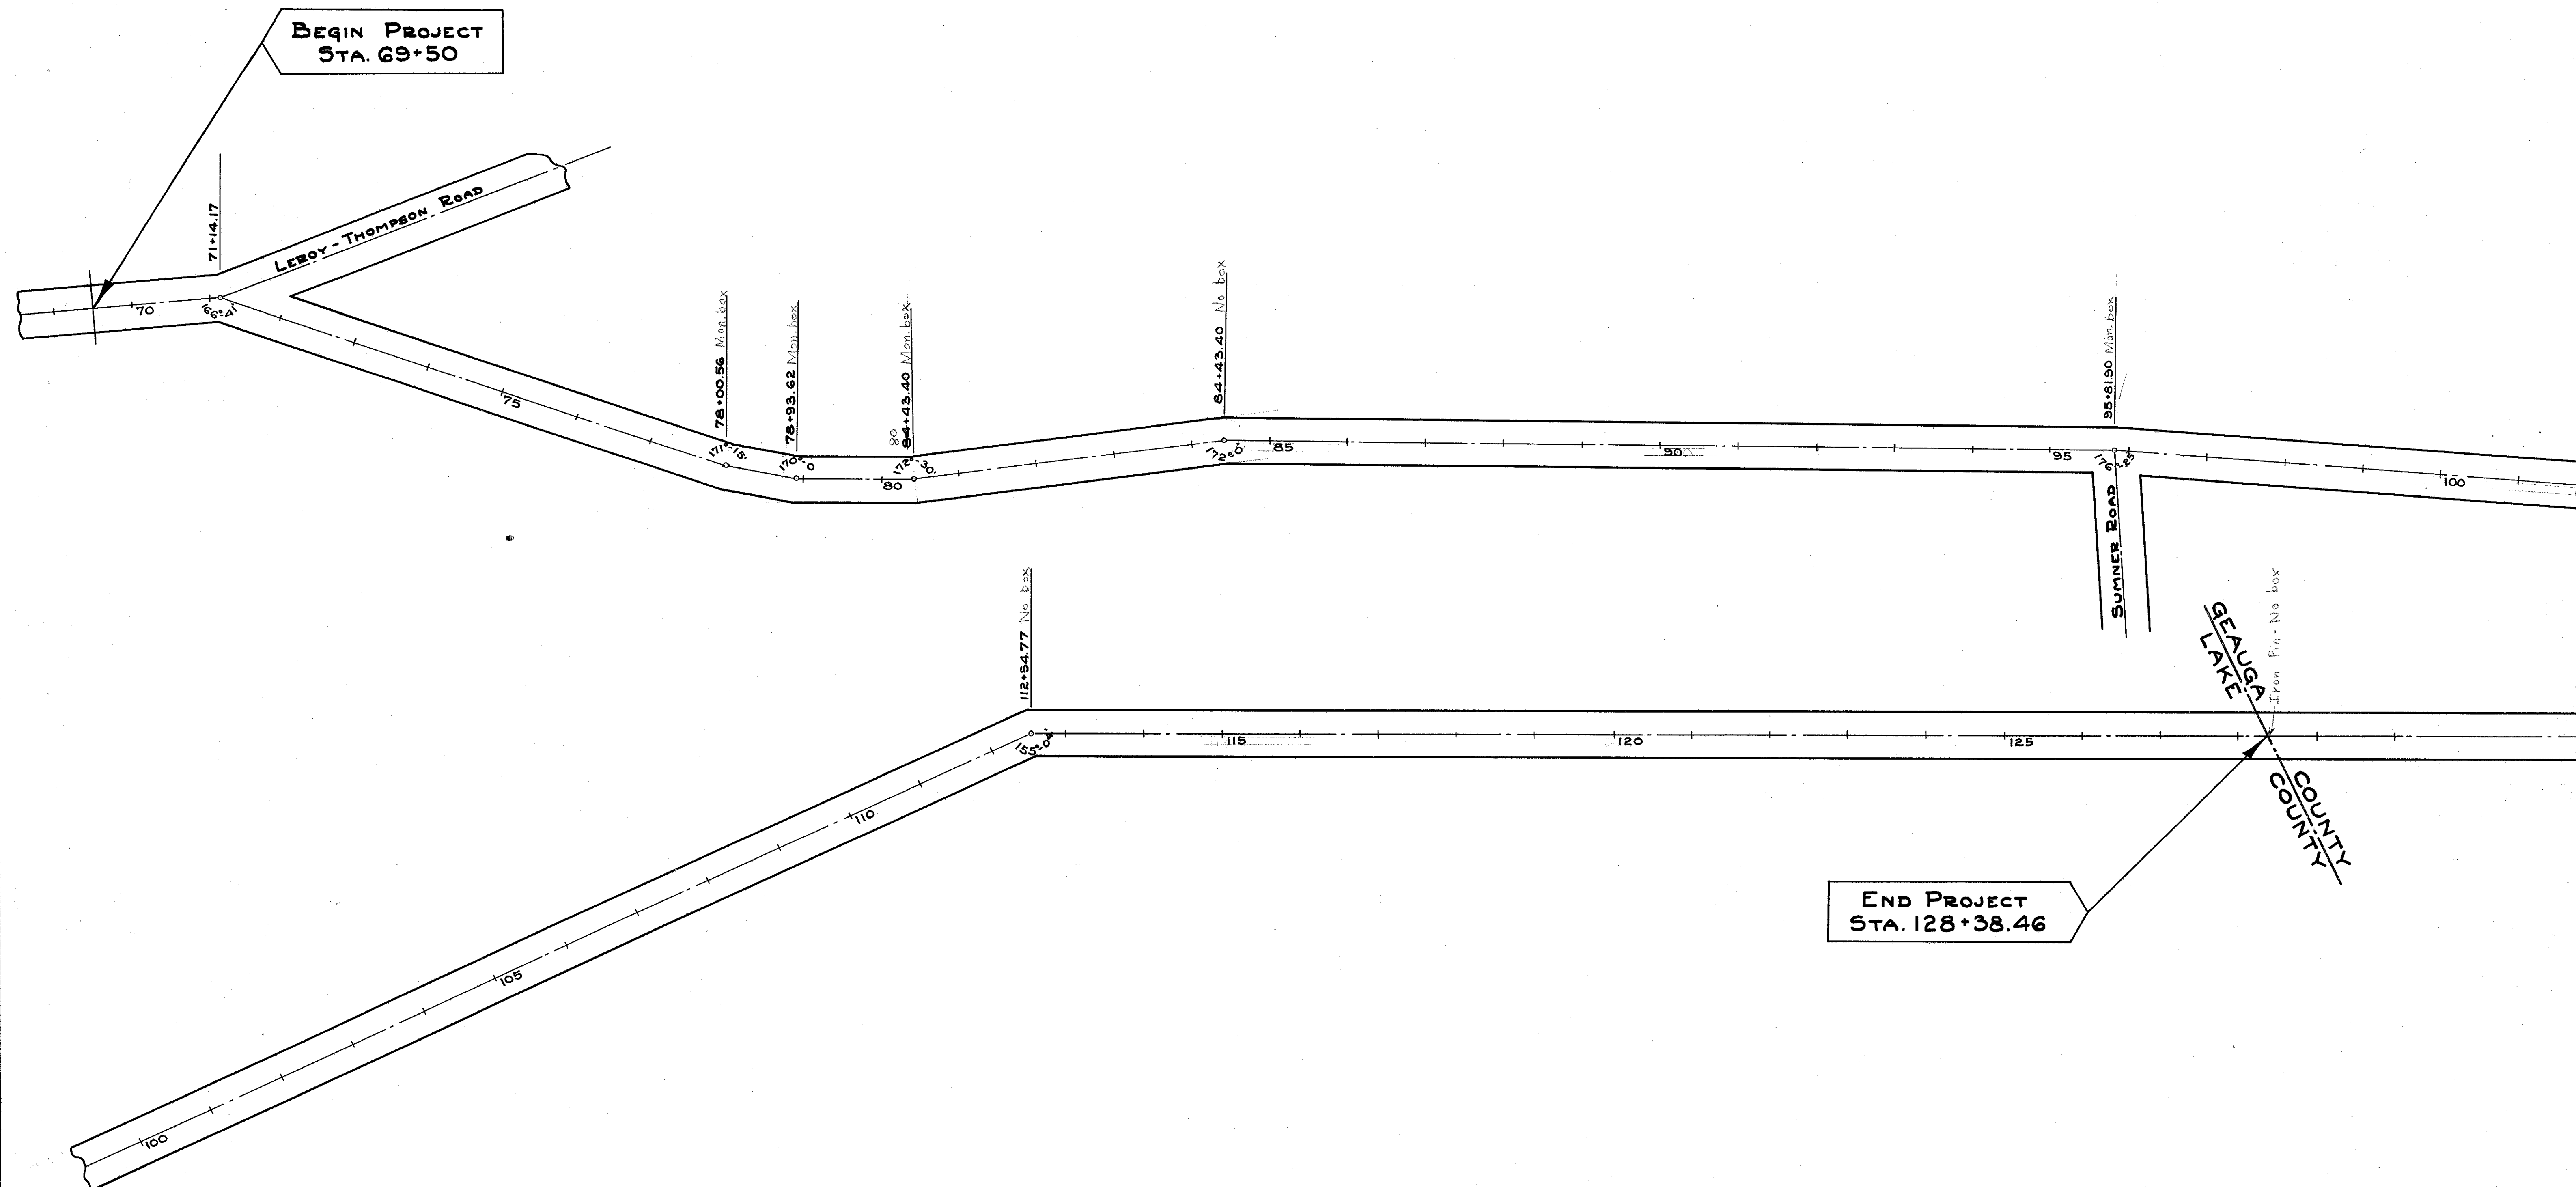

BEGIN PROJECT
STA. 69+50

END PROJECT
STA. 128+38.46