


LAKE COUNTY  
ASHTABULA COUNTY  
LAK-1-12.89  
ATB-1-0.00

TRANSITION FROM STA. 377+00  
TO STA. 416+00, FOR DETAILS AND  
QUANTITIES SEE SHEET 38.


FOR DETAIL OF INTERCHANGE SEE SHEET 25.

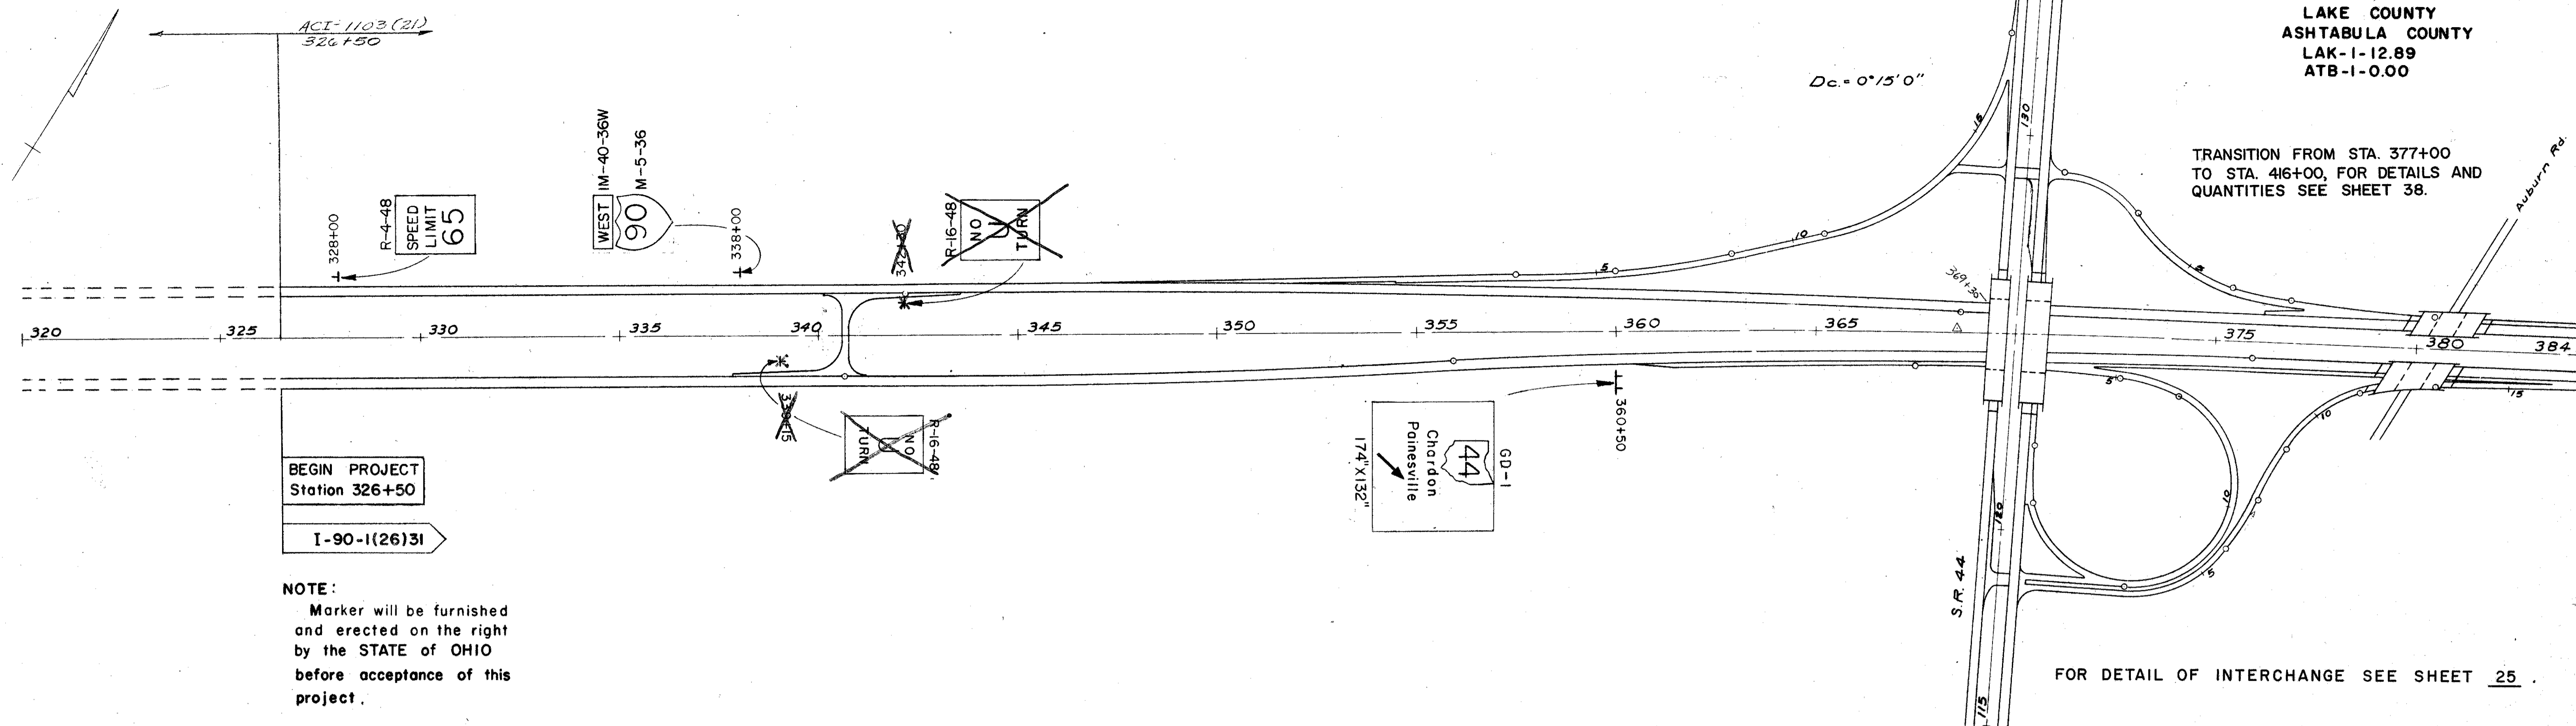

BEGIN PROJECT  
Station 326+50

I-90-1(26)31

NOTE:  
Marker will be furnished  
and erected on the right  
by the STATE of OHIO  
before acceptance of this  
project.

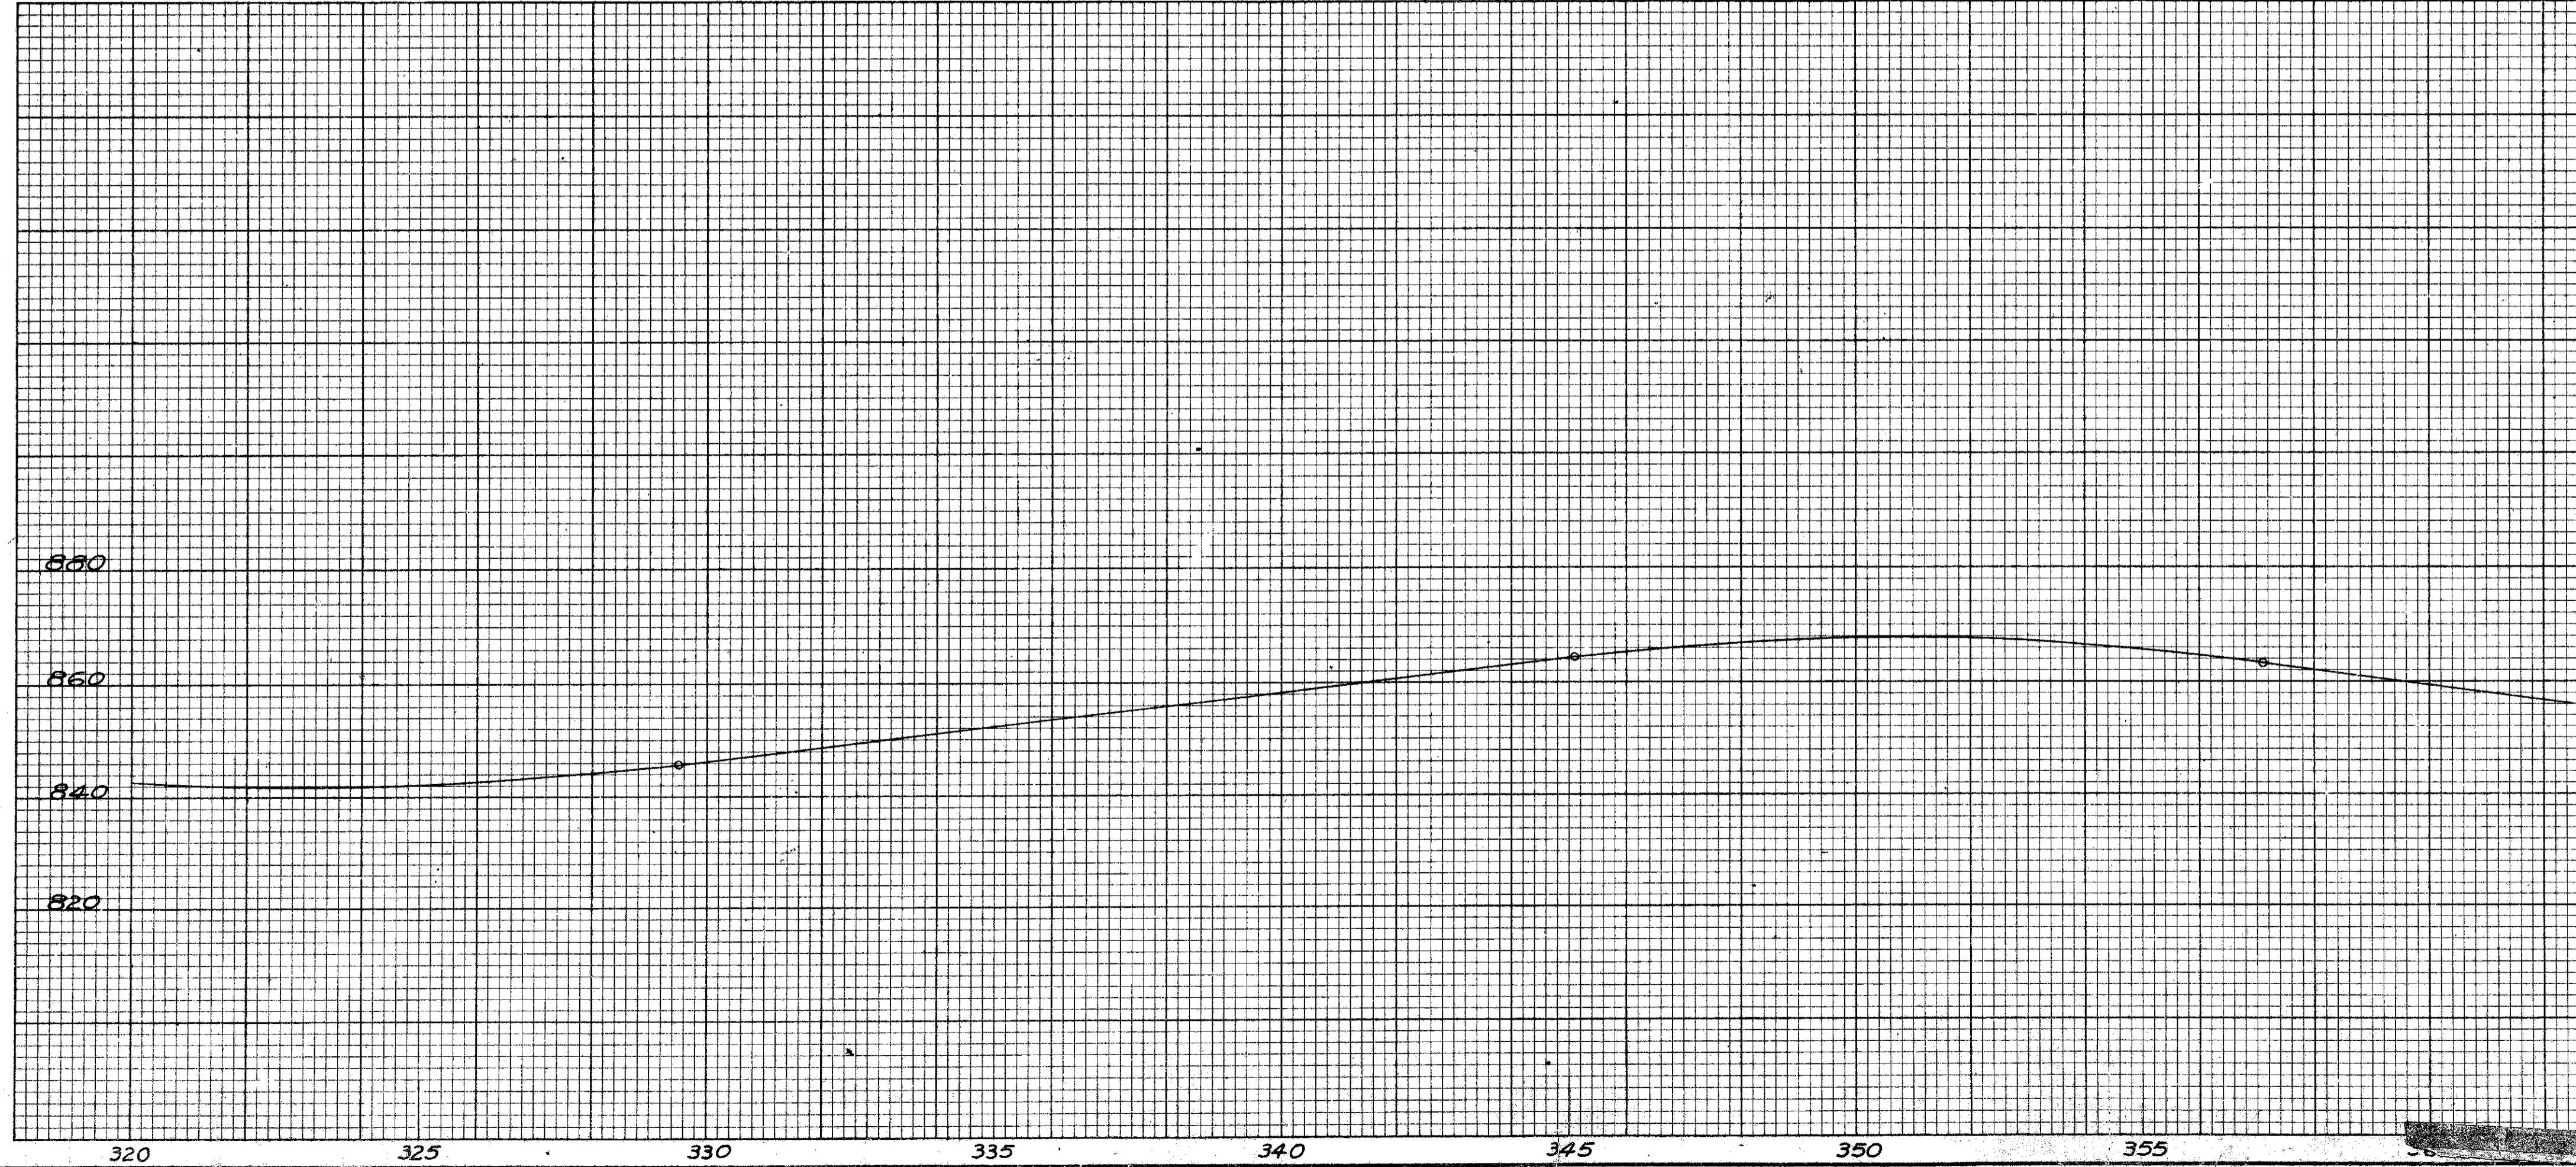

QUANTITIES

STATION	CODE NUMBER AND SIZE						SUPPORTS		1.12* D.P. BRG.			
	GD-1 174 X 132	M-5-36 36 X 36	IM-40-36W 36 X 18	R-4-48 48 X 60	R-16-48 48 X 60	R-16-48 48 X 60	# BEAM	12 B 22	PCS.	TOT.	CONC.	
	EA.	EA.	EA.	EA.	EA.	EA.	FT.	FT.	EA.-FT.	FT.	CU. YDS.	
360+50	1							26.5 285				2.54
328+00				1			18.5		2 @ 3.33	6.66	.16	
<del>338+15</del>					*		<del>18.5</del>		<del>2 @ 3.33</del>	<del>6.66</del>	<del>.16</del>	
<del>342+30</del>					*		<del>18.5</del>		<del>2 @ 3.33</del>	<del>6.66</del>	<del>.16</del>	
338+00		1	1				18.0		4 @ 1.83	7.32	.16	
TOTALS	1	1	1	1	*		<del>34.5</del> 550			<del>13.98</del> 27.30	<del>2.86</del> 3.18	