


LAKE COUNTY
LAK-1-16-55

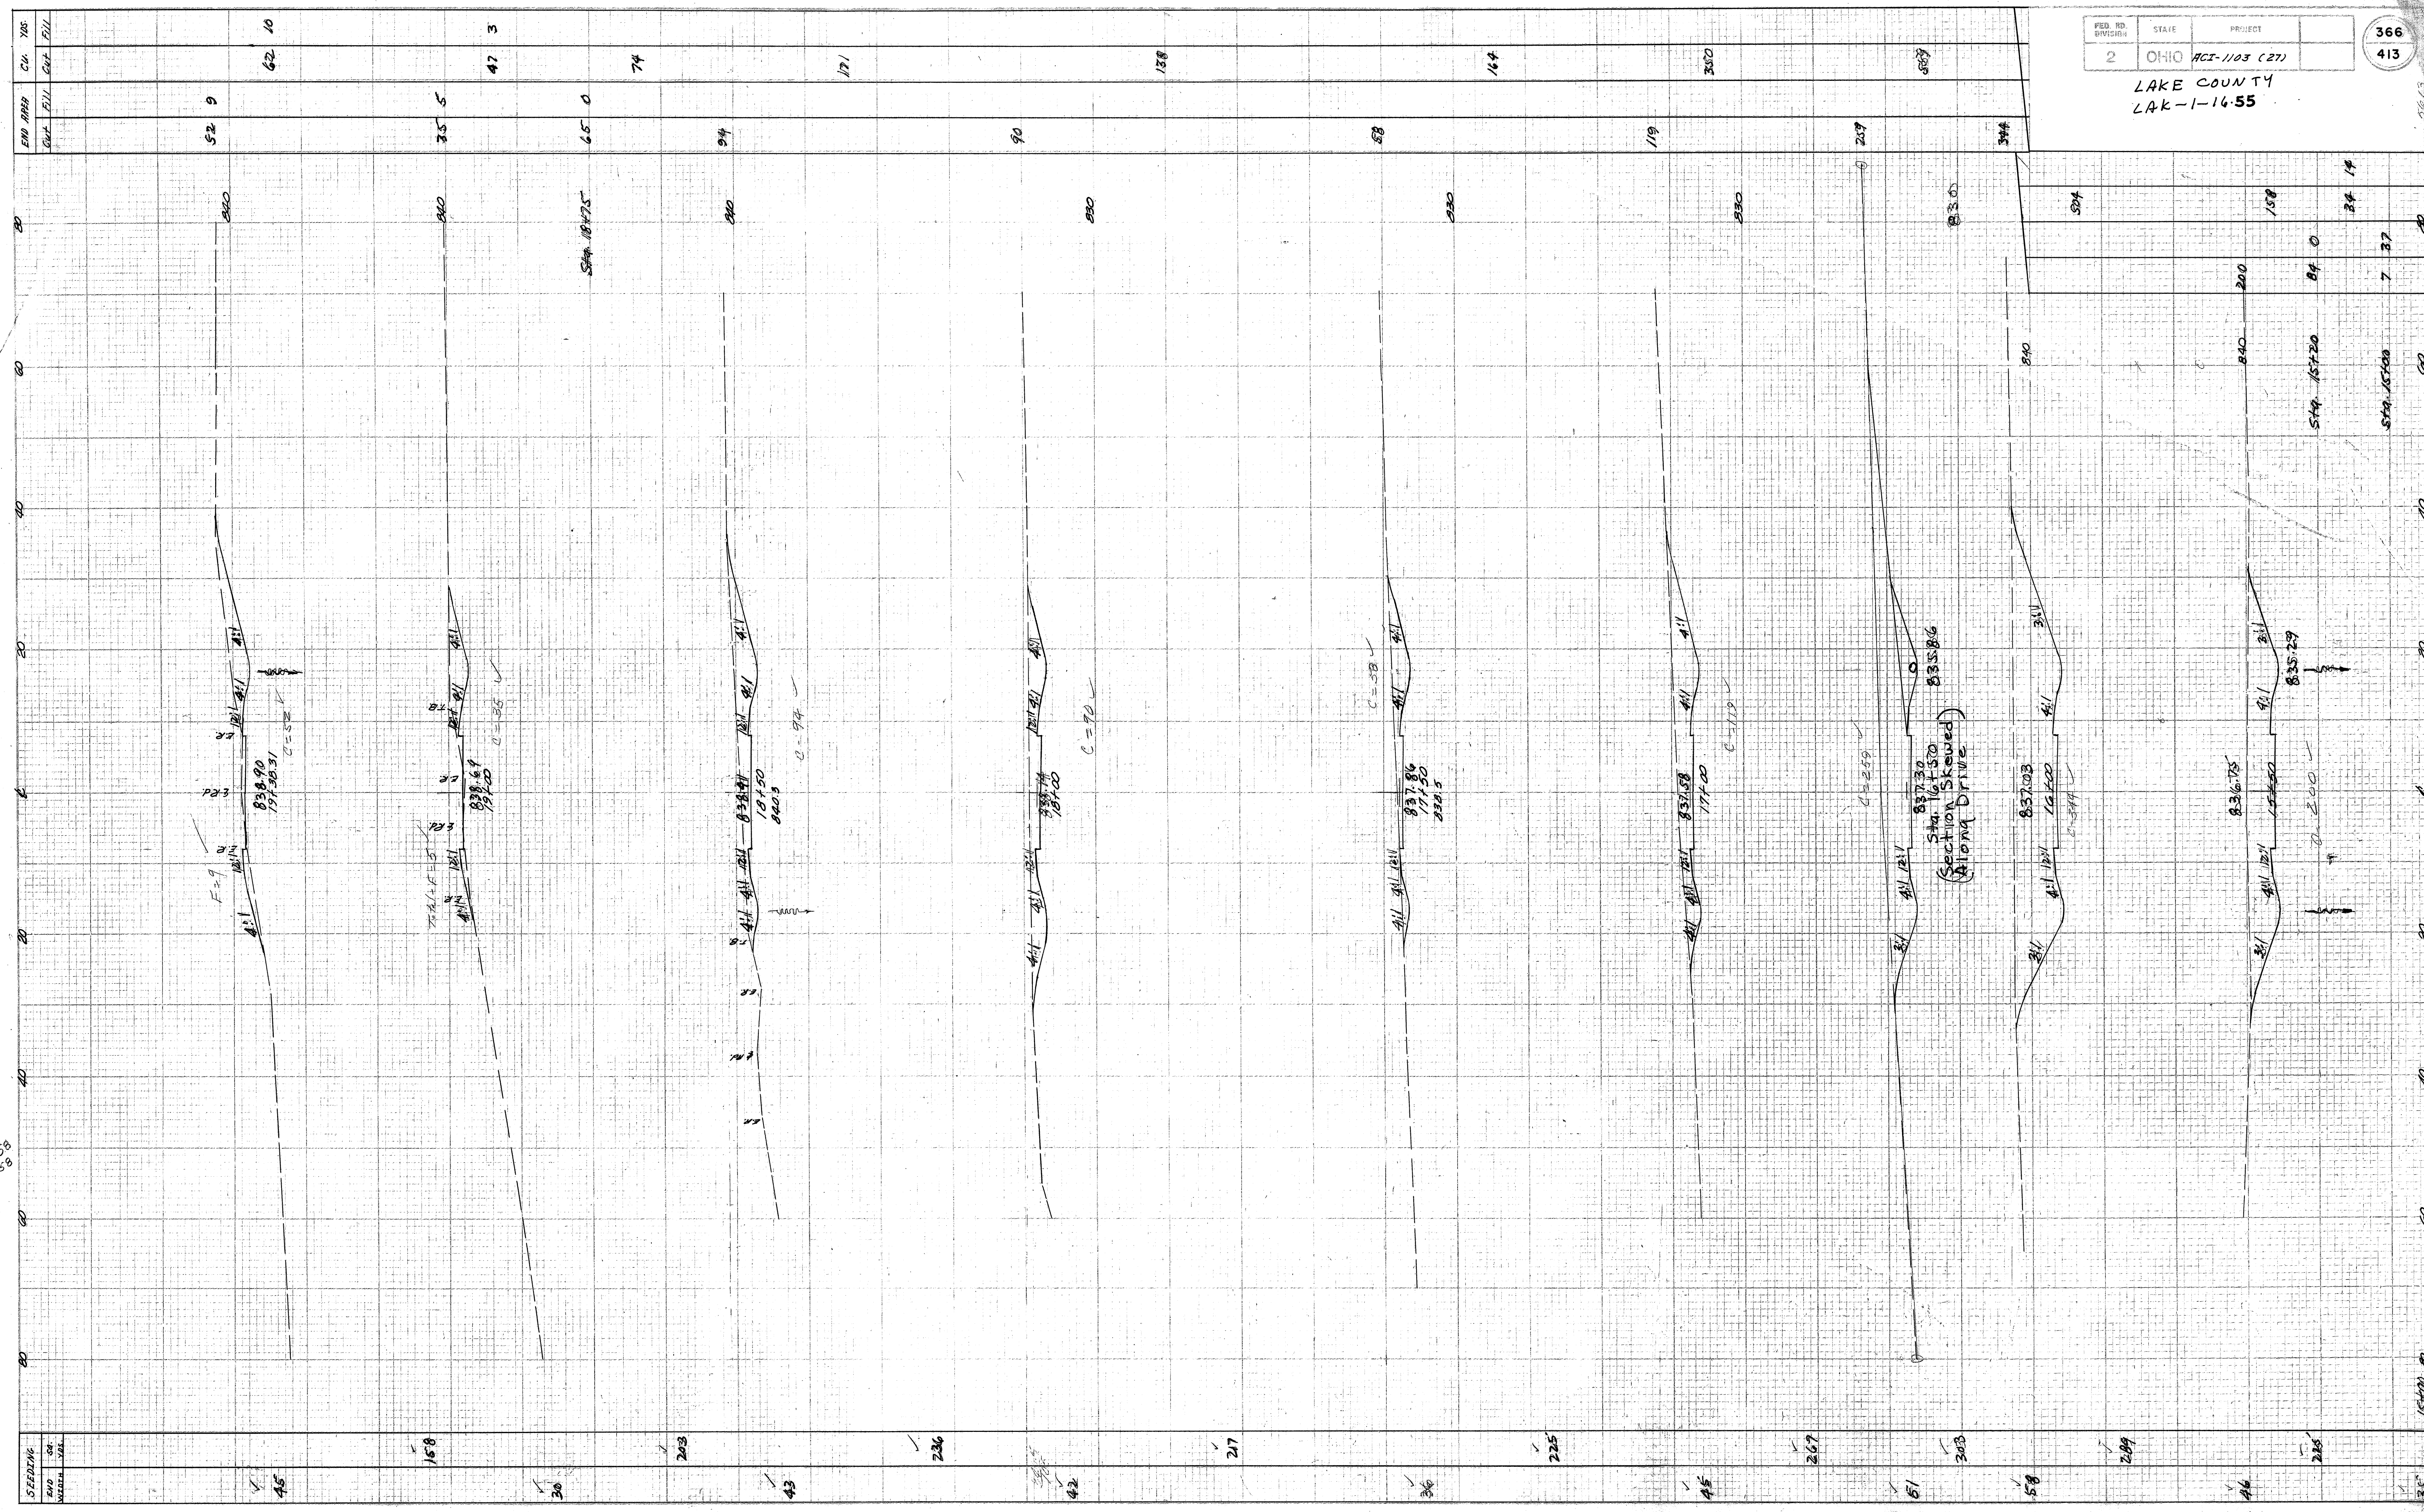

Revised md - 4-2-58
DF - 4-2-58

SEEDING	NO.	DATE	YRS.	END AREA	CUT	FILL	CUT	FILL
✓	45						52	9
✓	158						62	10
✓	30						65	0
✓	203						74	
✓	43						94	
✓	236						171	
✓	42						90	
✓	36						138	
✓	225						144	
✓	45						119	
✓	267						350	
✓	51						209	
✓	58						344	
✓	209						304	
✓	46						158	
✓	225						84	0
✓	35						34	14
✓	35						7	37

Drive Reloc. Sta 15+50 to 19+39.91