

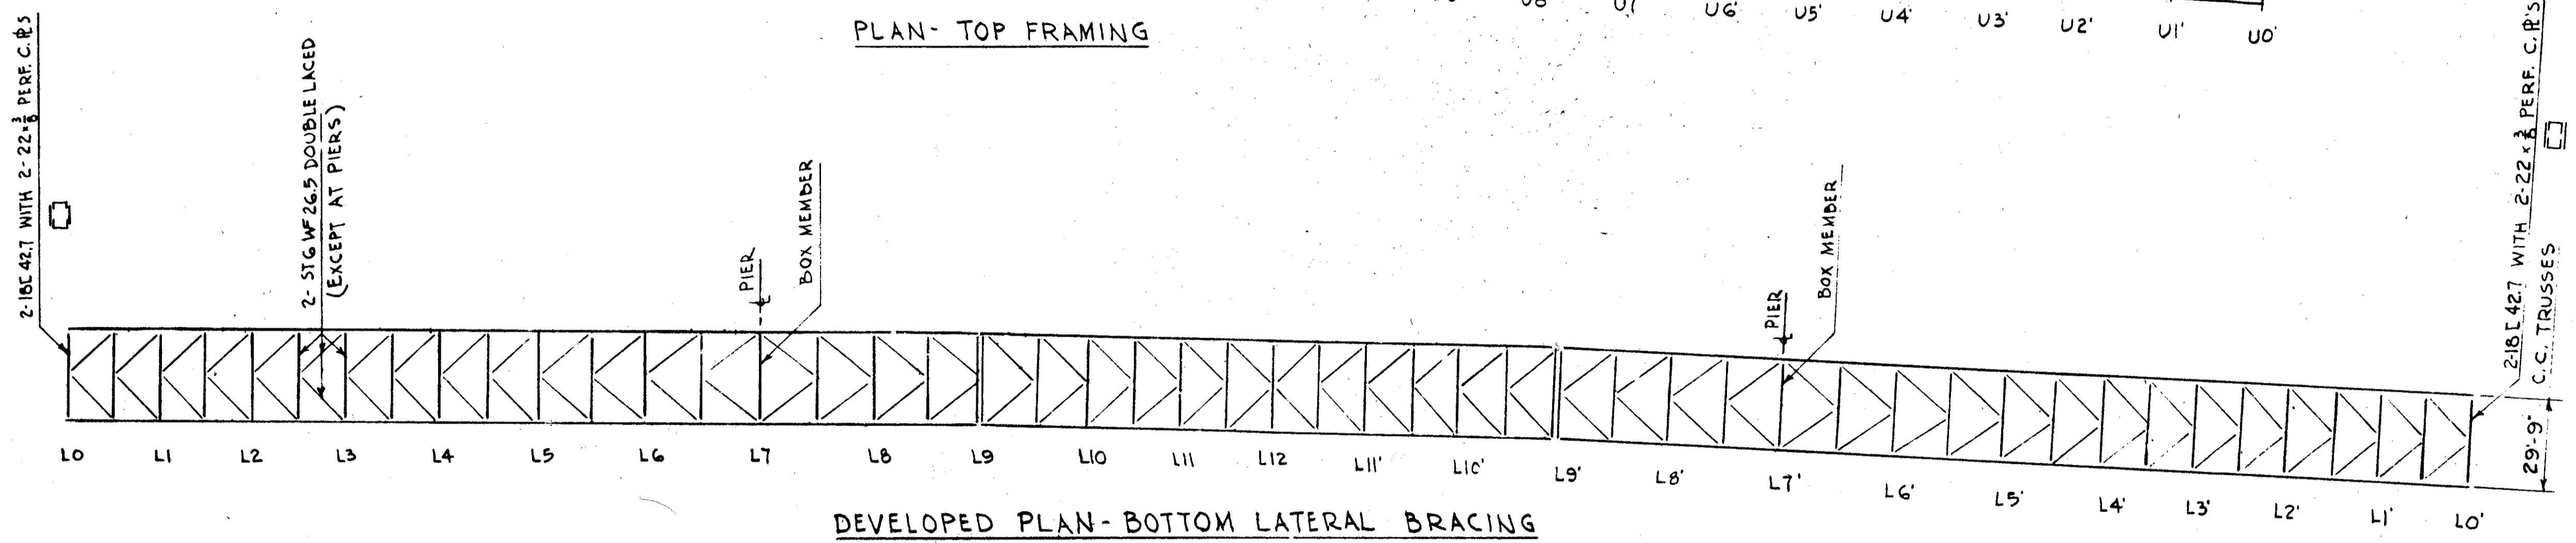


PLAN - TOP FRAMING

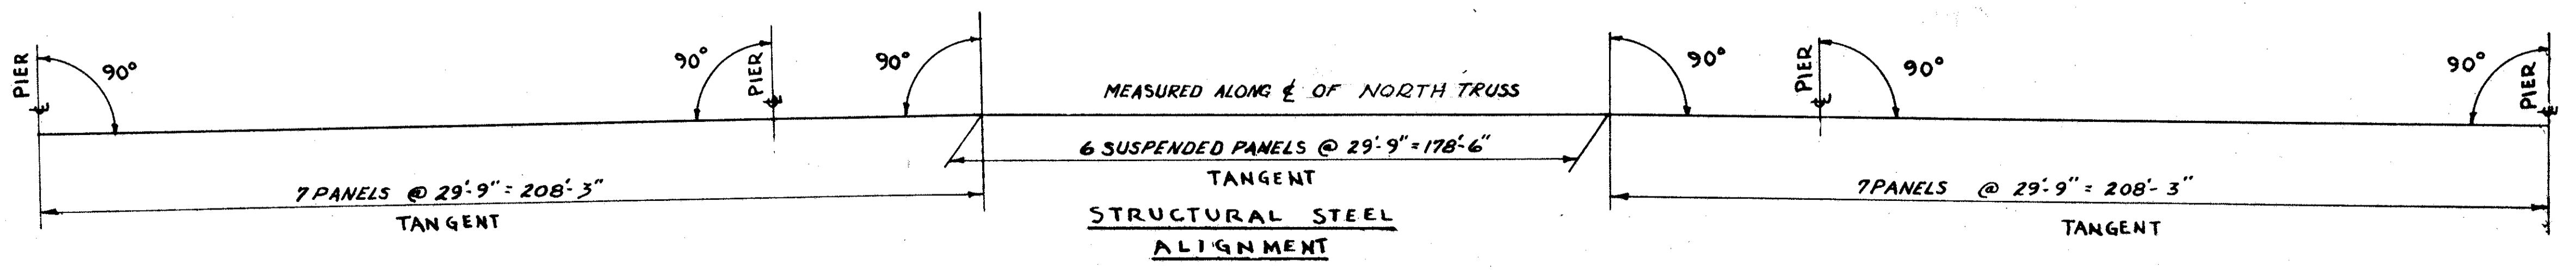

DEVELOPED PLAN - BOTTOM LATERAL BRACING

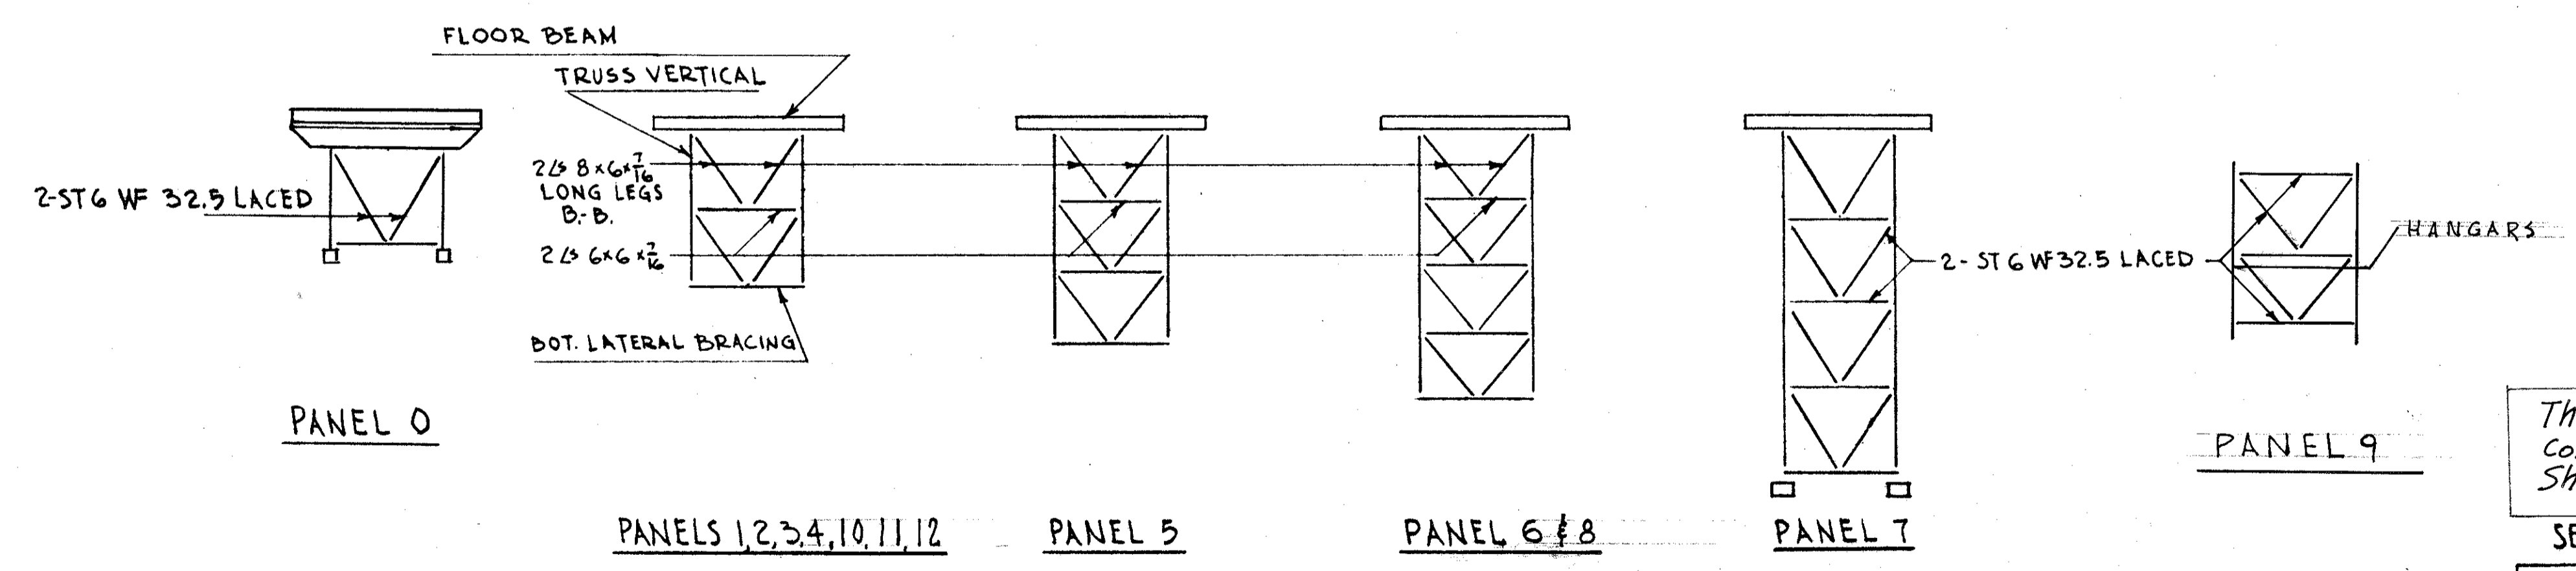

This sheet is to be used for construction and supersedes Sheet No. 44a of the Bidding Plans 9-16-58

SEC. C-34 B FED. AID PROJ. ACI-1103(30)

PREPARED BY
CAPITOL ENGINEERING ASSOCIATES, DILLSBURG, PA.
FOR

STATE OF OHIO
DEPARTMENT OF HIGH

TRUSS FRAMING PLANS
BRIDGE NO. LAK-1-2252
OVER GRAND RIVER
LAKE COUNTY
STA. 833 + 7540

DESIGNED	DRAWN	TRACED	CHECKED	REVISED DATE	REVISED
	GN			9-16-58	