

Seeding
End
Width


This sheet supersedes
Sheet N° 183
Added 3-24-60 R.E.C.

FED. RD. DIVISION	STATE	PROJECT
2	OHIO	1-1103(20)

183-S
333

LAKE COUNTY
LAK - 1 - 4.02

End Area		Volume	
Cut	Fill	Cut	Fill

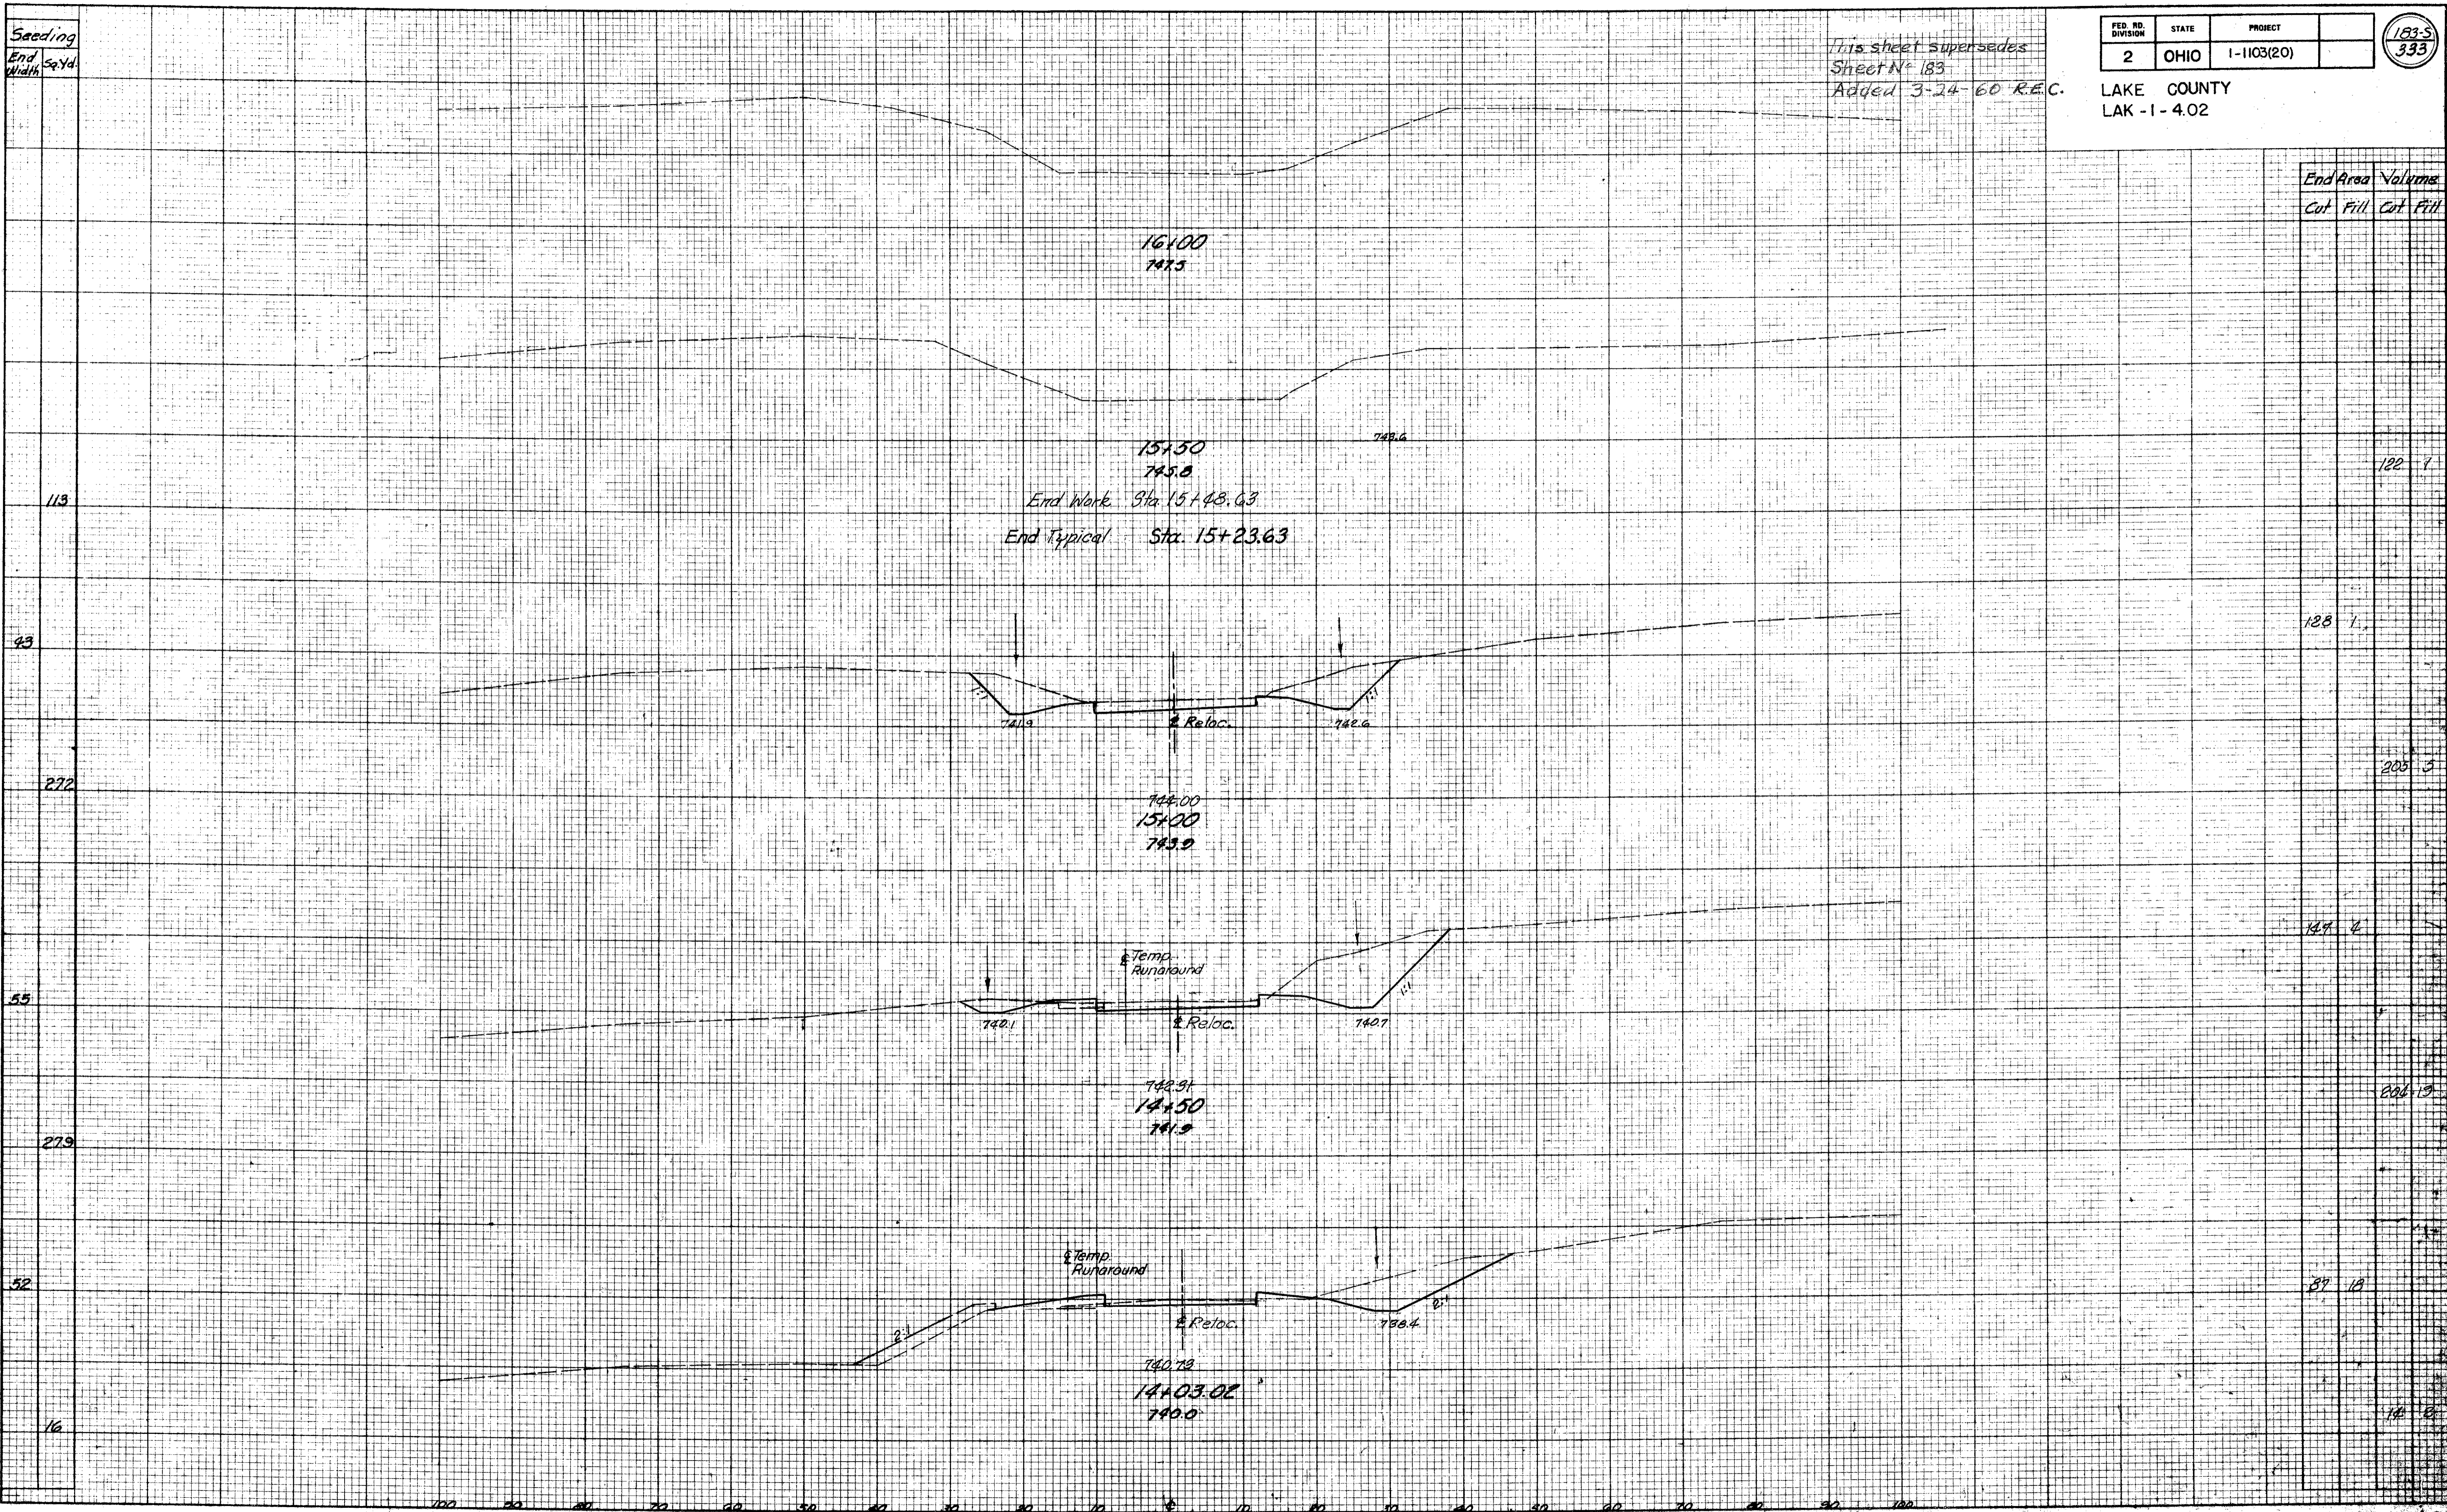

113

93

272

55

279

52

16

122 1

128 1

205 5

147 4

206 13

87 10

12 0