



Clyde H. & Ruth E. Schweitzer
V. 324-97

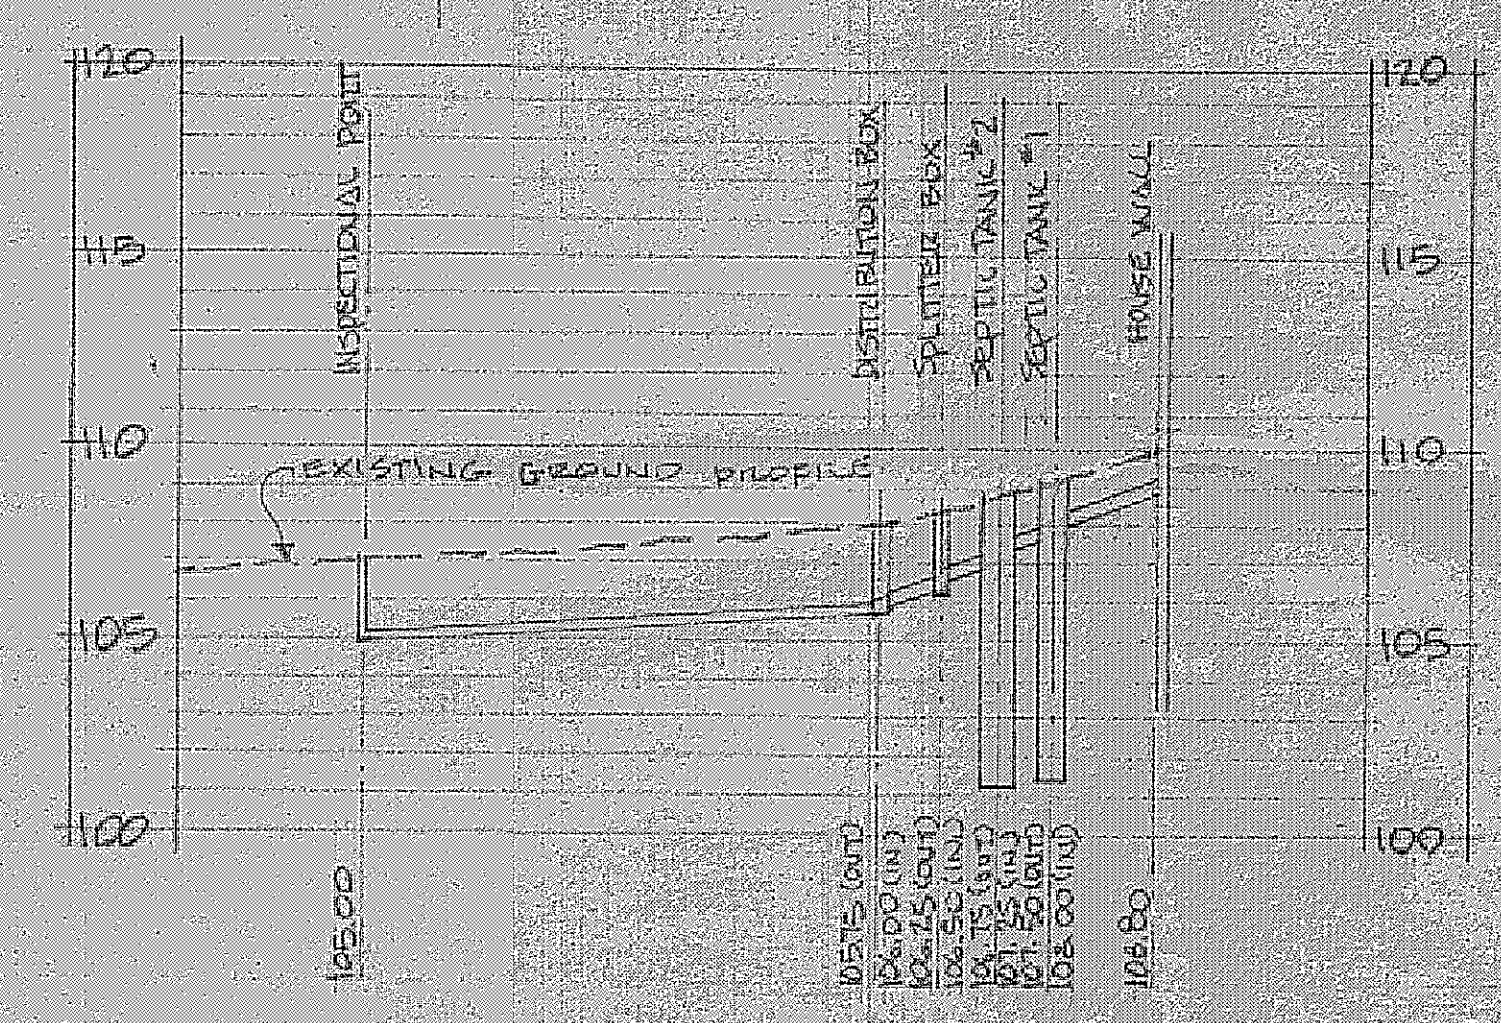

SEPTIC SYSTEM PROFILE
SCALE: HORIZ. 1" = 40'
VERT. 1" = 5'

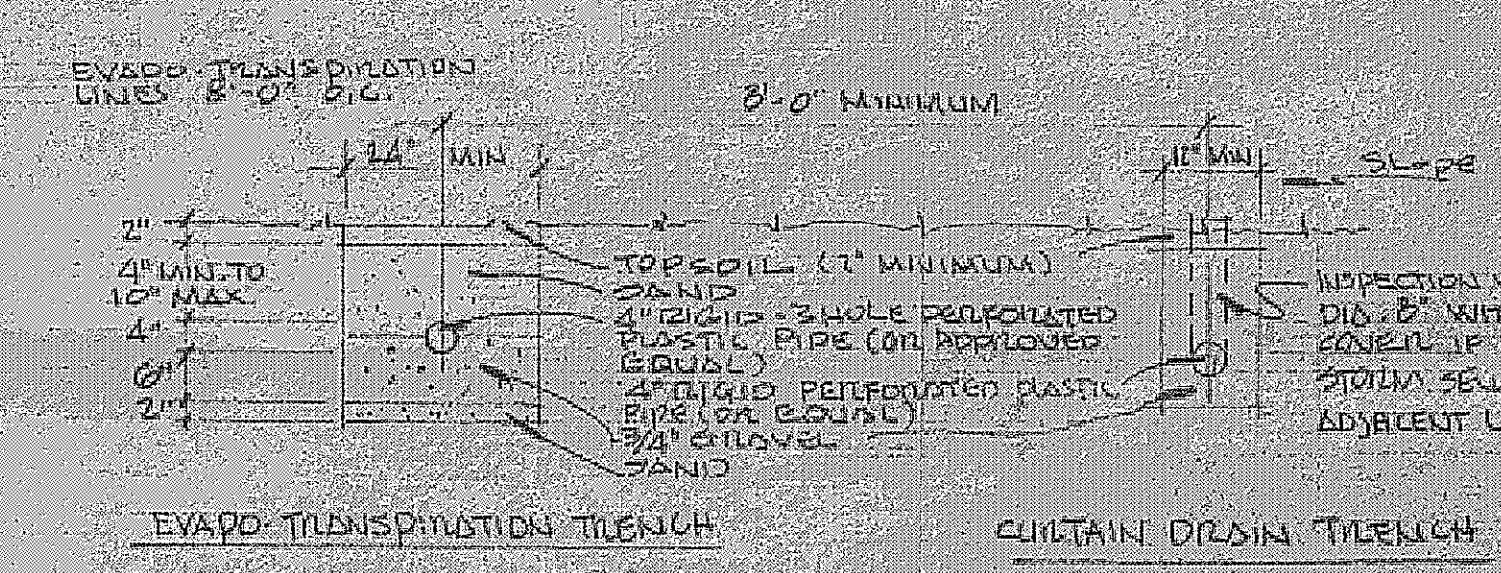

REVISION

ADDED SEWAGE SYSTEM 3/19/78

Grading Plan Approved
as shown and/or noted
THOMAS P. GILLES, P.E.
Lake County Engineer
By TEG Date 5/18/78

TOPOGRAPHICAL SURVEY
FOR
AUBURN CAREER CENTER
BEING A PART OF LOT 13, TRACT 3 IN
CONCORD TOWNSHIP, LAKE COUNTY, OHIO

Colpetzer • Woods Consultants, Inc.
CONSULTING ENGINEERS AND SURVEYORS
PAINESVILLE, OHIO 44077

Grading Plan Approved
as shown and/or noted
THOMAS P. GILLES, P.E.
Lake County Engineer
By TEG Date 5/18/78

SHEET 1 OF 1
CONTRACT NO. 77300

- A. To be brought to finished grade
1. Septic tank manhole covers
 2. Spiller box cover
 3. Distribution box cover
 4. Pipe caps
- B. All water drains or downspouts
to be connected into septic tanks
- C. All water to be discharged into
septic tanks

Reviewed and Accepted
LAKE COUNTY COMBINED GENERAL
DISTRICT DEPARTMENT OF HEALTH
Date 3-16-78
FRED C. KLUHN, M.D.
Health Commissioner
By [Signature]

3544

ZONING PERMIT
ISSUED 3-22-78

SUBJECT TO APPROVAL BY:
Lake County Sanitary Eng. ☐
Lake County Eng. Dept. ☒
Lake County Planning Comm. ☐
Lake County Bldg. Dept. ☒
J.E. [Signature]

DESIGN CERTIFICATION

THIS PLAT WAS PREPARED BY ME, AND IS
CORRECT TO THE BEST OF MY KNOWLEDGE
AND BELIEF.
[Signature]
REG. SURVEYOR N. 4785

AS BUILT CERTIFICATION

I HEREBY CERTIFY THAT THE CIRCLED GRADES
ARE EXISTING FINISH GRADES CHECKED IN FIELD
ON [Date] AND THAT SURVEY
IS CORRECT TO THE BEST OF KNOWLEDGE
AND BELIEF.
[Signature]

REG. SURVEYOR N. 4785