Grading Plan Approved as shown and/or noted THOMAS P. GILLES, P.E. Lake County Engineer E H Date 11.2897) **7** 7.000000 PETINITY #1197-8931 11/24/97

2001 - 882,76 1387

REG. NO.

REGISTERED SURVEYOR

"AS BUILT" CERTIFICATION
I, HEREBY CERTIFY THAT THE CIRCLED GRADES ARE EXISTING
FINISH GRADES CHECKED IN THE FIELD ON _______, 19_____,
AND ARE CORRECT TO THE BEST OF MY KNOWLEDGE AND BELIEF.


00-220-15	ĭ	APP'D	WB.	CHEF			5
DATE 11/12/97 DRAWING NO.	1/12/97	DATE	ΪŢ	CHK'D.			4
"-30' PHONE NO. 216-357-1811	-30 <u>-</u>	SCALE	T,R,	DRAWN BY			3
0	PAINESVILLE, OHIO	PAIN		(2
BABCOCK JONES & ASSOCIATES, INC.	ES & AS	VOC.	3000	BAL			1
BY:	PLAN PREPARED BY:	PLAN			野	DATE	NO.
						REVISIONS	

WATER MAIN SIZE, LOCATION
SAN. SEWER SIZE % GR. LOC.
SAN. MH. CAST. ELEV. INV. ELEV.
SAN. CONN. SIZE, LOC. DEPTH
STORM SEWER SIZE % GR. LOC.
STORM MH. CAST ELEV. INV. ELEV.
PAY'T TYPE GRADE CURBS
GAS LINE LOC. SIZE PRESSURE
SEPTIC TANK LOCATION & DUPLICATION AREA
WELL LOCATION
ISOLATION RADIUS FROM WELL

DESIGN CERTIFICATION
THIS PLAT WAS PREPARED BY ME, AND IS CORRECT
TO THE BEST OF MY KNOWLEDGE AND BELIEF. CHECK LIST

REMARKS ALL BOUNDARY DATA SHOWN WAS OBTAINED FROM (DEEDS, RECORDED SUBDIVISION PLAT OR OTHER PUBLIC RECORDS) LOCATIONS AS SHOWN OF ADJACENT WELLS AND SEPTIC TANKS OBTAINED FROM LAKE COUNTY HEALTH DEPARTMENT

EXISTING CONTOURS — —
PROPOSED CONTOURS —— ¢ SURFACE DRAINAGE DIRECTION OF

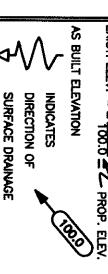


HYDRANT


SOCIOT NO.	VOL-PG.	SUBDIVISION $12-3$ NAME	MORIEY HILLS SUB.	AUDRESS
PERM. PARCEL NO.	l. ,	LOT		STREET CITY
SIREE	PAGE	TRACT		ZIP

SHANDLE HOMES CONCORD TOWNSHIP. CLIENT COUNTY, OHIO

for:

ALDER COLET - 60'

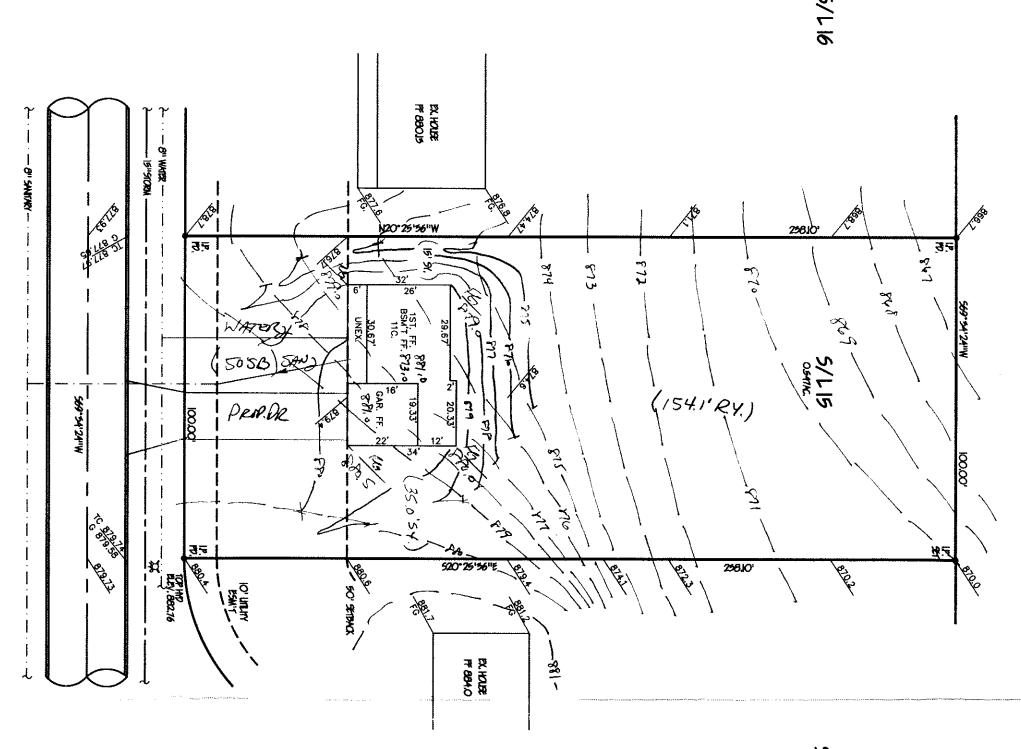

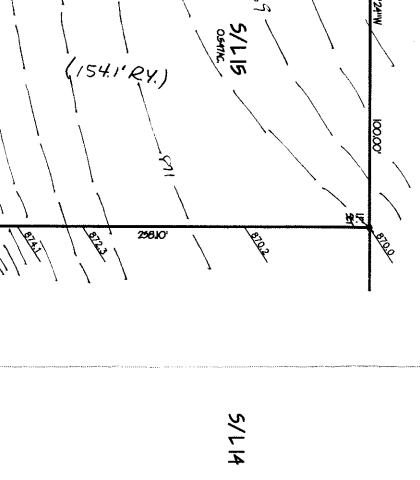

NO. OF BEDROOMS
DIMENSIONS
BEARINGS
TIE TO NEAREST STREET
SUBLOT NO. PARCEL NO.
SURROUNDING OWNERS
BLDG. DIMENSIONS FIN GR.
BLDG. TIES FL'R. GRADES
APRON TYPE WIDTH THICKNESS
SIDEWALK TYPE WIDTH THICKNESS
CULVERT TYPE DA., LENGTH
ROCK OUTCROPPINGS

SHE PLAN