

LEGEND

- SURFACE DRAINAGE
- EX. M.H.
- EX. HYD.
- SPOT ELEVATIONS
- ⊕ EX. MONUMENT
- IRON PIN TO BE SET (CAPPED 'SUHAIL 7806')
- ⊙ YARD DRAIN
- ⊗ LINE VALVE/CURB STOP
- IRON PIN FOUND
- GAS PIPE
- LIGHT POLE



EHTESHAM SUHAIL



NOTE: RYAN HOMES TO COMPLY WITH LAKE COUNTY SOIL & WATER CONSERVATION DISTRICT EROSION & SEDIMENT CONTROL TECHNICAL BULLETIN "CONSTRUCTION ENTRANCE", "INLET PROTECTION", "TEMPORARY SEEDING & MULCHING" AND "SILT FENCE INSTALLATION" PER CONCORD TOWNSHIP REQUIREMENTS. REFER TO WWW.LAKECOUNTYOHIO.ORG/SOIL FOR TECHNICAL DETAILS IN BULLETINS.

- CITY GENERAL NOTES:
- ALL WORK TO MEET THE REQUIREMENTS AND REGULATIONS OF THE CONCORD TOWNSHIP AND TO BE AT THEIR DIRECTION AND INSPECTION.
 - ALL INSPECTION FEES SHALL BE PAID BY OWNER/CONTRACTOR.
 - PAVEMENT CUT PERMIT REQUIRED FOR ALL WORK IN ROADWAY.
 - LOW STRENGTH MORTAR (LSM-50) BACKFILL SHALL BE USED IN ROADWAY.
 - CURB CUT PERMIT IS REQUIRED.
 - CONTRACTOR SHALL NOTIFY THE CITY ENGINEER/BUILDING DEPARTMENT 24 HOURS BEFORE ANY WORK IS TO BE DONE.
 - CONTRACTOR SHALL NOTIFY ALL UTILITY COMPANIES 48 HOURS PRIOR TO CONSTRUCTION.
 - TRAFFIC SHALL BE MAINTAINED AT ALL TIMES.
 - CONTRACTOR SHALL USE 6" CLASS 'C' CONCRETE IN DRIVEWAY APRON AND SIDEWALK ACROSS DRIVEWAY IN RESIDENTIAL AREAS (8" IN COMMERCIAL OR INDUSTRIAL AREAS).

- CITY GENERAL NOTES: (CONT'D.):
- ALL DEFECTIVE SIDEWALK SHALL BE REPLACED AT THE DIRECTION OF THE CITY ENGINEER.
 - DOWNSPOUTS AND FOOTER DRAINS SHALL NOT BE CONNECTED INTO STORM SEWER OR SANITARY SEWER.
 - DOWNSPOUTS TO BE SPLASHBLOCKED.
 - DISPOSAL OF ON-SITE BRUSH, TREES AND BUILDING MATERIALS SHALL CONFORM TO CONCORD TOWNSHIP CODE.
 - CONTRACTOR/DEVELOPER TO COMPLY WITH N.P.D.E.S - PHASE 2 STORM WATER PERMIT REQUIREMENTS.
 - SUMP PUMP TIE-IN SHALL BE CORE DRILLED WITH FLEXIBLE BOOT INSERT TO RECEIVE 4" PVC TORM PIPE.
 - CLEANOUT ELEVATIONS TAKEN FROM PLANS. NOT FIELD VERIFIED.

BENCH MARK
TOP OF HYDRANT
IN FRONT OF S/L 11
ELEV. 1055.53

REVISIONS :	DATE	DESCRIPTION	BY

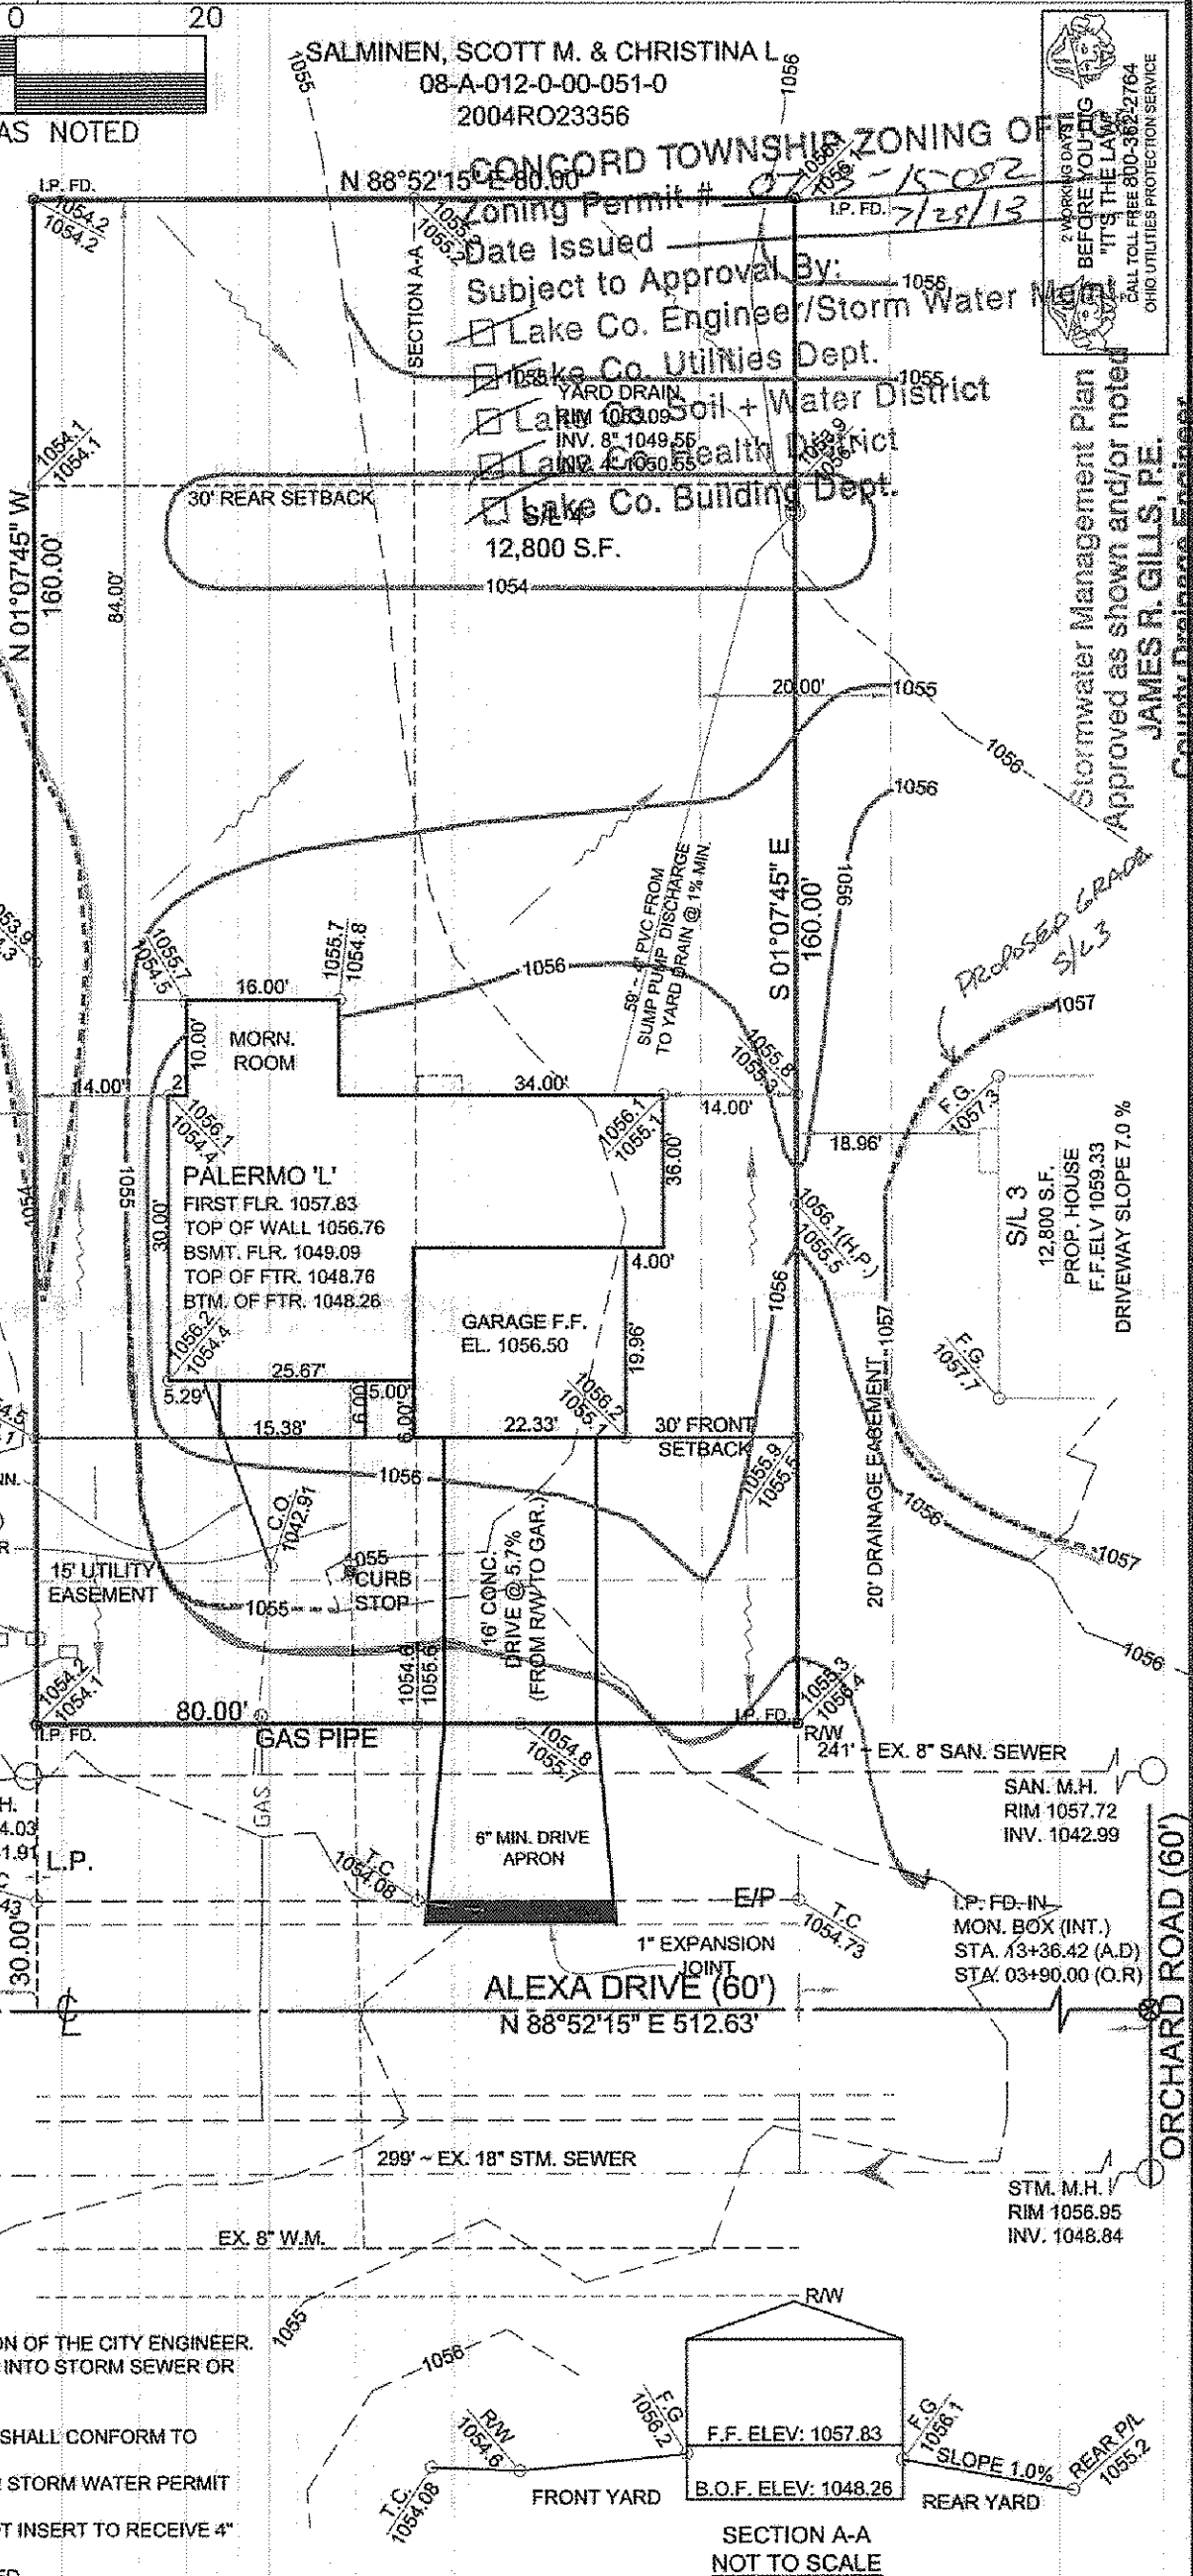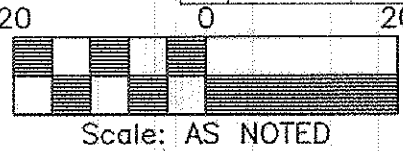

SITE PLAN FOR S/L 4
ORCHARD SPRINGS
PHASE 1

BEING A PART OF LOT 14, TRACT NO. 3, CONCORD TOWNSHIP 10
NORTH, RANGE VIII WEST OF THE CONNECTICUT WESTERN RESERVE
CONCORD TOWNSHIP, COUNTY OF LAKE, STATE OF OHIO

PREPARED FOR
RYAN HOMES
6770 W. SNOWVILLE ROAD
SUITE 100
BRECKSVILLE, OHIO 44141
(440) 584-4200

S&S JOB NO.	SHEET NO.
13101	1 OF 2

Suhail & Suhail, Inc.
Engineers • Surveyors • Land Planners
18405 May Court, Chagrin Falls, Ohio 44023
Ph.: (440) 708-1330 Fax: (440) 708-1334

800 660 4291