

SITE PLAN

CONCORD TOWNSHIP LAKE COUNTY, OHIO

for: A WOLF HOMES
30124 RIDGE ROAD WICKLIFFE 44092
ADDER STREET CITY

FORESTWOOD SUBDIVISION
SUBDIVISION NO. 1-40 NAME S. ANDREA DRIVE
SUBLOT NO. STREET

LOT VOLUME PERM. PARCEL NO. TRACT PAGE STREET

LEGEND

SANITARY MANHOLE
STORM MANHOLE
INLET OR CATCH BASIN
HYDRANT
EXISTING CONTOURS
PROPOSED CONTOURS
EXIST. ELEV.
PROV. ELEV.
WATER VALVE (GAS)
WATER METER (GAS)
AS BUILT ELEVATION
INDICATES DIRECTION OF SURFACE DRAINAGE



REMARKS

ALL BOUNDARY DATA SHOWN WAS OBTAINED FROM (DEEDS, RECORDED SUBDIVISION PLAT OR OTHER PUBLIC RECORDS)
LOCATIONS AS SHOWN OF ADJACENT WELLS AND SEPTIC TANKS OBTAINED FROM LAKE COUNTY HEALTH DEPARTMENT

DESIGN CERTIFICATION

THIS PLAT WAS PREPARED BY ME, AND IS CORRECT TO THE BEST OF MY KNOWLEDGE AND BELIEF.
NAME SURVEYOR REGISTRATION NO.

Grading Plan Approved
as shown and/or noted
THOMAS P. GILLES, P.E.
Lake County Engineer
By Date 5-86

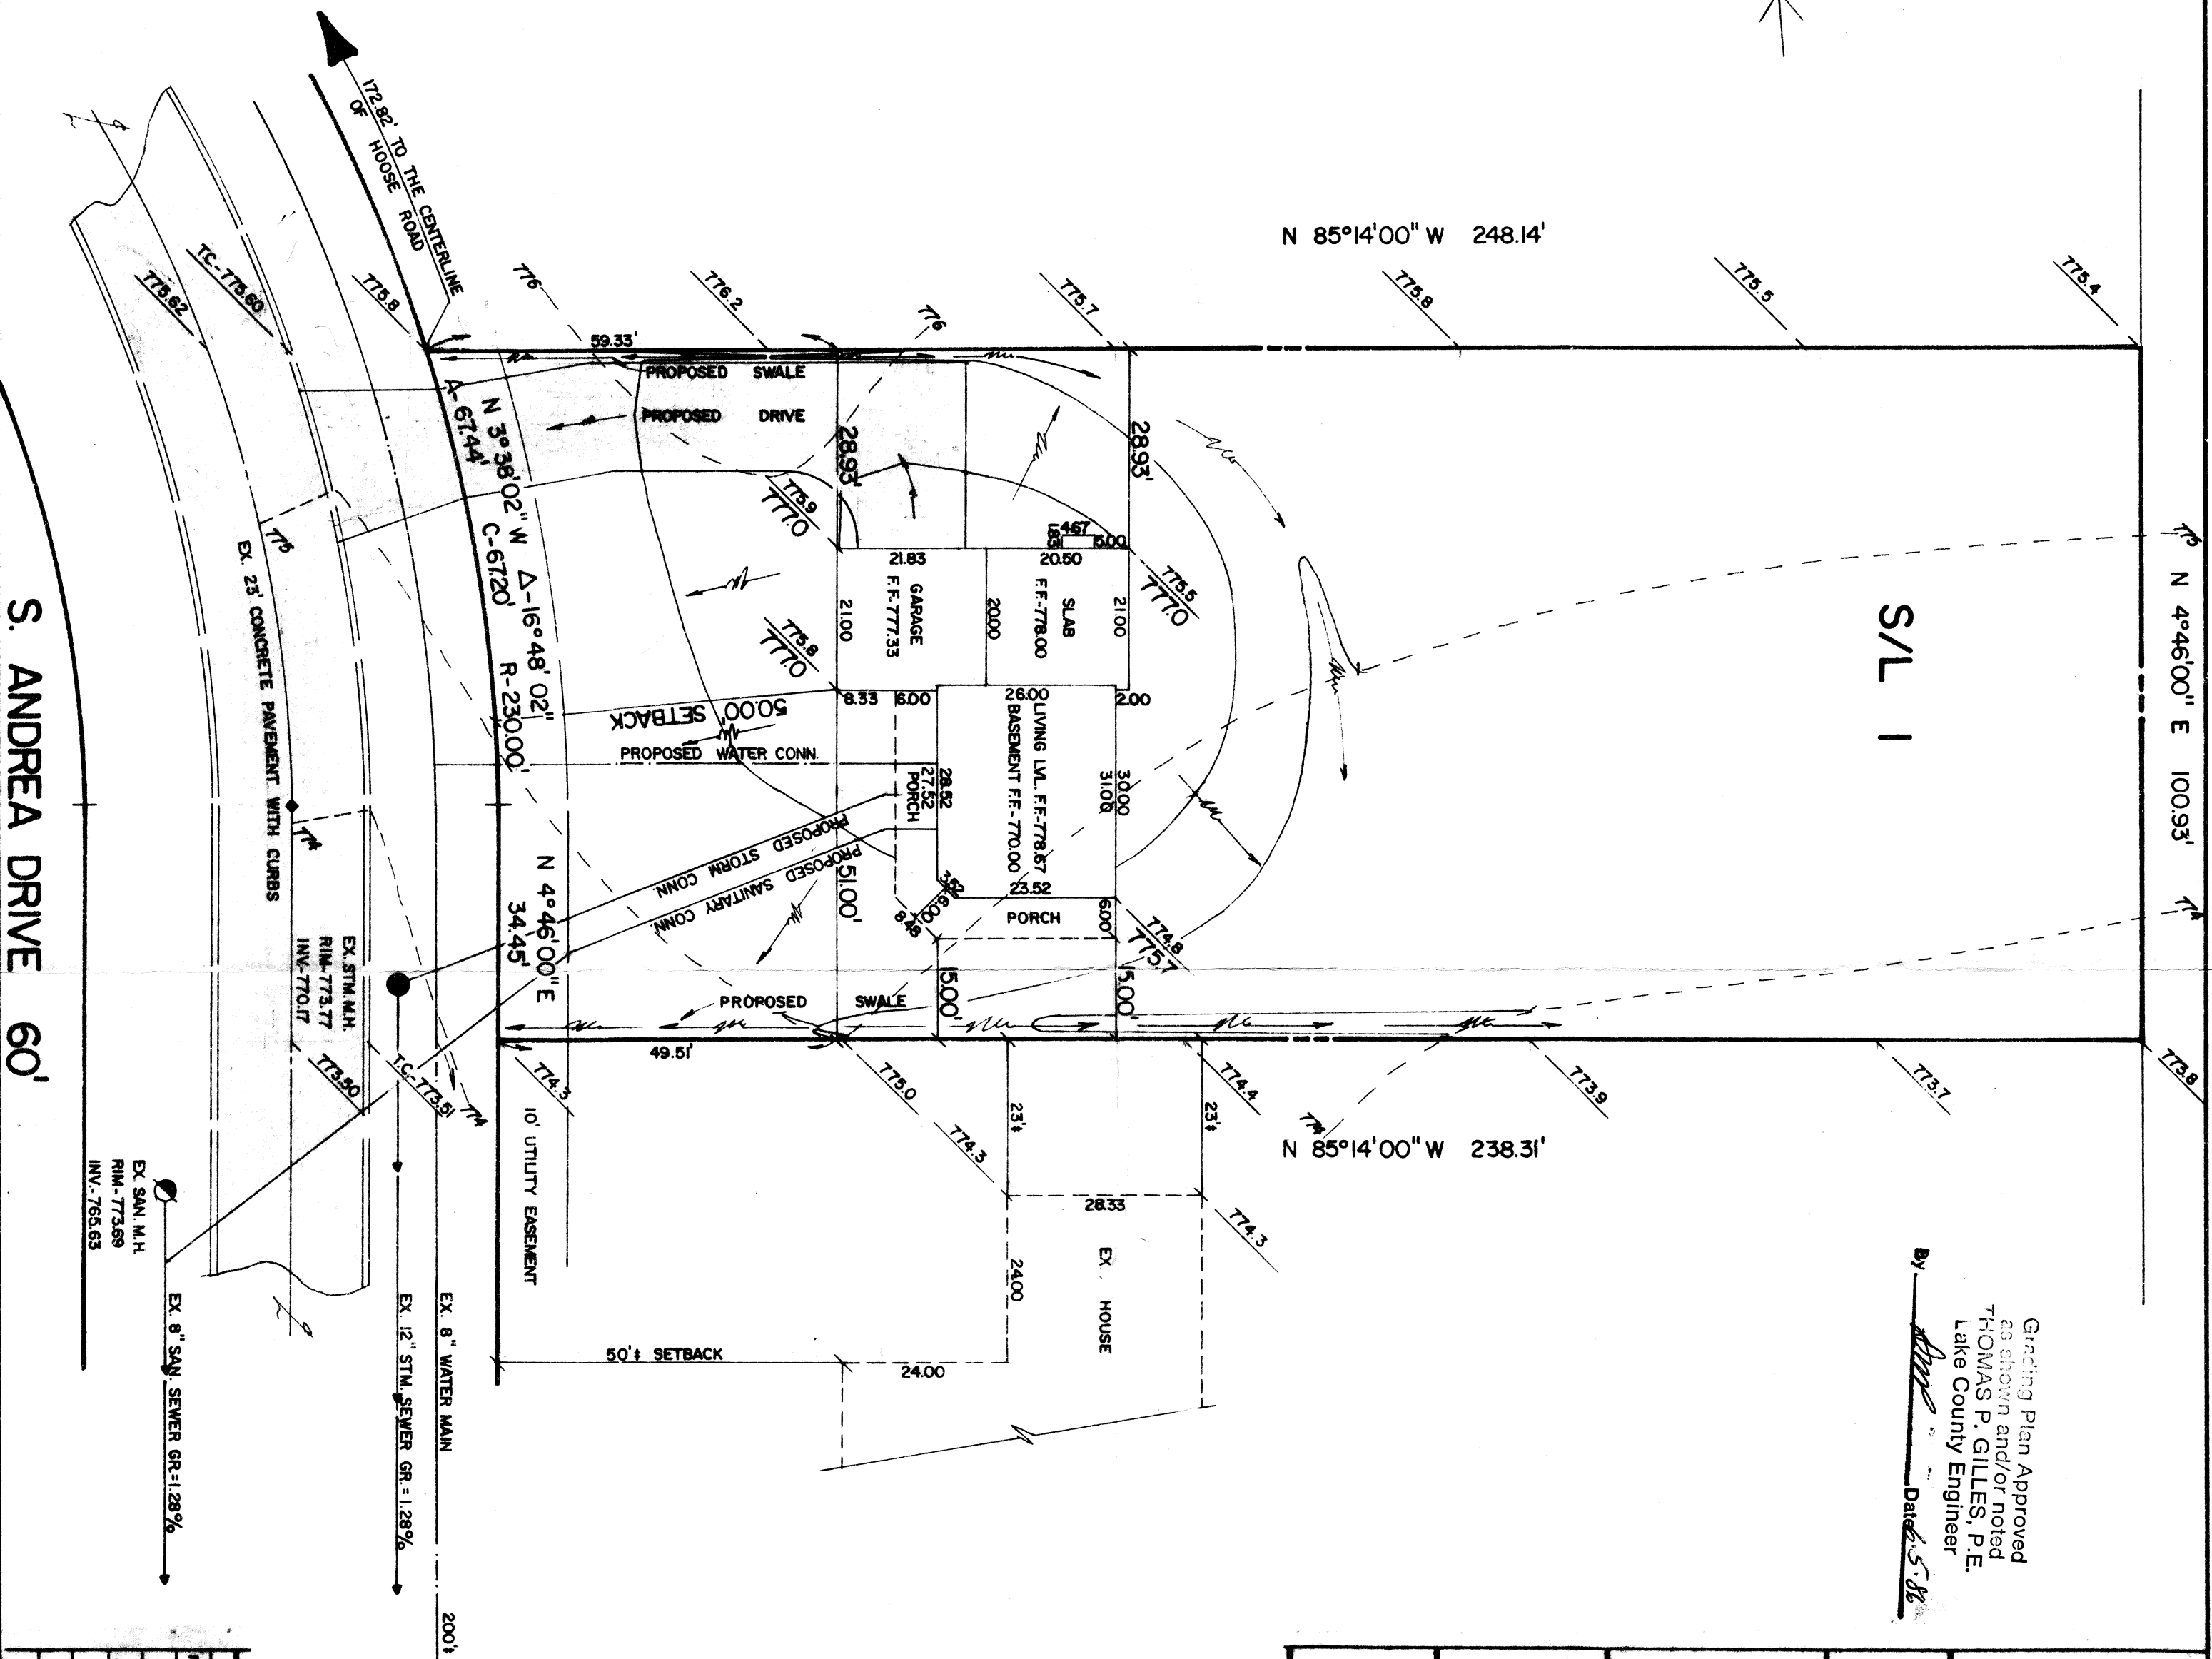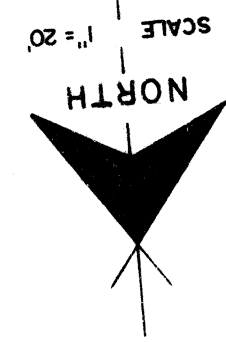

ZONING PERMIT #5239
ISSUED 6-4-86

SUBJECT TO APPROVAL BY:
Lake County Building Dept. ☐
Lake County Eng. Dept. ☒
Lake County Planning Comm. ☐
Lake County Eng. Dept. ☒
Lake County Health Dept. ☐
Ten & Maden

BENCHMARK - TOP OF HYDRANT
ELEVATION 724.69

PLAN PREPARED BY:
DEBEVEC • SALO & ASSOCIATES, INC.
125 E. ERNE ST. PAINESVILLE, OHIO

REVISIONS			PLAN PREPARED BY:		
NO.	DATE	BY	DRAWN BY	SCALE	PHONE NO.
1			L.L.	1" = 20'	352-9250
2			CHK'D.	DATE	DRAWING NO.
3				MAY 1986	
4					
5					
6					