



CONCORD TOWNSHIP ZONING OFFICE

PERMIT # 1103-11392


ISSUED 11/25/02 REV 12/24/03

SUBJECT TO APPROVAL BY:

- ☒ Lake Co. Survey Engineer
☒ Lake Co. Eng. Dept.
☒ Lake Co. Planning Comm.
☒ Lake Co. Building Dept.
☒ Lake Co. Soil & Water Cons. Dist.

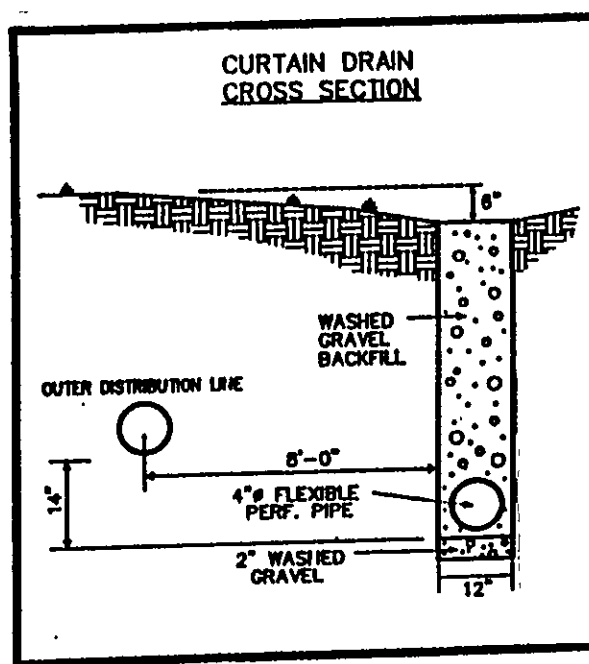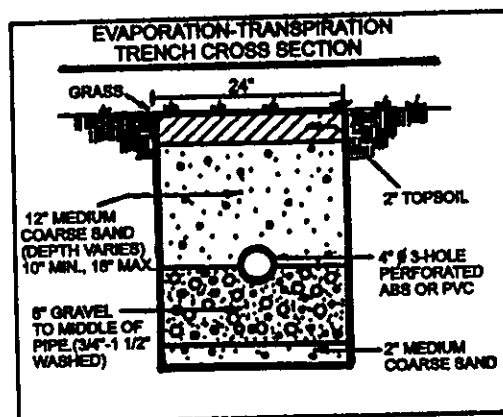

ELLISON CREEK SUBDIVISION
PHASE 3
VOLUME 44 PAGE 2

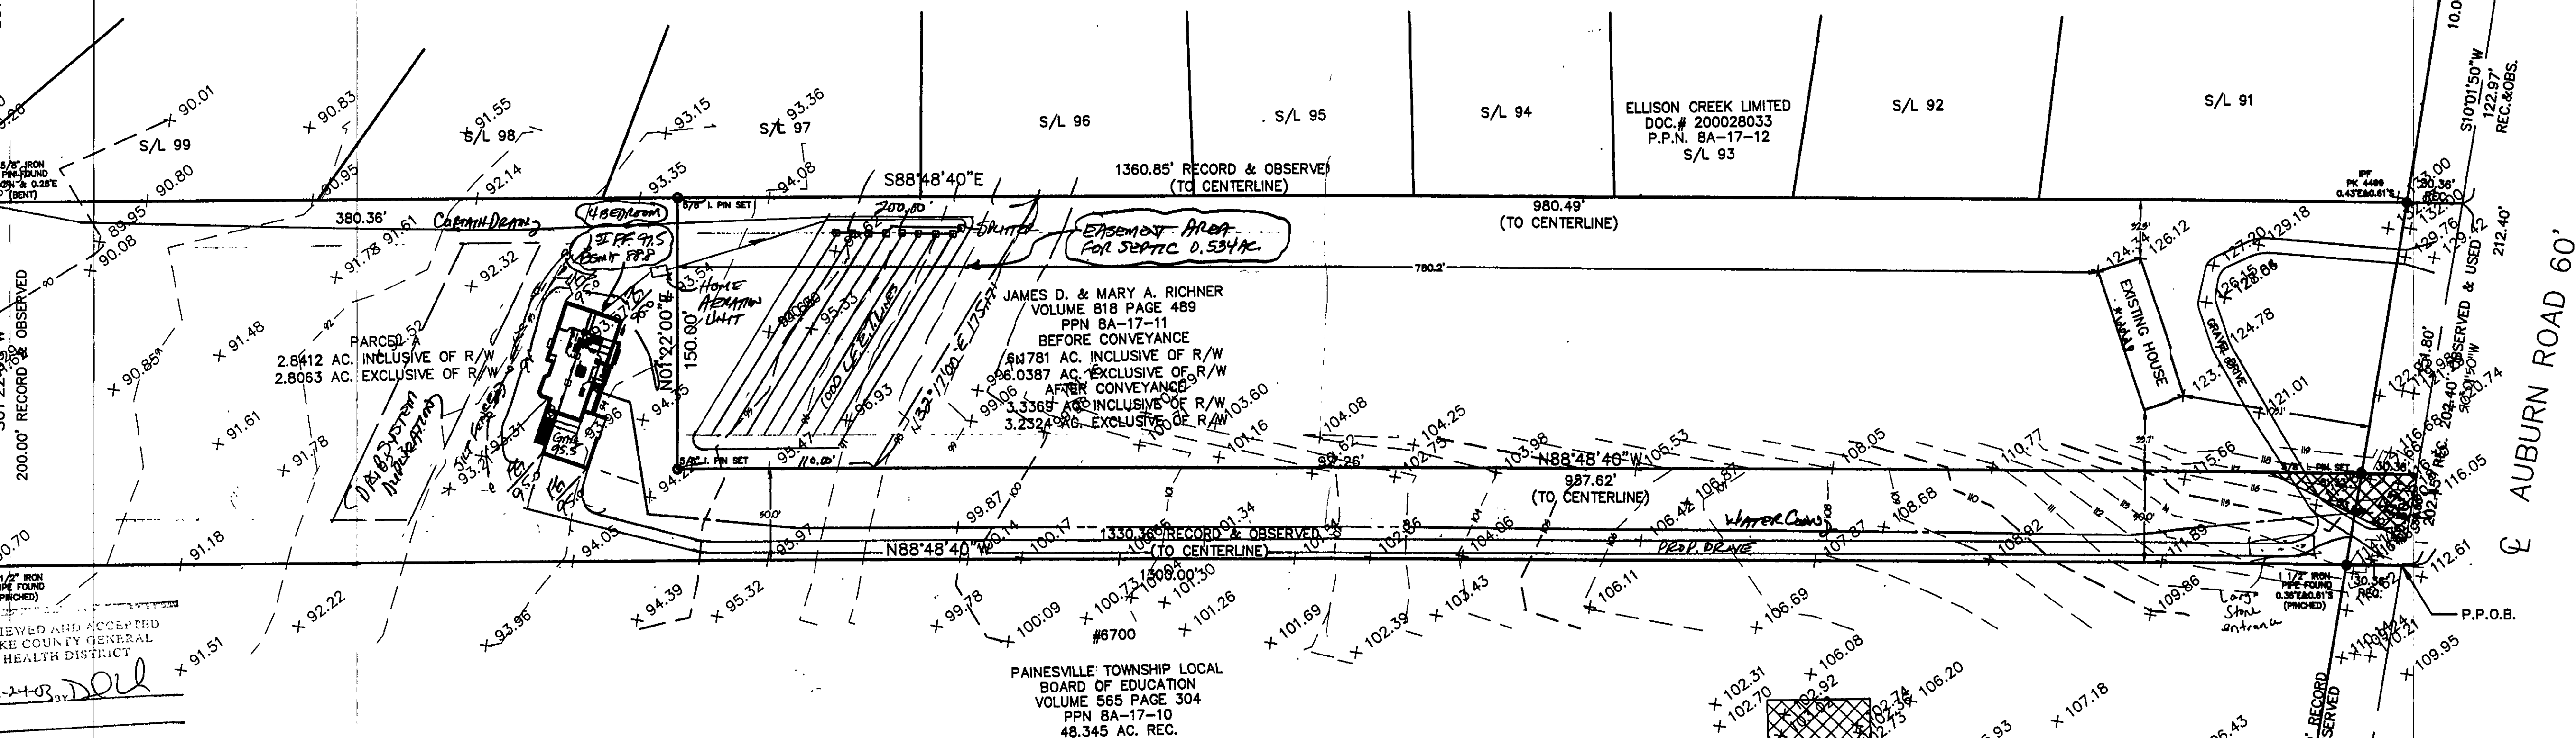

SITE PLAN CERTIFICATION


"I, the undersigned, hereby certify that this topography, indicated by contours and elevations shown hereon, represent an actual field survey made by me on Nov. 17, 2003 and that the elevations were taken at appropriate intervals and that, as of the date, they existed as indicated hereon.

I further certify that this plan was prepared by me from an actual boundary survey and iron pins were found or set at the property corners and all of which is correct to the best of my knowledge and belief.

Harry S. Jones, Jr.
Harry S. Jones, Jr.

#6343
P.S. #6343

NOTE: ALL IRON PINS SET ARE
5/8" X 30" AND CAPPED
BABCOCK, JONES & ASSOC.

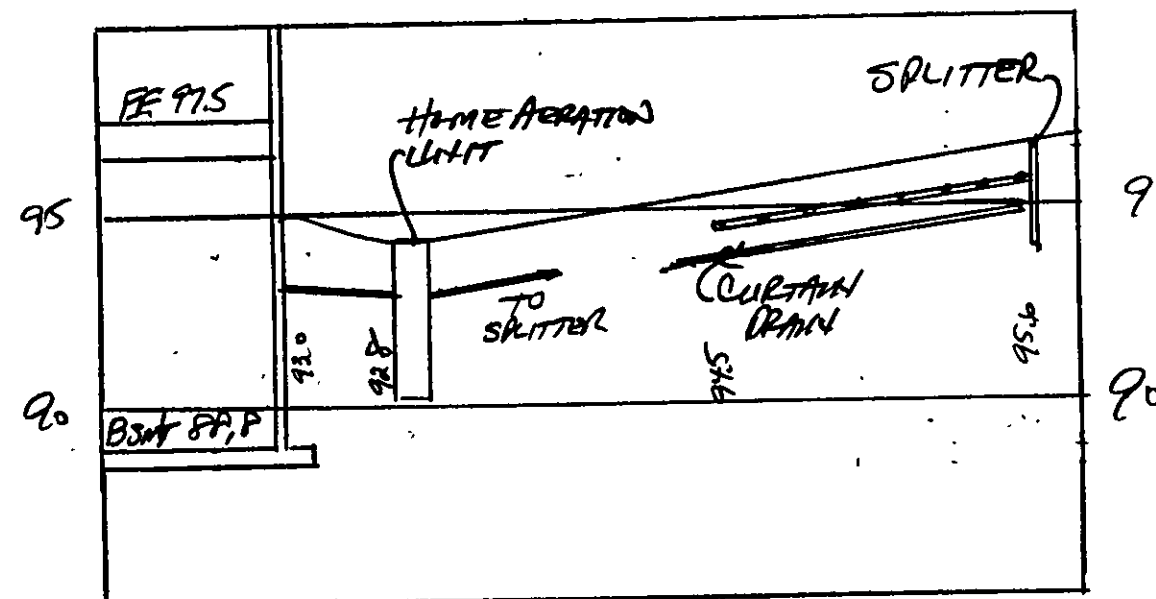

HYDRAULIC PROFILE
HORIZ 1" = 30' VERT 1" = 5'

EXISTING UTILITIES NOTE:
THE SIZE AND LOCATION, BOTH HORIZONTAL AND VERTICAL
OF THE UNDERGROUND UTILITIES SHOWN HEREON, HAVE BEEN
OBTAINED BY A SEARCH OF AVAILABLE RECORDS.
VERIFICATION BY FIELD OBSERVATION HAS BEEN CONDUCTED
WHERE PRACTICAL, HOWEVER, BABCOCK, JONES AND ASSOCIATES
INC. DOES NOT GUARANTEE THE COMPLETENESS NOR ACCURACY
THEREOF.

DESCRIPTION	DATE	BY	CHK'D
Survey	12-9-03	HJ	HJ
	12-23-03	HJ	HJ



BABCOCK, JONES AND ASSOCIATES, INC
CIVIL ENGINEERS - SURVEYORS - LAND PLANNERS
PAINESVILLE OHIO 44077

DATE	11/19/03
DESIGN BY	HJ
DRAWN BY	NS
APPROVED BY	HJ

SITE PLAN
FOR

MIKE RICHNER

CONCORD TOWNSHIP LAKE COUNTY STATE OF OH