

- GENERAL NOTES:**
1. DRIVEWAY APRON TO BE 6" THICK
 2. BENCHMARK - RIM OF EXISTING SANITARY MANHOLE NEAR SE PROPERTY CORNER. ELEV. = 816.29

LEGEND


EXISTING CONTOUR
PROPOSED CONTOUR
EXISTING ELEVATION
PROPOSED ELEVATION

CERTIFICATION

"I, THE UNDERSIGNED HEREBY CERTIFY THAT THIS TOPOGRAPHY INDICATED BY IT CONTOURS AND ELEVATIONS SHOWN HEREON REPRESENTS AN ACTUAL SURVEY MADE BY ME ON THE 13th DAY OF NOV. 1991 AND THE ELEVATIONS WERE TAKEN AT APPROPRIATE INTERVALS AND AS OF THAT DAY THEY EXISTED AS INDICATED HEREON.

"I HEREBY CERTIFY THAT THIS PLAN WAS PREPARED BY ME AND IS CORRECT TO THE BEST OF MY KNOWLEDGE"

RUDY YEAGER
VOL. 367, PG. 796

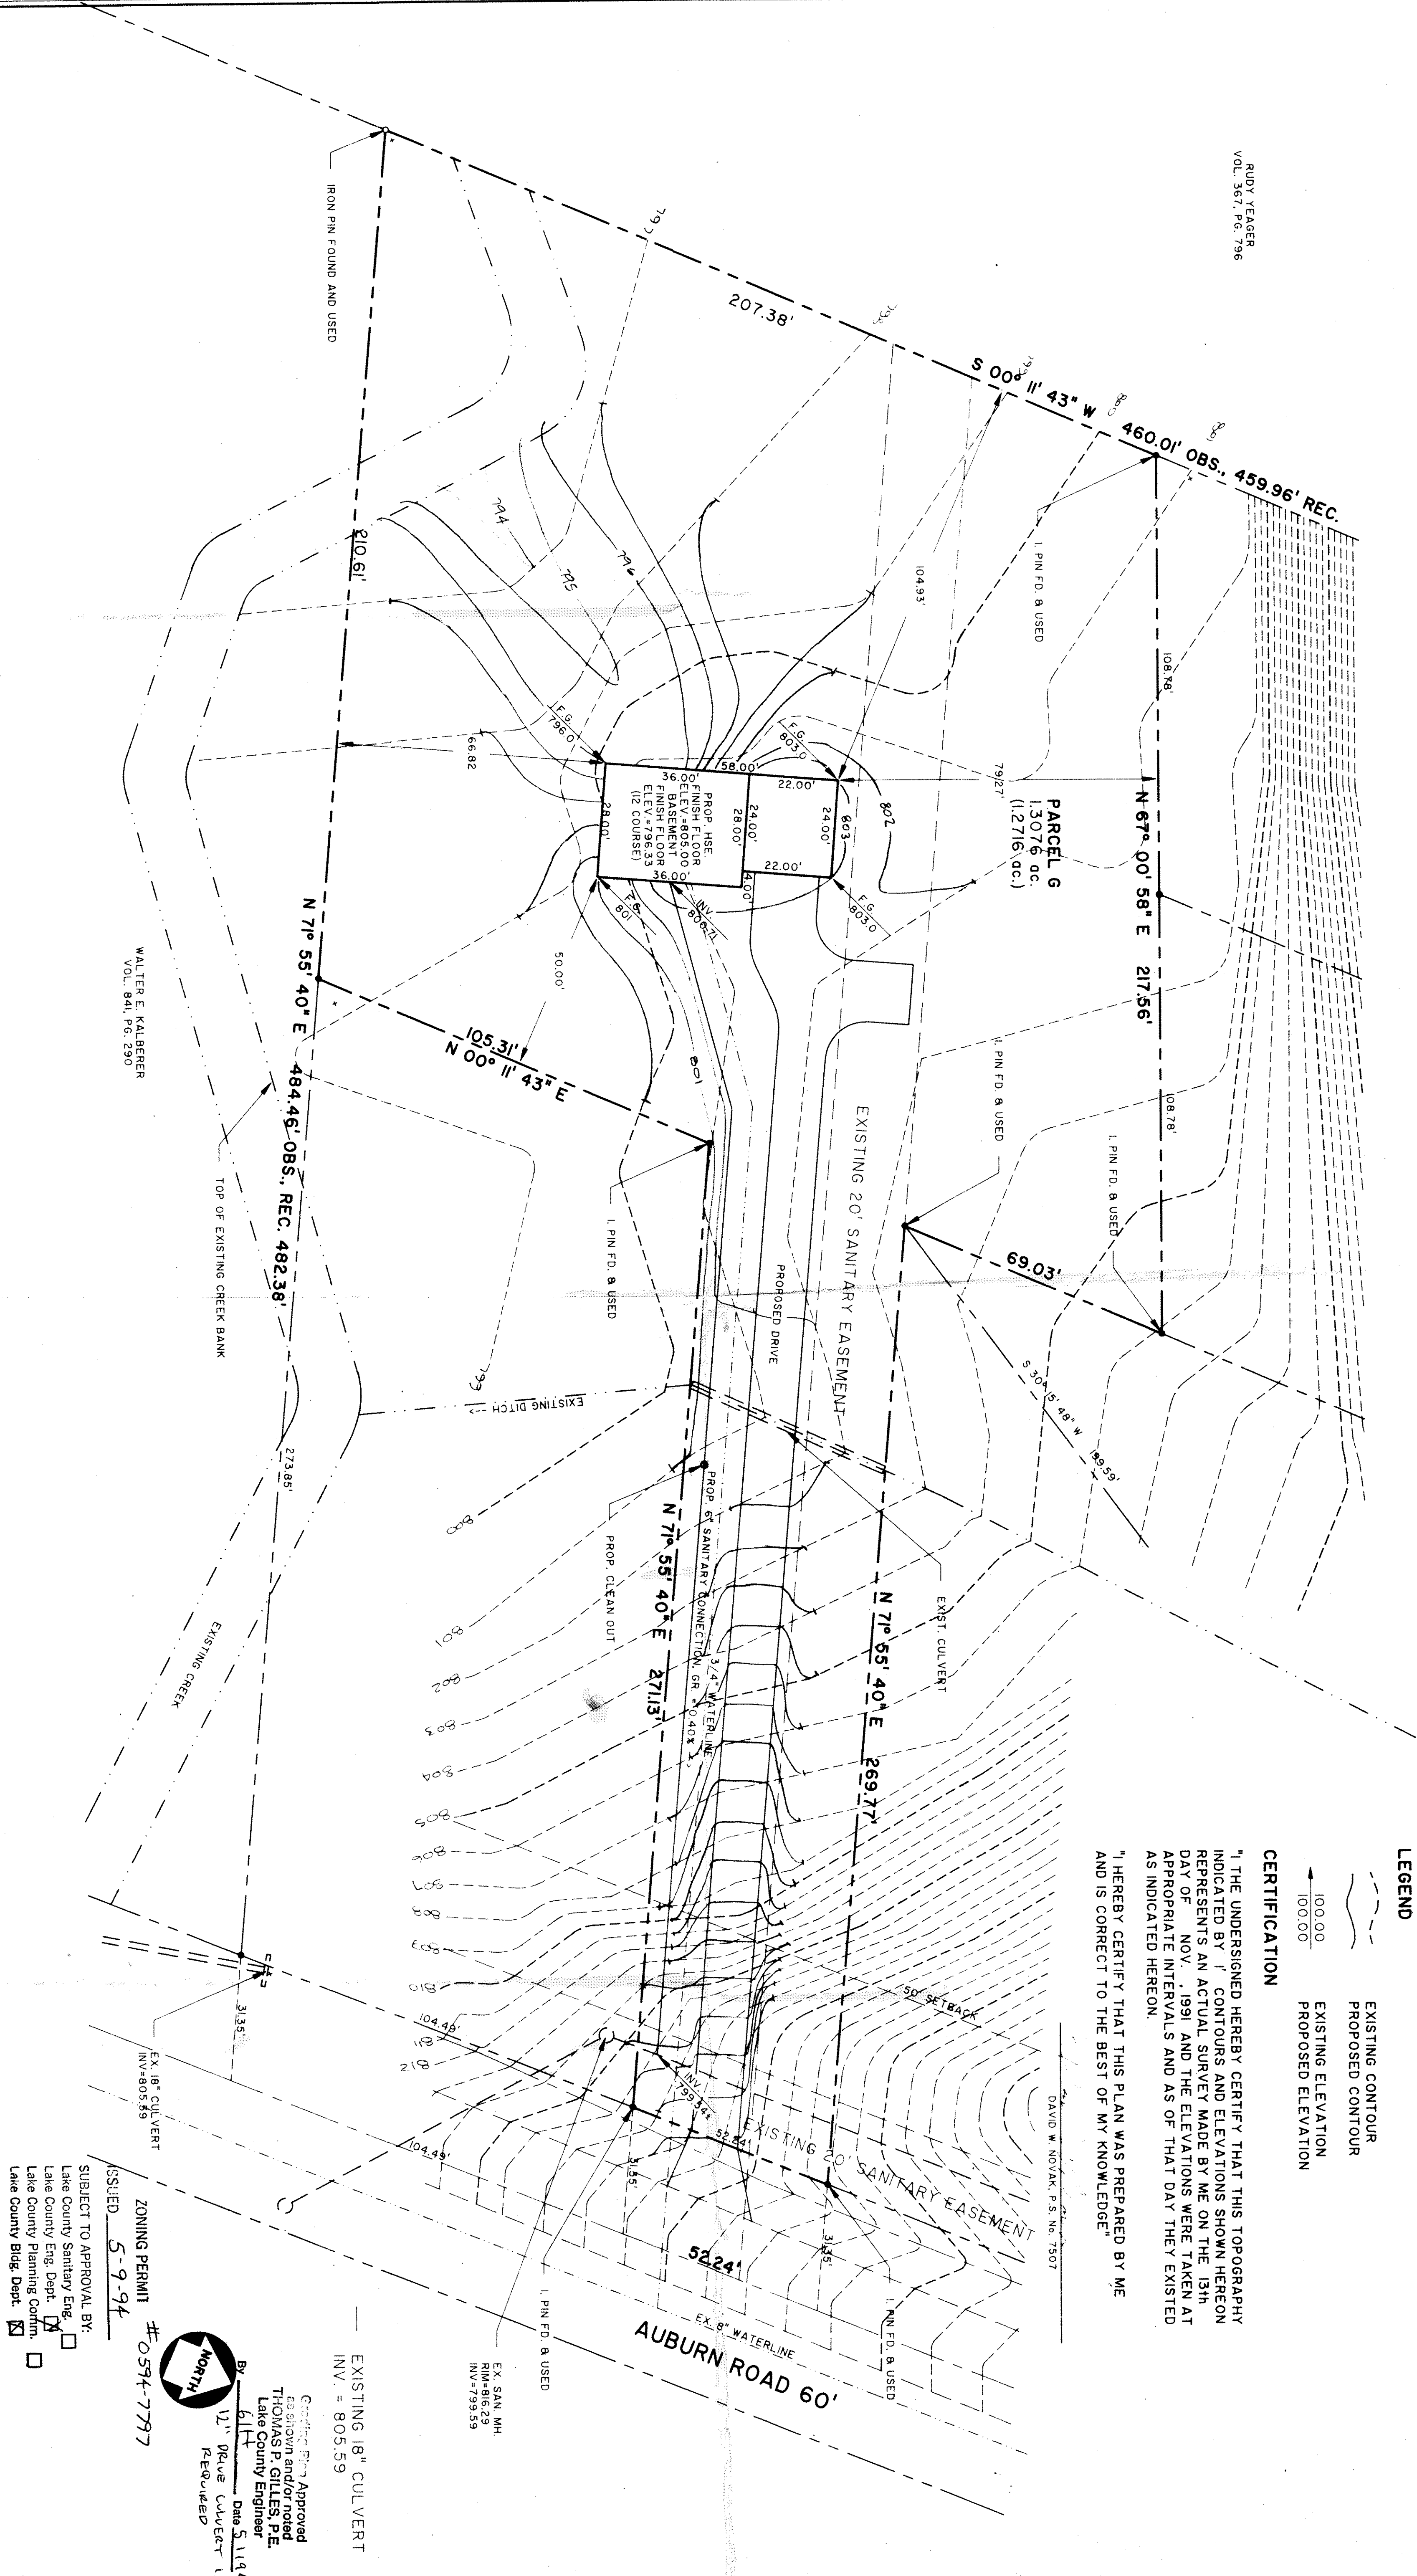

SUBJECT TO APPROVAL BY:
☐ Lake County Sanitary Eng.
☐ Lake County Eng. Dept.
☐ Lake County Planning Comm.
☒ Lake County Bldg. Dept.

ZONING PERMIT # 0594-7797
ISSUED 5-9-94




By 6/1/94 Date 5/11/94
12" Drive Culvert is
REQUIRED

EXISTING 18" CULVERT
INV. = 805.59

Grading Plan Approved
as shown and/or noted
THOMAS P. GILLES, P.E.
Lake County Engineer

REV.	DESCRIPTION	DATE	BY	CHK'D.

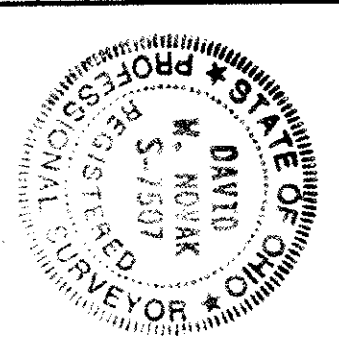

Himebaugh and Novak
Surveyors and Site Consultants
8663 Tyler Boulevard
Mentor, Ohio 44060-4346
(216) 974-7670, (216) 255-5900 FAX

LITTLE MOUNTAIN HOMES, INC.
1447 NORTH RIDGE ROAD, PAINESVILLE, OH 44077

DATE	MAY 5, 1994
DRAWN BY	D. W. NOVAK
CHECKED BY	DWN
APPROVED BY:	
F.B. No.	
PG.	

SITE PLAN
1.3076 AC. PARCEL LOCATED 343.27' SOUTH
OF THE INTERSECTION OF SPEAR ROAD, CONCORD TWP.

SCALES:	
HORIZ. 1" = 20'	
VERT. 1" = 2'	
CONTRACT NO.	
SHEET NO.	94-038
OF	