

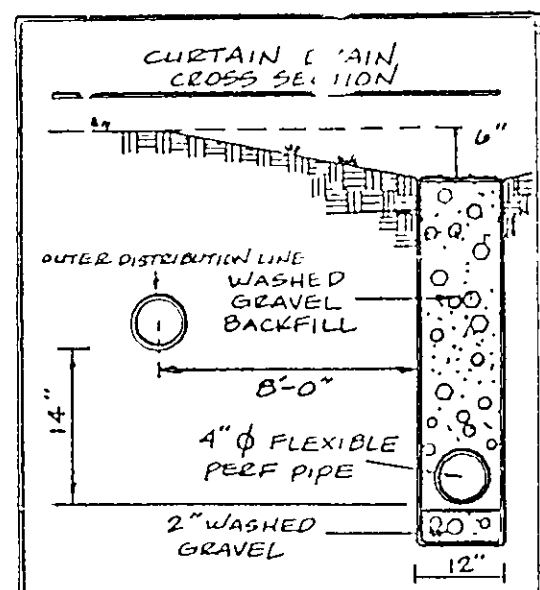
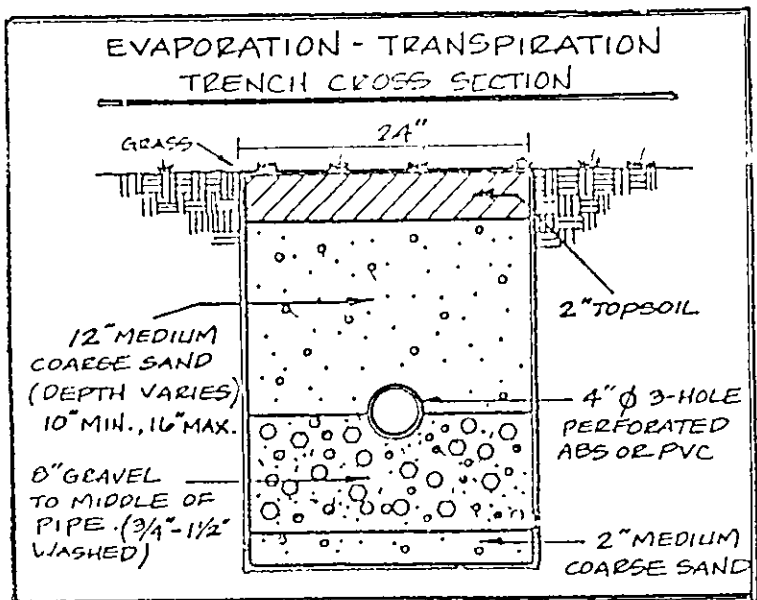


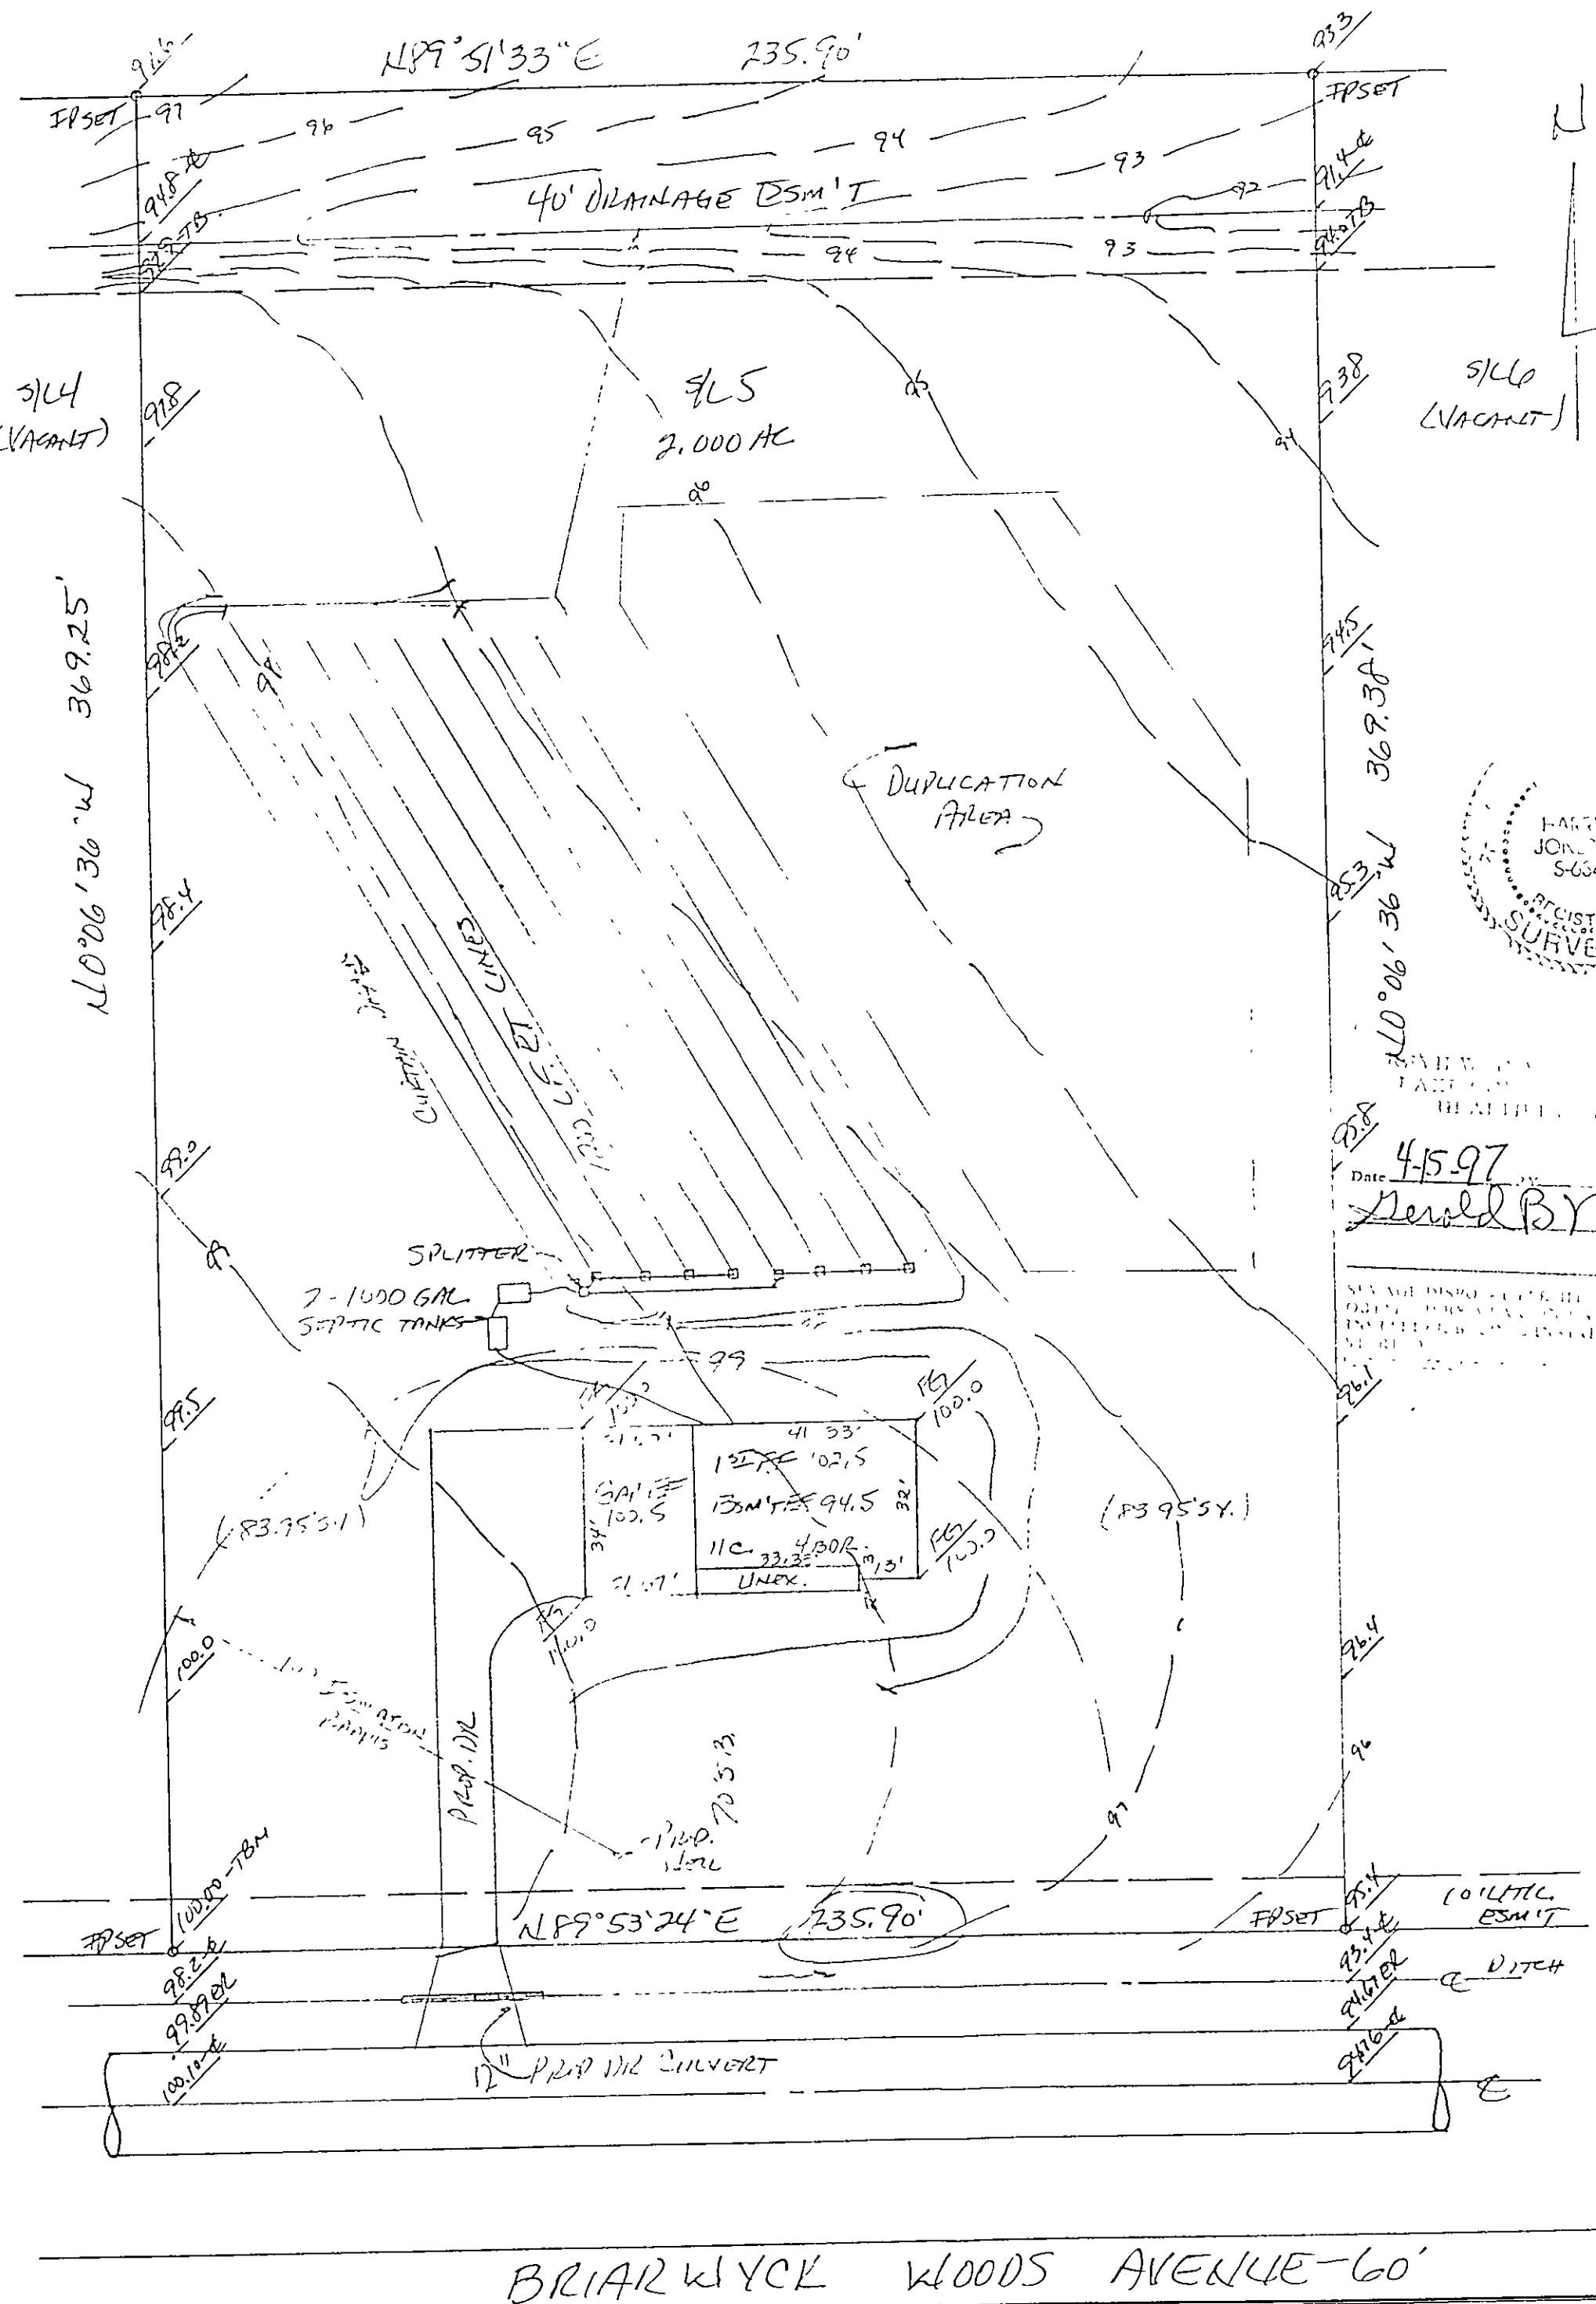

EXISTING PERMIT #0497-SGS-7
 ISSUED 4/8/97
 SUBJECT TO APPROVAL BY:
 L. J. GILLES, P.E.
 L. J. GILLES, P.E.
 L. J. GILLES, P.E.

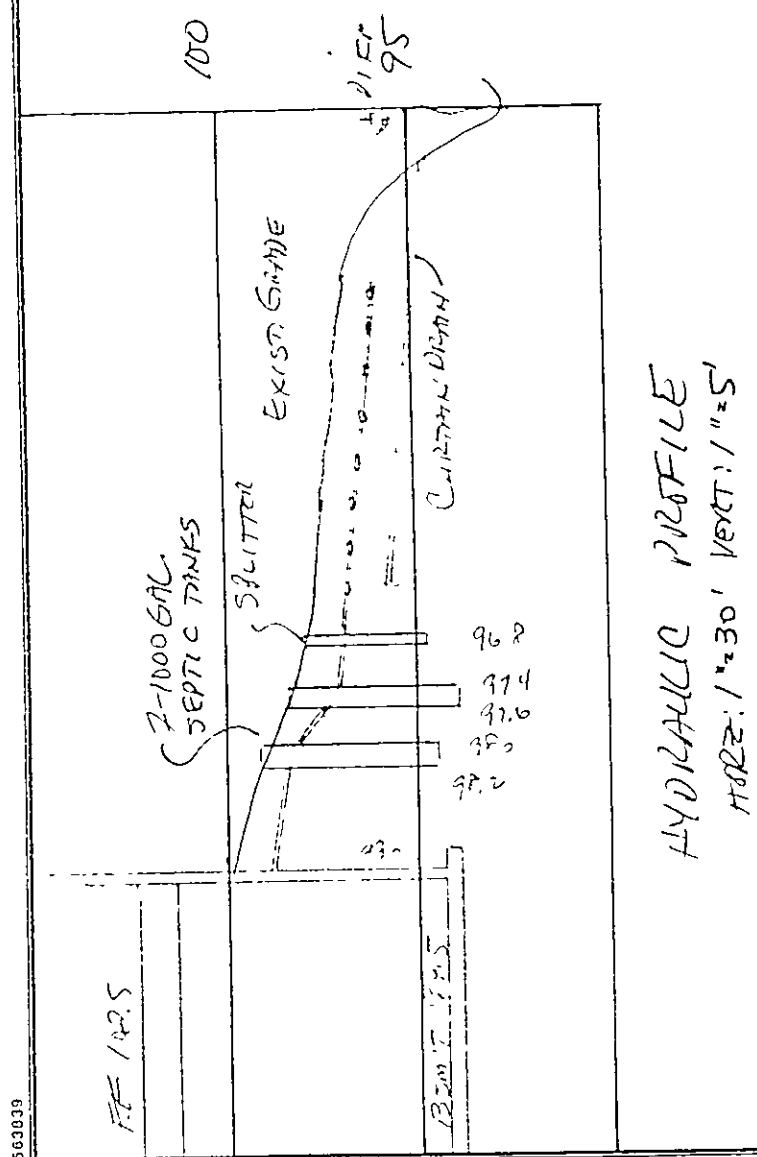

SITE PLAN
 Concord Township, LAKE COUNTY, OHIO

OWNER: WILSHIRE HOMES
 CLIENT: WILSHIRE HOMES
 ADDRESS: BRIDLEWYCK WOODS STREET: BRIDLEWYCK WOODS CITY: BRIDLEWYCK WOODS ZIP: 43084
 SUBDIVISION: BRIDLEWYCK WOODS NAME: BRIDLEWYCK WOODS LOT: 15-46 TRACT: 15-46
 SUBLOT NO.: 5 VOLUME: 15-46 PAGE: 15-46
 PERM. PARCEL NO.: 15-46 STREET: BRIDLEWYCK WOODS

LEGEND

SANITARY MANHOLE	----- (1)	WATER VALVE (GAS)	----- (1)
STORM MANHOLE	----- (1)	WATER METER (GAS)	----- (1)
INLET OR CATCH BASIN	----- (1)	AS BUILT ELEVATION	100.0
HYDRANT	----- (1)	INDICATES DIRECTION OF SURFACE DRAINAGE	100.0
EXISTING CONTOURS	----- (1)		
PROPOSED CONTOURS	----- (1)		
EXIST. ELEV.	100.0	PROP. ELEV.	100.0

REMARKS

ALL BOUNDARY DATA SHOWN WAS OBTAINED FROM (DEEDS, RECORDED SUBDIVISION PLAT OR OTHER PUBLIC RECORDS)

LOCATIONS AS SHOWN OF ADJACENT WELLS AND SEPTIC TANKS OBTAINED FROM LAKE COUNTY HEALTH DEPARTMENT

DESIGN CERTIFICATION

THIS PLAT WAS PREPARED BY ME, AND IS CORRECT TO THE BEST OF MY KNOWLEDGE AND BELIEF.

NAME: THOMAS P. GILLES SURVEYOR REGISTRATION NO.: 4343

CHECK LIST

NO. OF BEDROOMS	WATER MAIN SIZE, LOCATION
DIMENSIONS	SAN. SEWER SIZE % GR. LOC.
BEARINGS	SAN. MH. CAST. ELEV. INV. ELEV.
TIE TO NEAREST STREET	SAN. CONN. SIZE, LOC. DEPTH
SUBLOT NO. PARCEL NO.	STORM SEWER SIZE % GR. LOC.
SURROUNDING OWNERS	STORM MH. CAST. ELEV. INV. ELEV.
BLDG. DIMENSIONS FIN. GR.	PAVT TYPE GRADE CURBS
BLDG. TIES FL'R. GRADES	GAS LINE LOC. SIZE PRESSURE
APRON TYPE WIDTH THICKNESS	SEPTIC TANK LOCATION & DUPLICATION AREA
SEWER TYPE WIDTH THICKNESS	WELL LOCATION
CULVERT TYPE DIA., LENGTH	ISOLATION RADIUS FROM WELL
ROCK OUTCROPPINGS	

REVISIONS

NO.	DATE	BY
1		
2		
3		
4		
5		

PLAN PREPARED BY:
 BABCOCK • JONES & ASSOCIATES, INC.
 PAINESVILLE, OHIO

DRAWN BY: HT **SCALE:** 1" = 30' **PHONE NO.:** 357-1811
CHK'D.: HT **DATE:** 4/2/97 **DRAWING NO.:** 91-180-5
CREW CHIEF: WJ **APP'D.:** HT

"AS BUILT" CERTIFICATION

I, HEREBY CERTIFY THAT THE CIRCLED GRADES ARE EXISTING FINISH GRADES CHECKED IN THE FIELD ON 4/2/97, 1997 AND ARE CORRECT TO THE BEST OF MY KNOWLEDGE AND BELIEF.

REGISTERED SURVEYOR REG NO. 4343

TBM - TOP OF IRON PIN @ S.W. COR. 9/5
 ELEV. = 100.00

Grading Plan Approved as shown and/or noted
 THOMAS P. GILLES, P.E.
 Lake County Engineer

"I, the undersigned, certify that this topographic map or plan was made by me on the 1st DAY OF APRIL, 1997 and that the same were taken at appropriate intervals and that as of that date they existed as indicated hereon."

By THOMAS P. GILLES Date 4/2/97
 Name THOMAS P. GILLES Reg. No. 4343

