
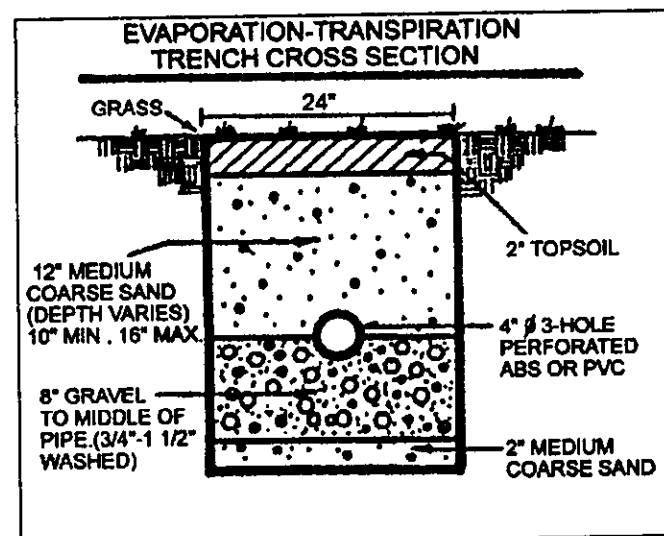
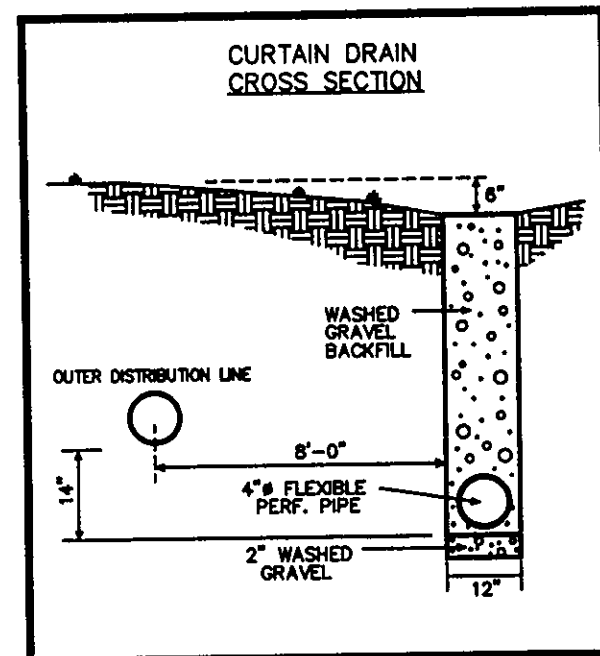


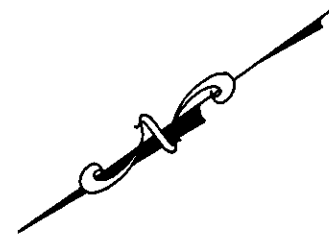

ZONING PERMIT #0299-9294

ISSUED 2/19/99

SUBJECT TO APPROVAL BY:
Lake County Sanitary Eng. ☐
Lake County Eng. Dept. ☒
Lake County Planning Comm. ☐
Lake County Bldg. Dept. ☒

REVIEWED AND ACCEPTED
LAKE COUNTY GENERAL
HEALTH DISTRICT

Date 2-24-99 BY D.O.L.


SEWAGE DISPOSAL PERMIT MUST BE
OBTAINED FROM LAKE COUNTY LICENSED
INSTALLER BEFORE INSTALLATION IS
STARTED

"I, the undersigned hereby certify that
this topography indicated by 6", 1", or 2"
contours, and elevations shown hereon
represent an actual field survey made by
me on the 15th day of Jan., 1999
and that the elevations were taken at
appropriate intervals and that as of that
date they existed as indicated hereon."

Name William C. Babcock P.S. #6528
Reg. No.

Grading Plan Approved
as shown and/or noted
THOMAS P. GILLES, P.E.
Lake County Engineer

By TAM Date 3/2/99
MIN 12" DRIVE CULVERT

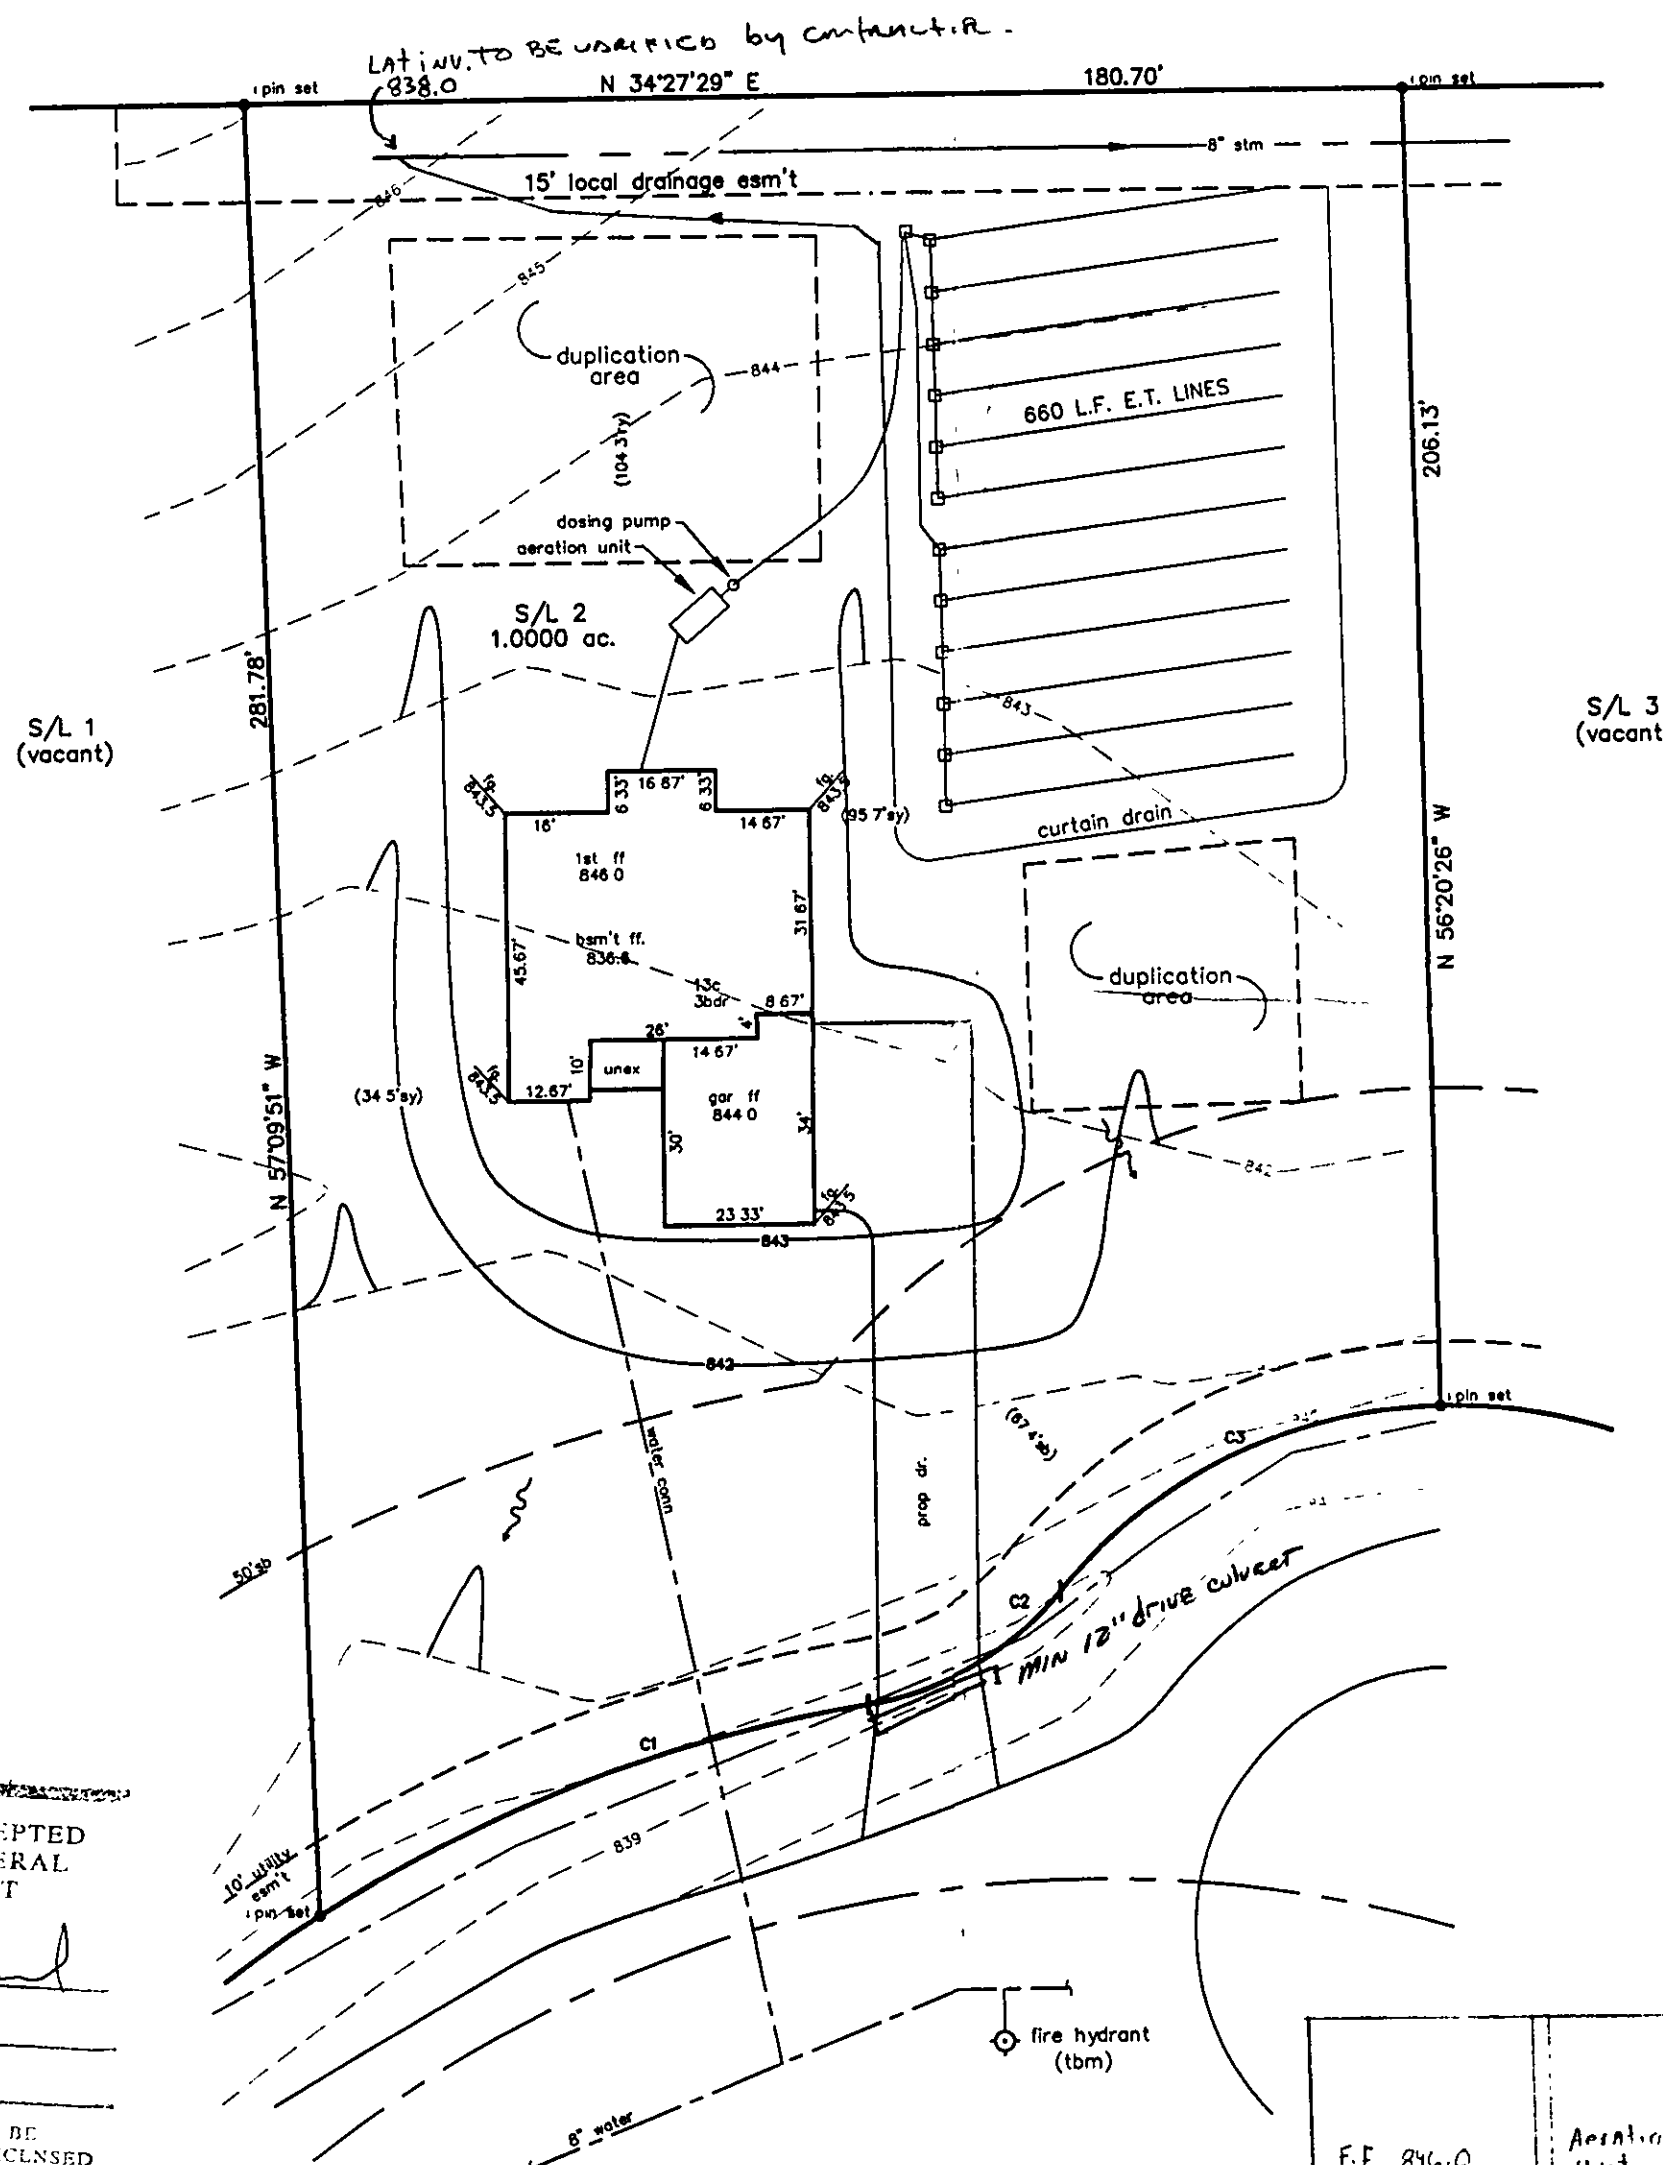

SITE PLAN

CONCORD TOWNSHIP, LAKE COUNTY, OHIO

for: KAY HOMES

CLIENT		OWNER	
ADDRESS	STREET	CITY	ZIP
ALEXANDER'S CROSSING		TRACT	STREET
SUBDIVISION 28-31	NAME	LOT	
VOL-PG. 2	BRIDLEWOOD DR.	VOL-PG.	PERM. PARCEL NO.
SUBLOT NO.	STREET		

LEGEND

SANITARY MANHOLE	---○---
STORM MANHOLE	---●---
INLET OR CATCH BASIN	---□---
HYDRANT	---◇---
EXISTING CONTOURS	---○---
PROPOSED CONTOURS	---○---
EXIST. ELEV. 100.0	PROF. ELEV. 100.0
AS BUILT ELEVATION	INDICATES DIRECTION OF SURFACE DRAINAGE

REMARKS

ALL BOUNDARY DATA SHOWN WAS OBTAINED FROM (DEEDS, RECORDED
SUBDIVISION PLAT OR OTHER PUBLIC RECORDS)

LOCATIONS AS SHOWN OF ADJACENT WELLS AND SEPTIC TANKS OBTAINED FROM
LAKE COUNTY HEALTH DEPARTMENT

DESIGN CERTIFICATION

THIS PLAT WAS PREPARED BY ME, AND IS CORRECT
TO THE BEST OF MY KNOWLEDGE AND BELIEF.

NAME William C. Babcock P.S. #6528
SURVEYOR REGISTRATION NO.

CHECK LIST

NO. OF BEDROOMS	WATER MAIN SIZE, LOCATION
DIMENSIONS	SAN. SEWER SIZE & GR. LOC.
BEARINGS	SAN. MH. CAST. ELEV. INV. ELEV.
TIE TO NEAREST STREET	SAN. CONN. SIZE, LOC. DEPTH
SUBLOT NO. PARCEL NO.	STORM SEWER SIZE & GR. LOC.
SURROUNDING OWNERS	STORM MH. CAST. ELEV. INV. ELEV.
BLDG. DIMENSIONS FIN GR.	PAVT TYPE GRADE CURBS
BLDG. TIES FL'R. GRADES	GAS LINE LOC. SIZE PRESSURE
APRON TYPE WIDTH THICKNESS	SEPTIC TANK LOCATION & DUPLICATION AREA
SIDEWALK TYPE WIDTH THICKNESS	WELL LOCATION
CULVERT TYPE DIA. LENGTH	ISOLATION RADIUS FROM WELL
ROCK OUTCROPPINGS	

REVISIONS			PLAN PREPARED BY:	
NO.	DATE	BY	BABCOCK · JONES & ASSOCIATES, INC.	
			PAINESVILLE, OHIO	
1			DRAWN BY T.R.	SCALE 1"=30'
2			CHK'D. H.J.	DATE 1/18/99
3			CREW CHIEF K.J.	APP'D H.J.
4				PHONE NO. 440-357-1811
5				DRAWING NO. 98-263-2

"AS BUILT" CERTIFICATION

I, HEREBY CERTIFY THAT THE CIRCLED GRADES ARE EXISTING
FINISH GRADES CHECKED IN THE FIELD ON _____, 19____
AND ARE CORRECT TO THE BEST OF MY KNOWLEDGE AND BELIEF.

REGISTERED SURVEYOR

REG. NO.

TBM-TOP OF HYDRANT
ELEV.=841.71

C1: R=230.00' L=91.91' C=91.30' D=22°53'47" S14°28'00"W
C2: R=50.00' L=35.40' C=34.67' D=40°34'11" N05°37'49"W
C3: R=80.00' L=67.52' C=65.53' D=48°21'18" S07°42'22"W

Hydraulic Profile
hor: 1"=30' vert: 1"=5'

