

SITE PLAN

FOR THE

M.M. BOGART DEVELOPMENT CORP.

LAKE COUNTY, OHIO

CONCORD TOWNSHIP

AS BUILT CERTIFICATION

I hereby certify that the "as built" grades and other information provided are existing and checked in the field on 10- and are correct to the best of my knowledge and belief.

David K. Mostoller

R.S. #6849

I hereby certify that this plan is an accurate and true representation of said property.

David K. Mostoller

R.S. #6849



- LEGEND
- SANITARY MANHOLE
 - STORM MANHOLE
 - INLET OR CATCH BASIN
 - HYDRANT
 - - - - - EXISTING CONTOUR
 - - - - - PROPOSED CONTOUR
 - PROP. ELEV. 100.0
 - AS BUILT ELEVATION
 - DIRECTION OF DRAINAGE

CURVE DATA

①	RADIUS	=	870.00'
	ARC	=	134.10'
	DELTA	=	8° 49' 54"
	CHORD	=	133.87'
	CHORD BEG.	=	S 24° 36' 57" W

②	RADIUS	=	900.00'
	ARC	=	72.56'
	DELTA	=	4° 37' 08"
	CHORD	=	72.54'
	CHORD BEG.	=	S 22° 30' 34" W

③	RADIUS	=	900.00'
	ARC	=	285.45'
	DELTA	=	18° 10' 15"
	CHORD	=	284.23'
	CHORD BEG.	=	S 35° 54' 16" W

PREPARED BY:


FISHER AND ASSOCIATES INC.
ENGINEERS AND CONSULTANTS

SCALE: 1"=30' DATE: MARCH, 1990

Grading Plan Approved
as shown and/or noted
THOMAS P. GILLES, P.E.
Lake County Engineer
Date 3/23/90
By G.H.

CARRIAGE HILLS SUBDIVISION

VOL. 13 PG. 7

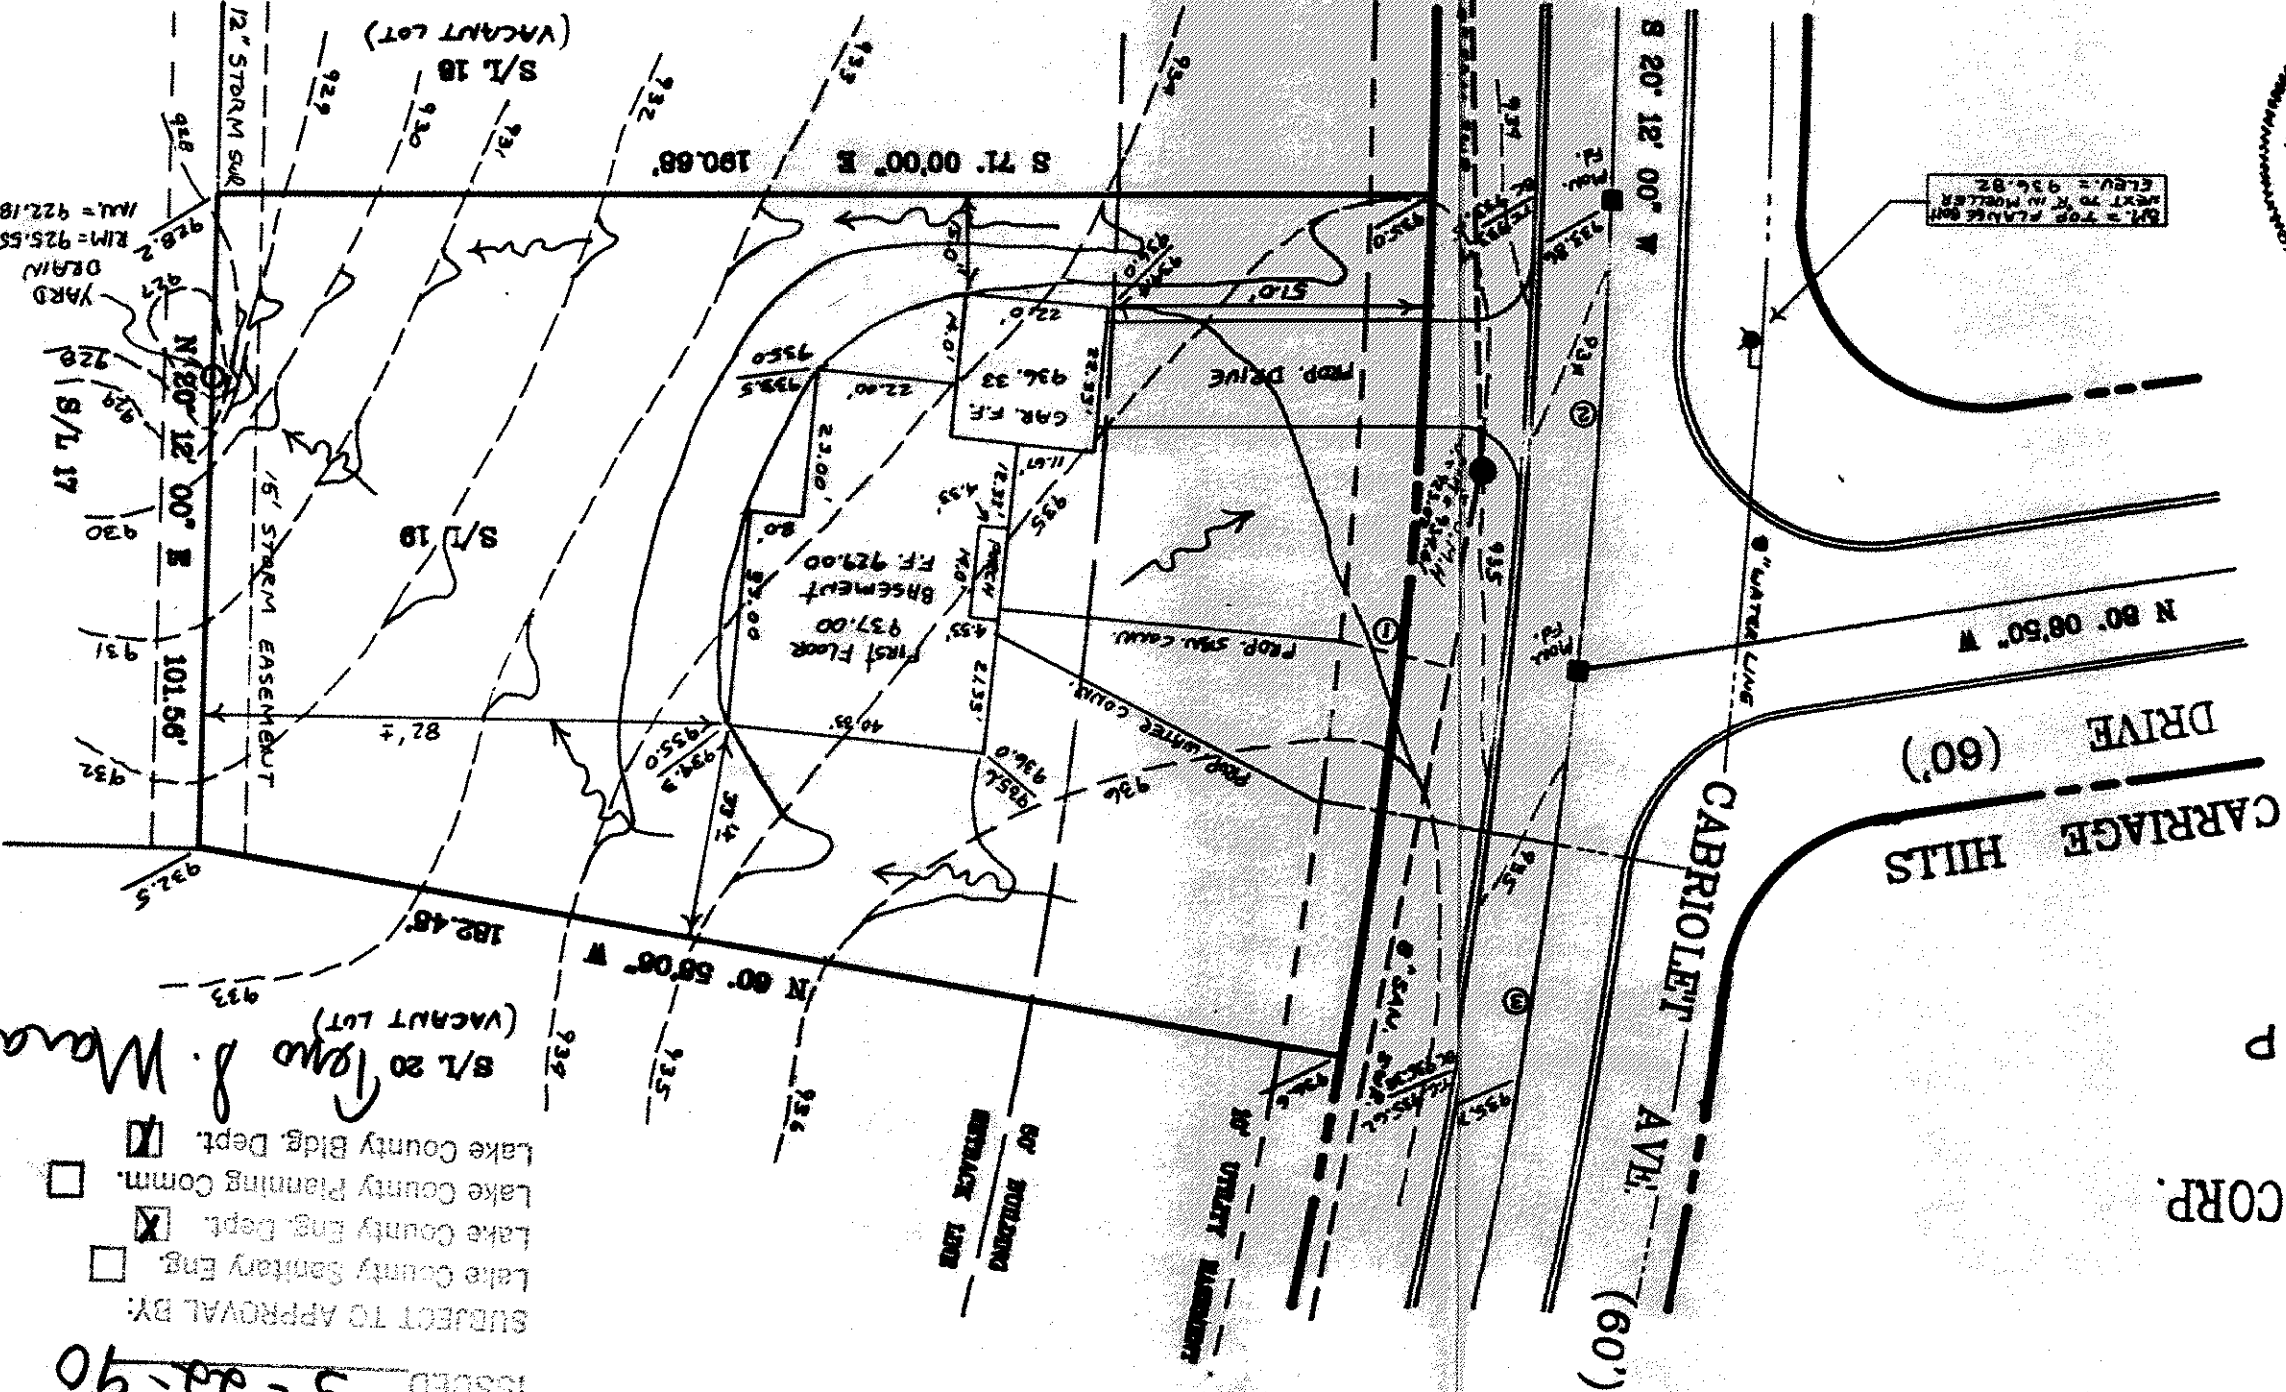

ISSUED 3-22-90

ZONING PERMIT #6385