



for: CHARLES PENGA
CLIENT
1116 PROUTY ROAD CONCORD
ADDRESS
CITY
STATE
ZIP
9
1
CONCORD
LIT. TRACT
SECTION 10
TOWNSHIP 34 N
RANGE 12 E
PAGE 1 OF 1
SHEET 1 OF 1

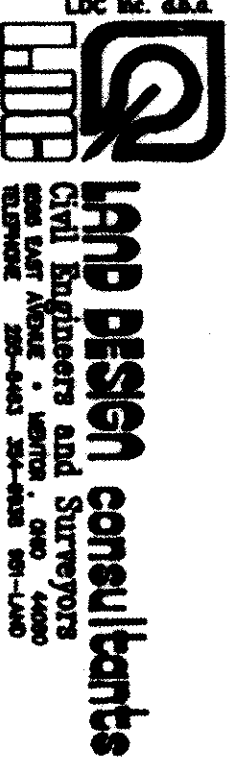

DESIGN CERTIFICATION
THIS PLAN WAS PREPARED BY ME, AND IS CORRECT TO THE BEST OF MY KNOWLEDGE AND BELIEF.

DATE: 6/19/91
BY: JAMES R. PEGORARO



CHECK LIST

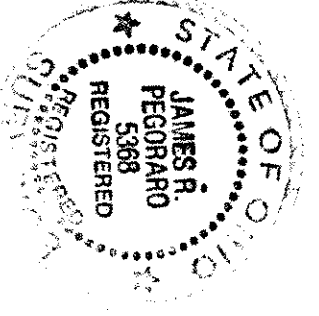


AS BUILT CERTIFICATION
I HEREBY CERTIFY THAT THE CIRCLED INFORMATION IS EXISTING AS OBTAINED ON THE SITE AND IS CORRECT TO THE BEST OF MY KNOWLEDGE AND BELIEF.

DATE	BY	SCALE
6/19/91	JR	1" = 30'
LEGEND	DATE	BY
STORM SEWER	6/19/91	JR
SEWER	6/19/91	JR
PROPOSED	6/19/91	JR
EXISTING	6/19/91	JR
PROPOSED	6/19/91	JR
EXISTING	6/19/91	JR

ACCEPTED: CLIENT DATE

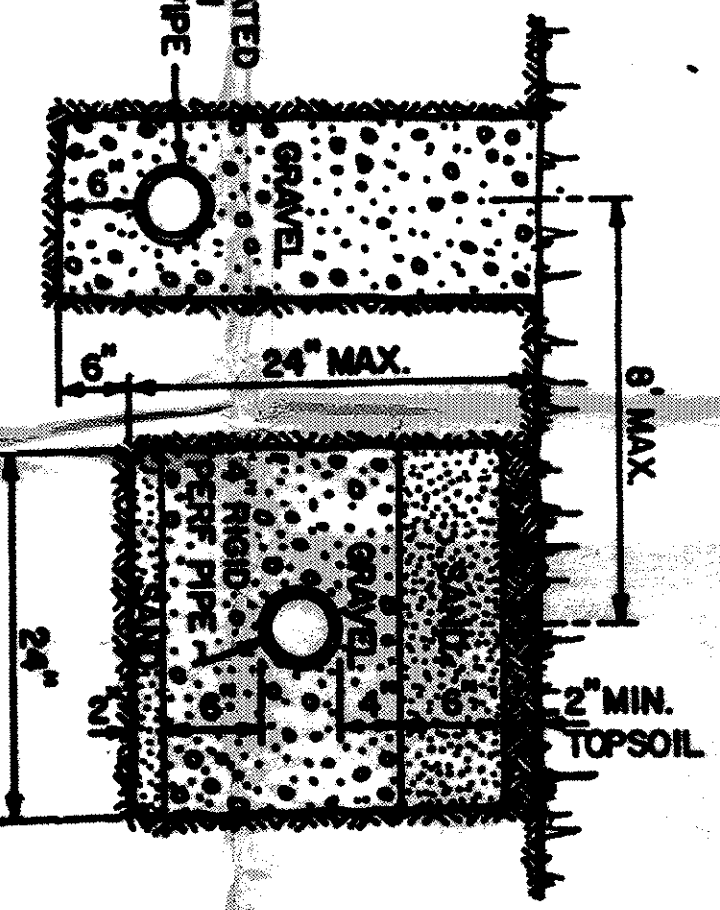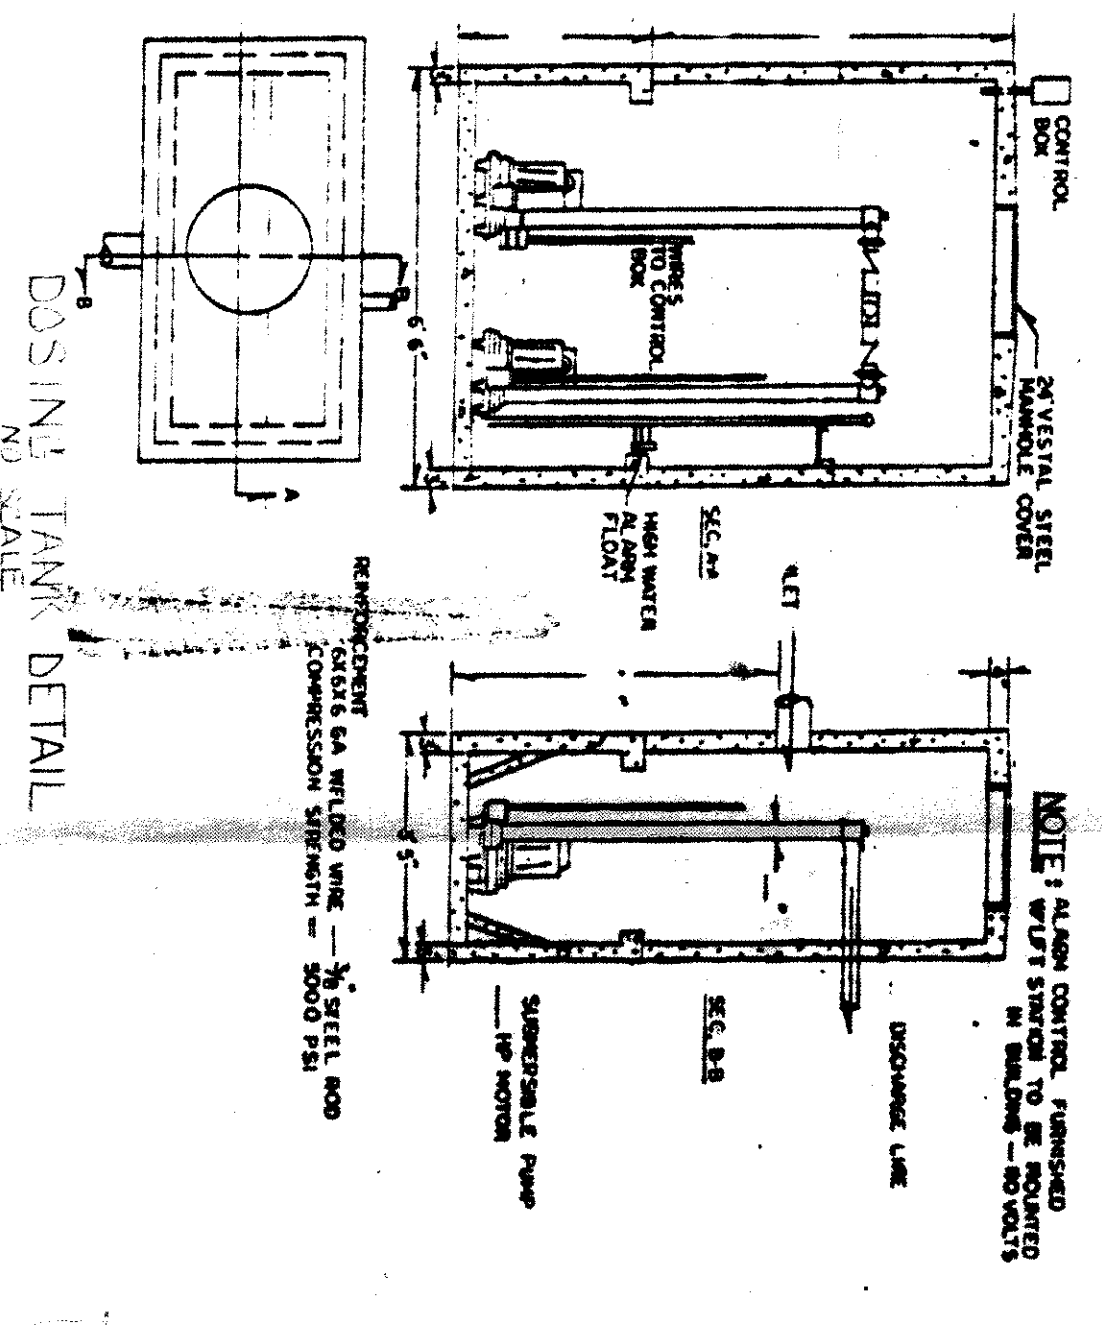


Noted and located
LANE COUNTY GENERAL SERVICES DISTRICT
DATE 6-19-91
JES LISA L. S. R. L.
JES LISA L. S. R. L.

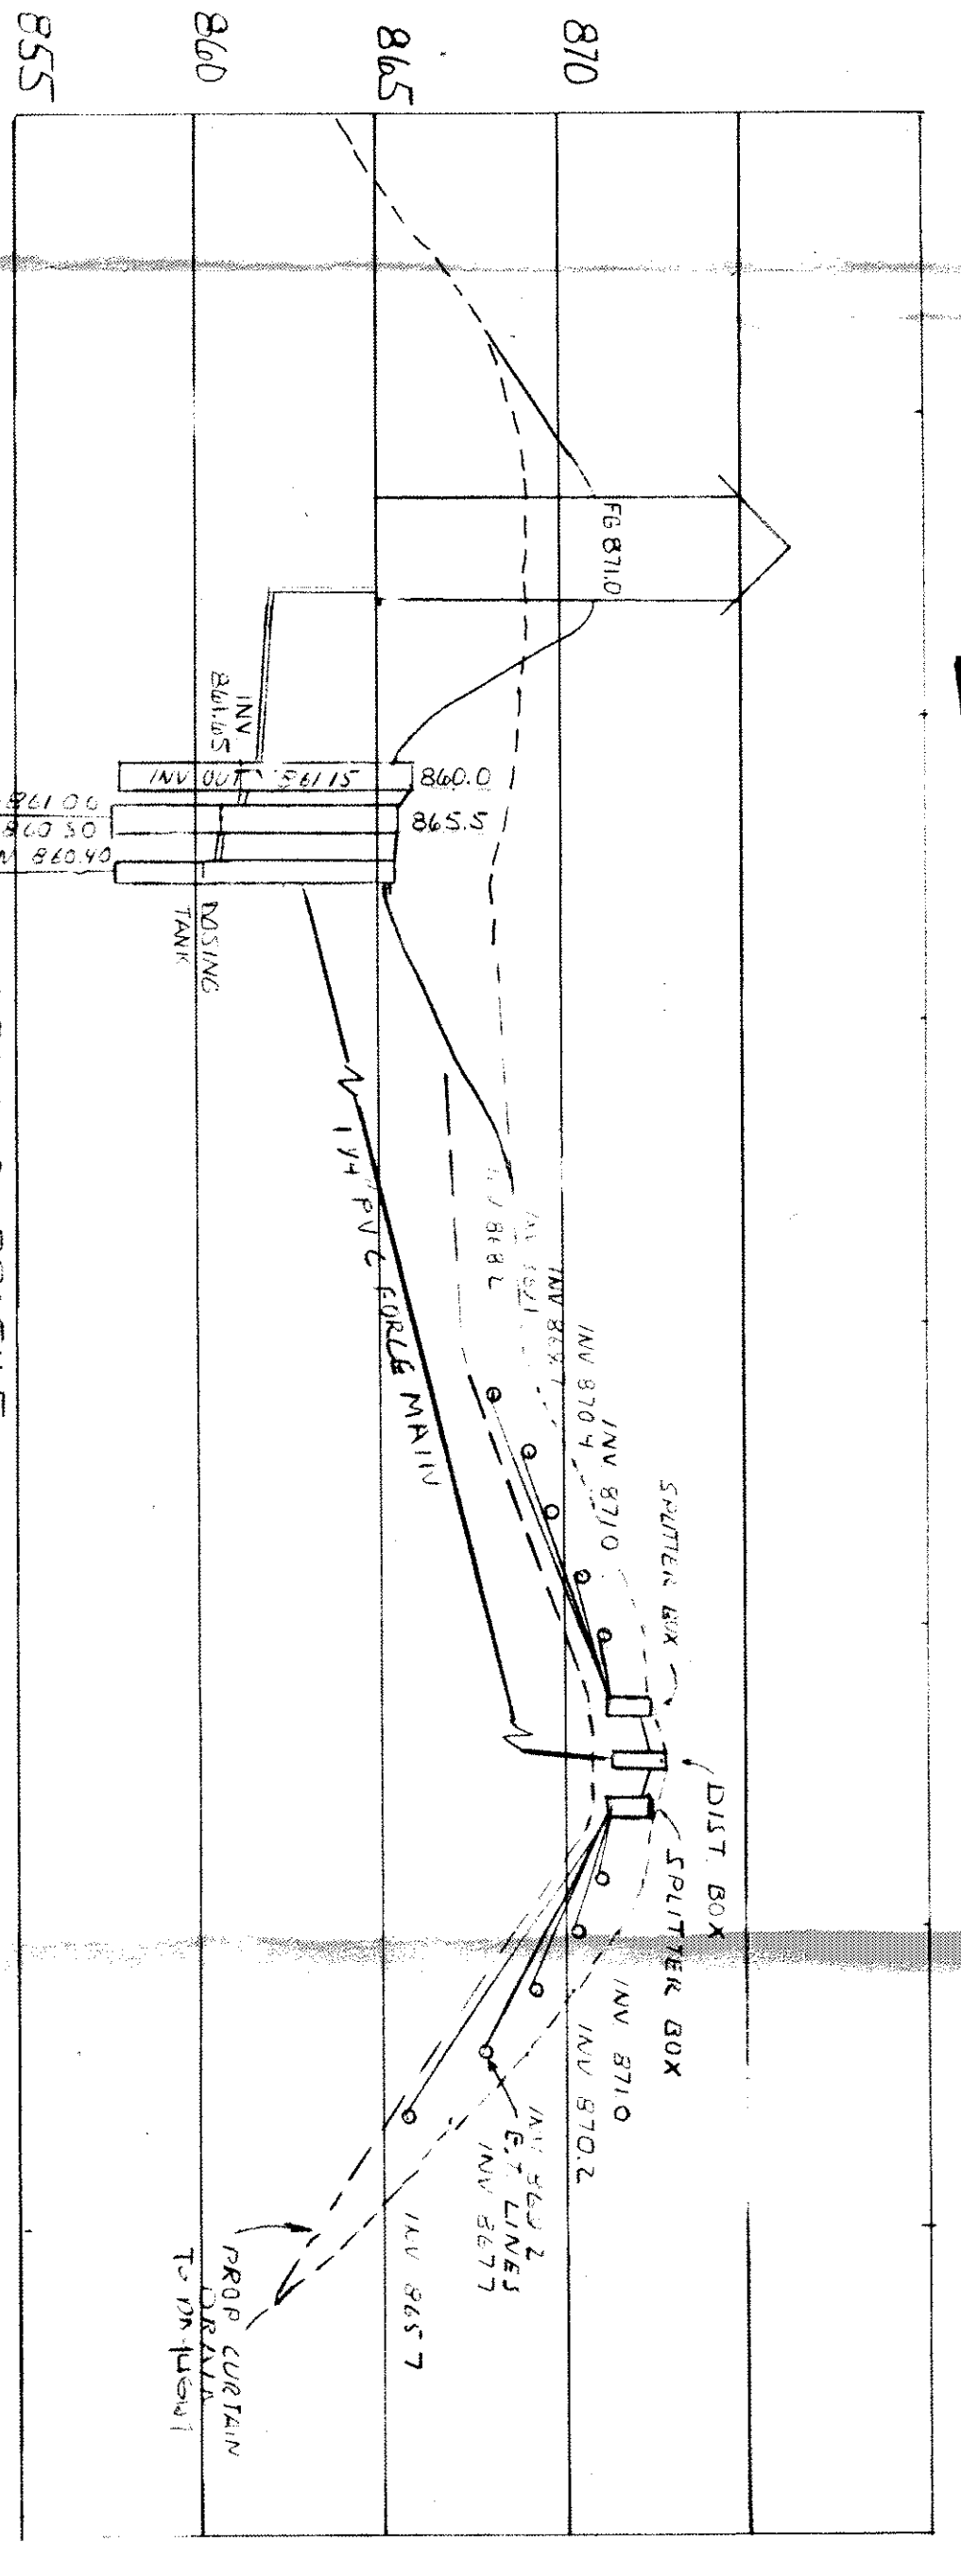

I THE UNDERSIGNED HEREBY CERTIFY THAT THE TOPO SHOWN HEREON, INDICATED BY CONTOURS REPRESENTS AN AERIAL PHOTOGRAPHY MADE BY AEROCON PHOTOGRAMMETRIC SURVEYS, INC. BASED UPON FIELD DATA OBSERVED BY LDC, INC. IN JUNE, 1989.

JAMES R. PEGORARO, P.E., NO. 5368

FAR HILL DRIVE 60'

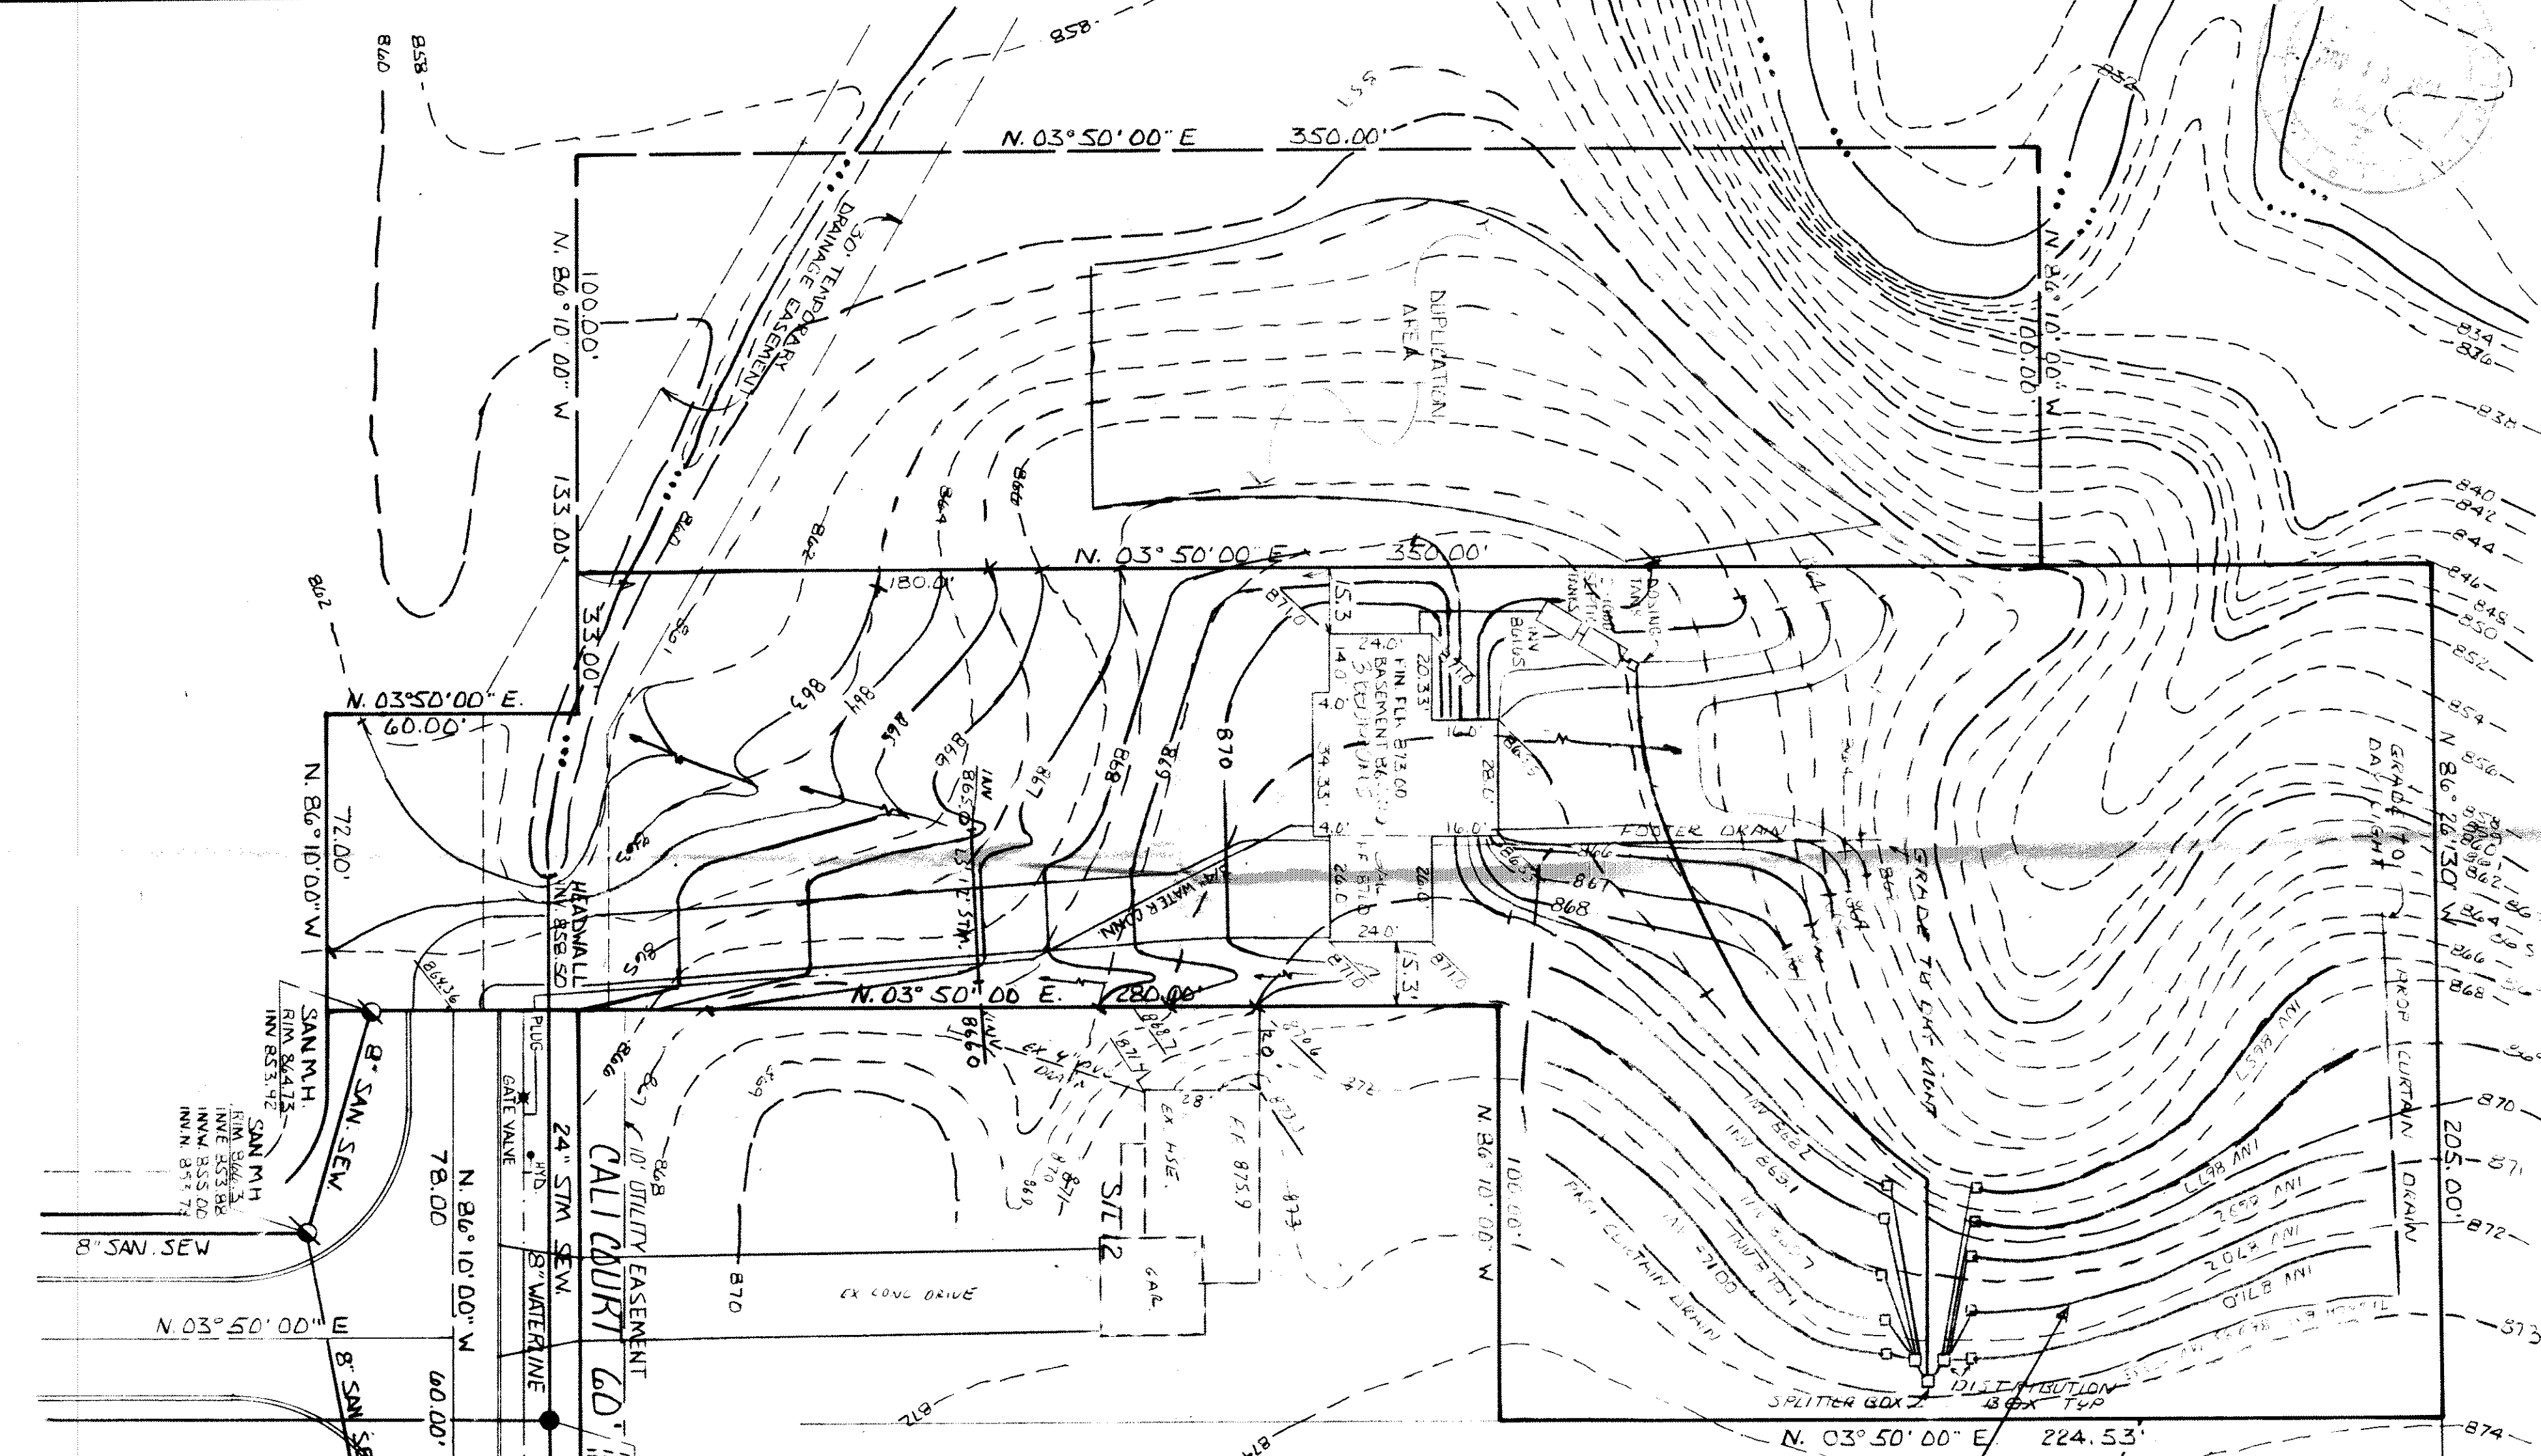

JOSEPH CALI SUBD. No. 1
VOL. 13, Pg. 20

REV. NO. DATE BY CHK'D
FILENAME: 1116 PROUTY ROAD CONCORD
CONTRACT NO. 1116 PROUTY ROAD CONCORD
SHEET 1 OF 1