


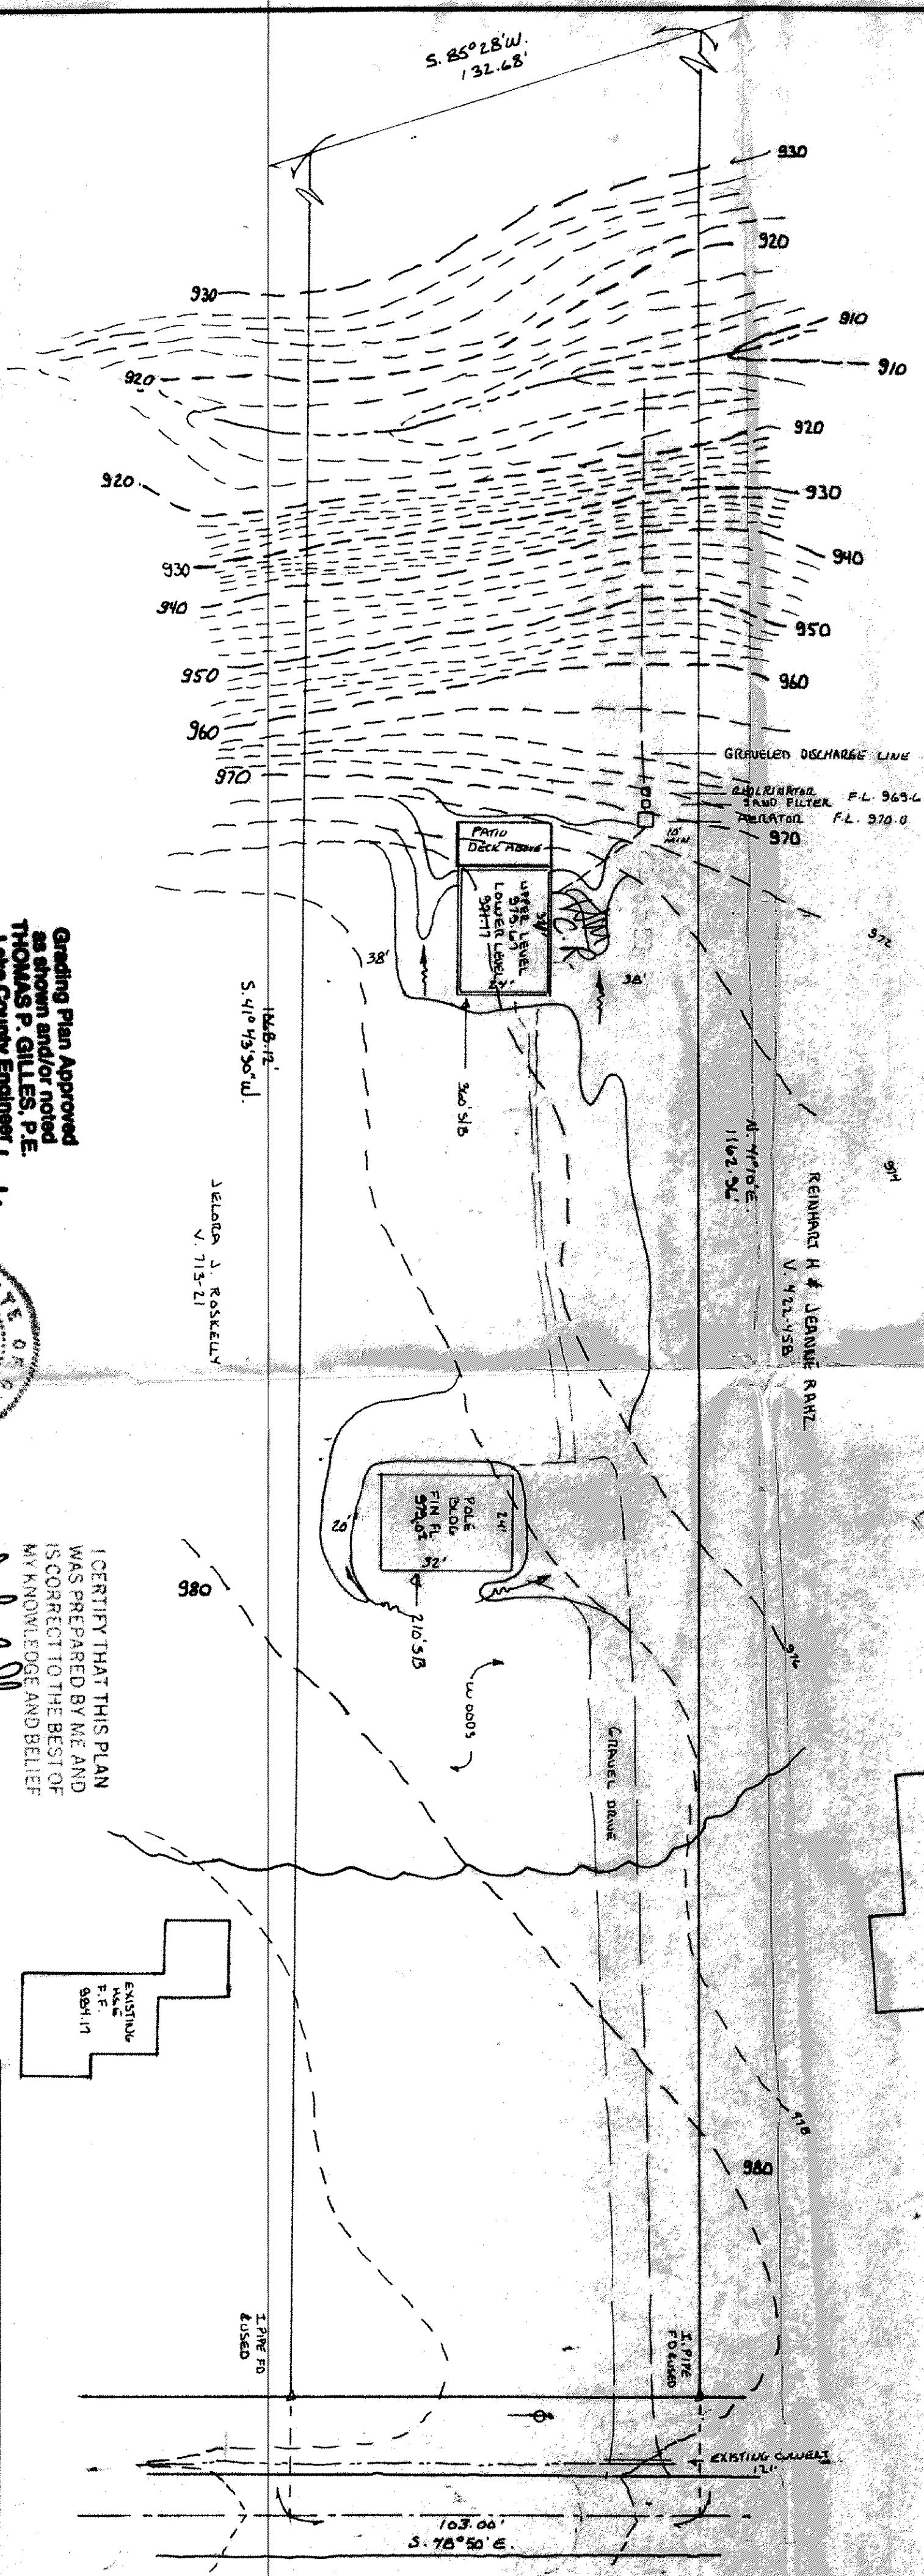

- A. To be brought to finished grade
1. Septic tank manhole covers
 2. Splitter box cover
 3. Distribution box cover
- B. No footer drains or downspouts to be discharged into septic tanks
- C. All waste water to be discharged into septic tanks


SEWAGE DISPOSAL PERMIT MUST BE OBTAINED BY A LAKE COUNTY LICENSED INSTALLER BEFORE INSTALLATION IS STARTED

Reviewed and Accepted
LAKE COUNTY GENERAL HEALTH DISTRICT
Date 7-21-89
JOEL LUCHA, R.S., M.P.H.
Health Commissioner
By David B. Jones

LOW YIELD WATER
FIXTURES REQUIRED
ON ALL:
Shower Head
Toilet

ZONING PERMIT # 6197
ISSUED 6-13-89
SUBJECT TO APPROVAL BY:
☐ Lake County Sanitary Eng.
☒ Lake County Eng. Dept.
☐ Lake County Planning Comm.
☒ Lake County Bldg. Dept.
Tom J. Marano

Grading Plan Approved
as shown and/or noted
THOMAS P. GILLES, P.E.
Lake County Engineer
Date 7/21/89

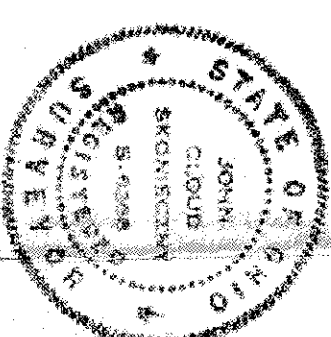

I CERTIFY THAT THIS PLAN
WAS PREPARED BY ME AND
IS CORRECT TO THE BEST OF
MY KNOWLEDGE AND BELIEF

John C. Skoneczny
REG. SURVEYOR #6395
JOHN C. SKONECZNY
7739 VIEWMOUNT DR.
PAINESVILLE, OHIO 44077
PH. 352-7742

SITE PLAN FOR:
CHRIS M. RAHZ
12172 E. BAYVIEW RD.
CONCORD TOWNSHIP, OHIO
SCALE: 1" = 30'
DATE: JUN 89
AS DESCRIBED IN VOL. 455 PL. 184 L.C.E.O.
TOWNSHIP OF CONCORD COUNTY OF LAKE STATE OF OHIO
DRAWING NUMBER
89-6-05