


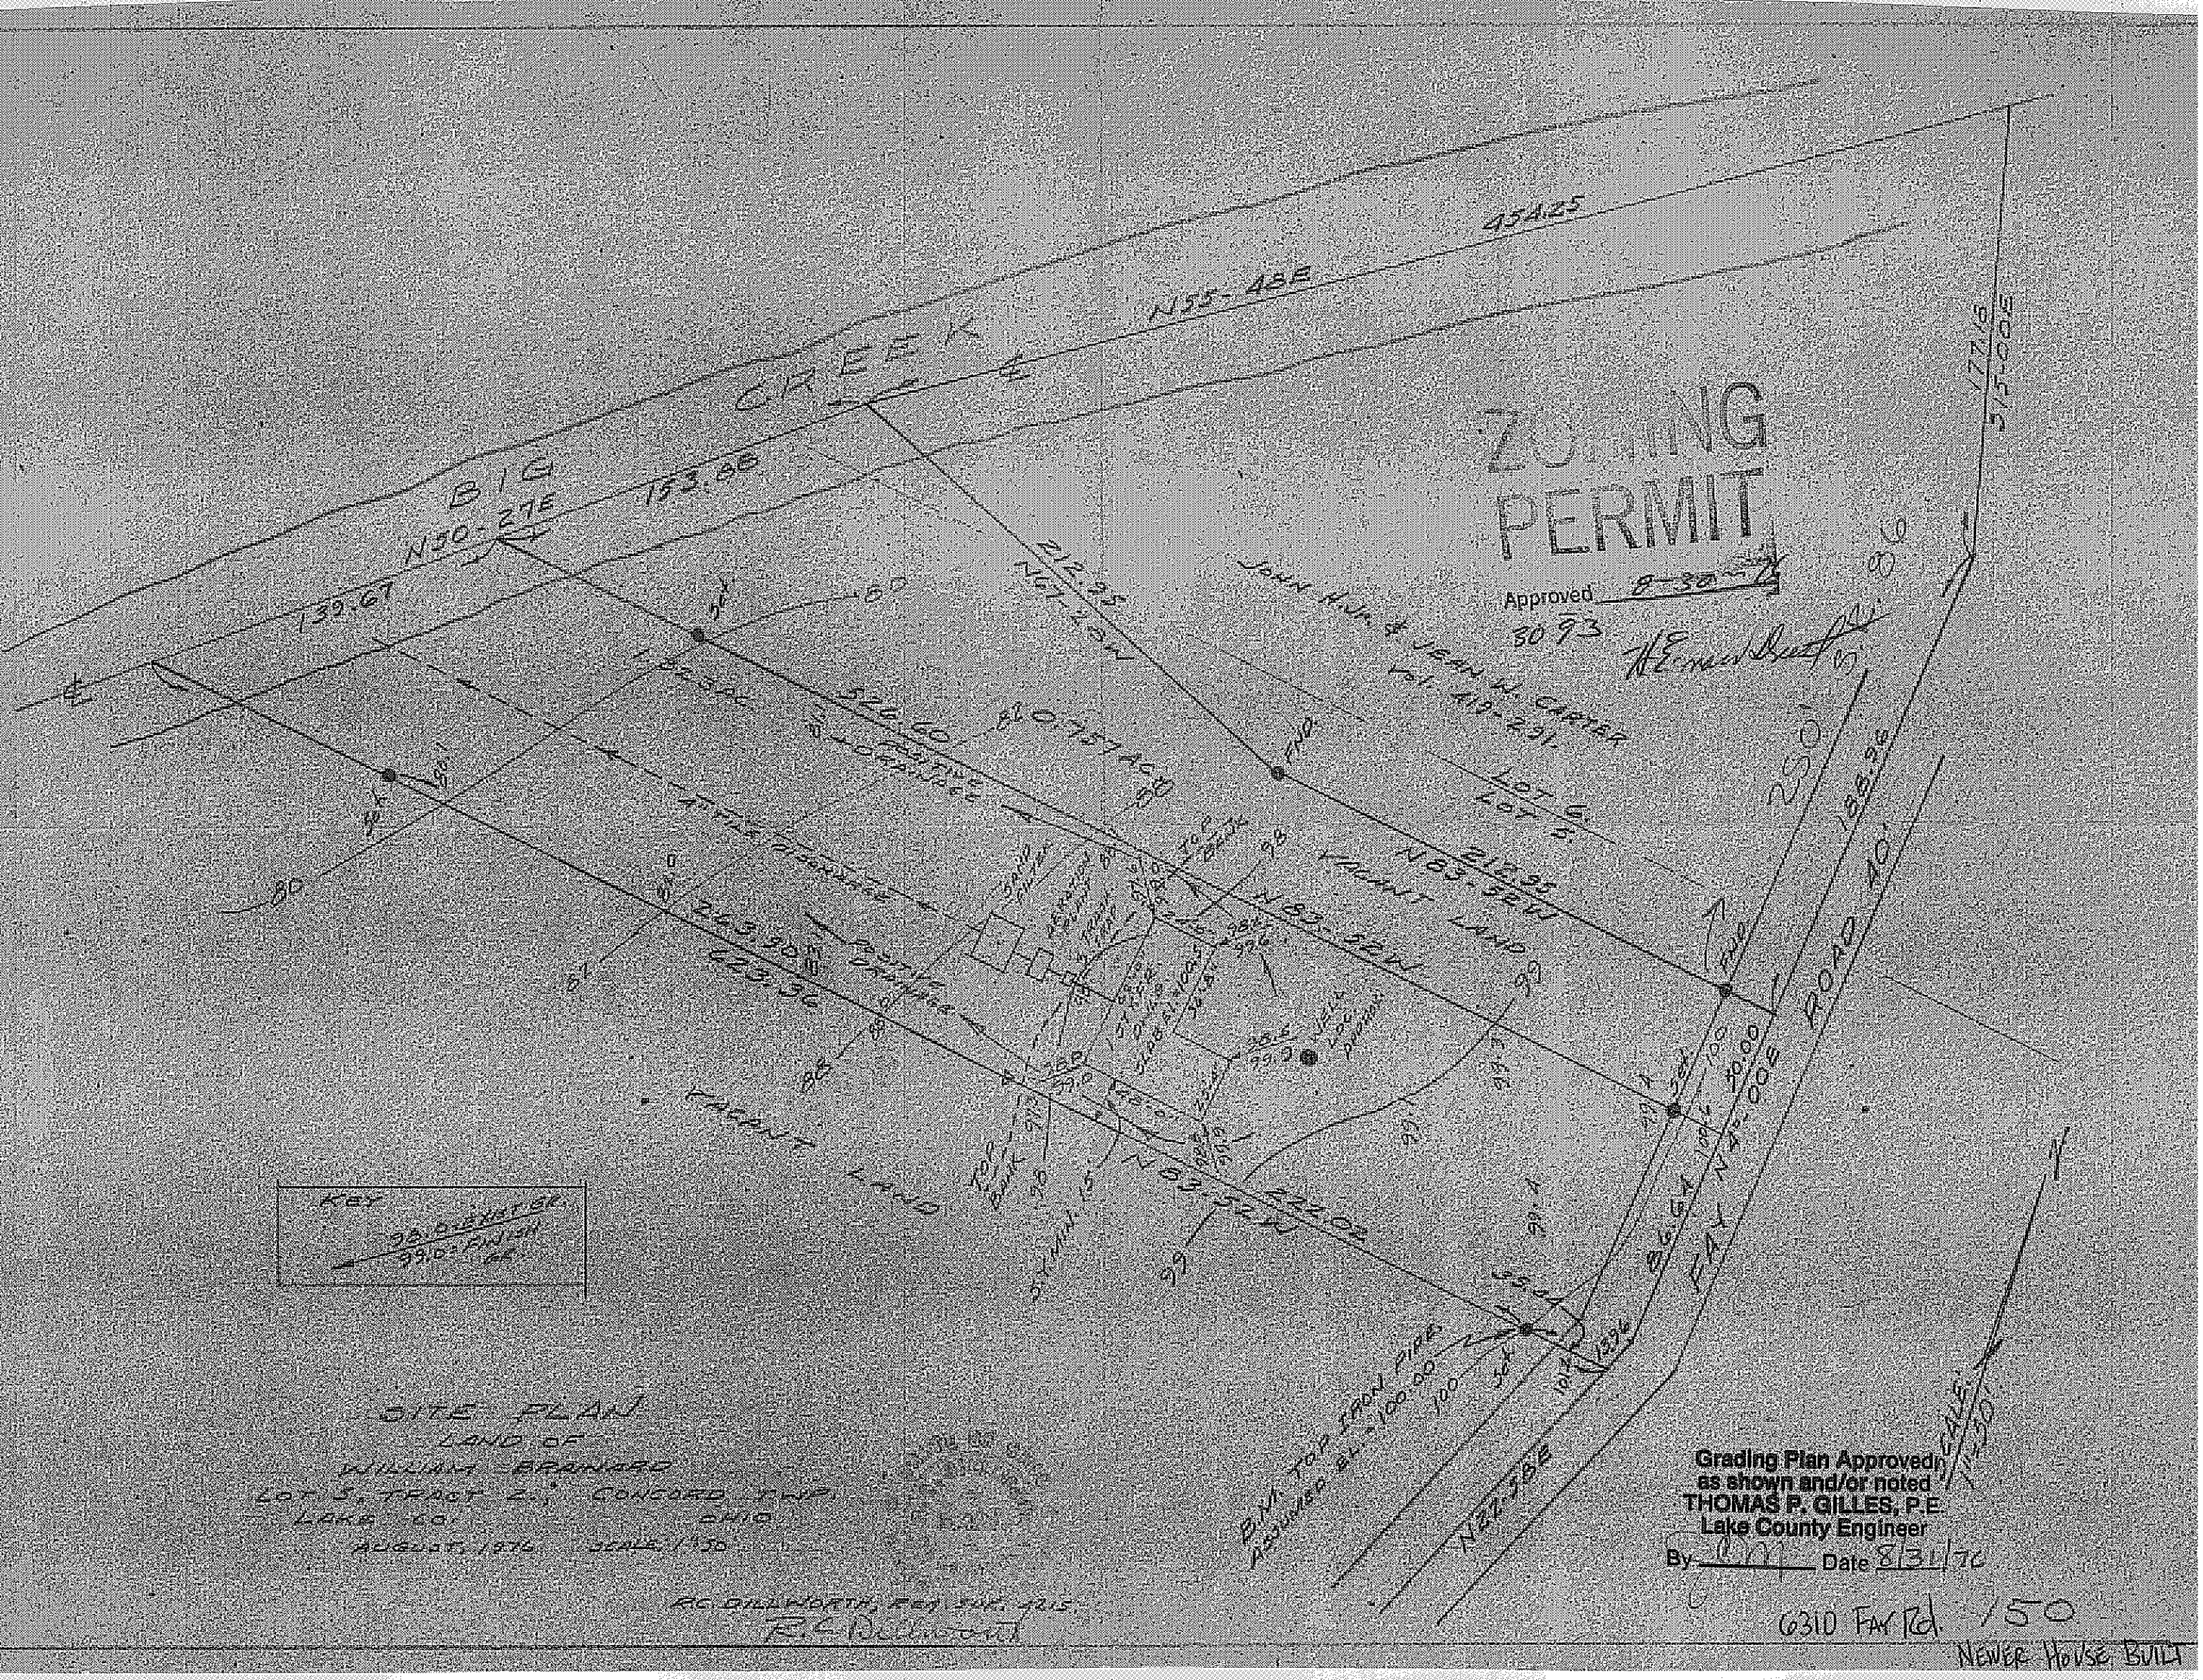

ZONING PERMIT

Approved

8-30-76

30 93

JOHN ANN & JEAN W. CARTER
Vol. 419-291

Thomas P. Gilles

KEY
98.0 EXISTING
99.0 FINISH

SITE PLAN
LAND OF
WILLIAM BRANSON
LOT 5, TRACT 2, CONCORD TWP,
LAKE CO. OHIO
AUGUST, 1976 SCALE 1"=50'

RC GILLMORTH, P.E. 544 4215
R.C. Gillmorth

Grading Plan Approved
as shown and/or noted
THOMAS P. GILLES, P.E.
Lake County Engineer

By *Tom* Date 8/31/76

6310 Fay Rd 1/50

NEWER HOUSE BUILT