


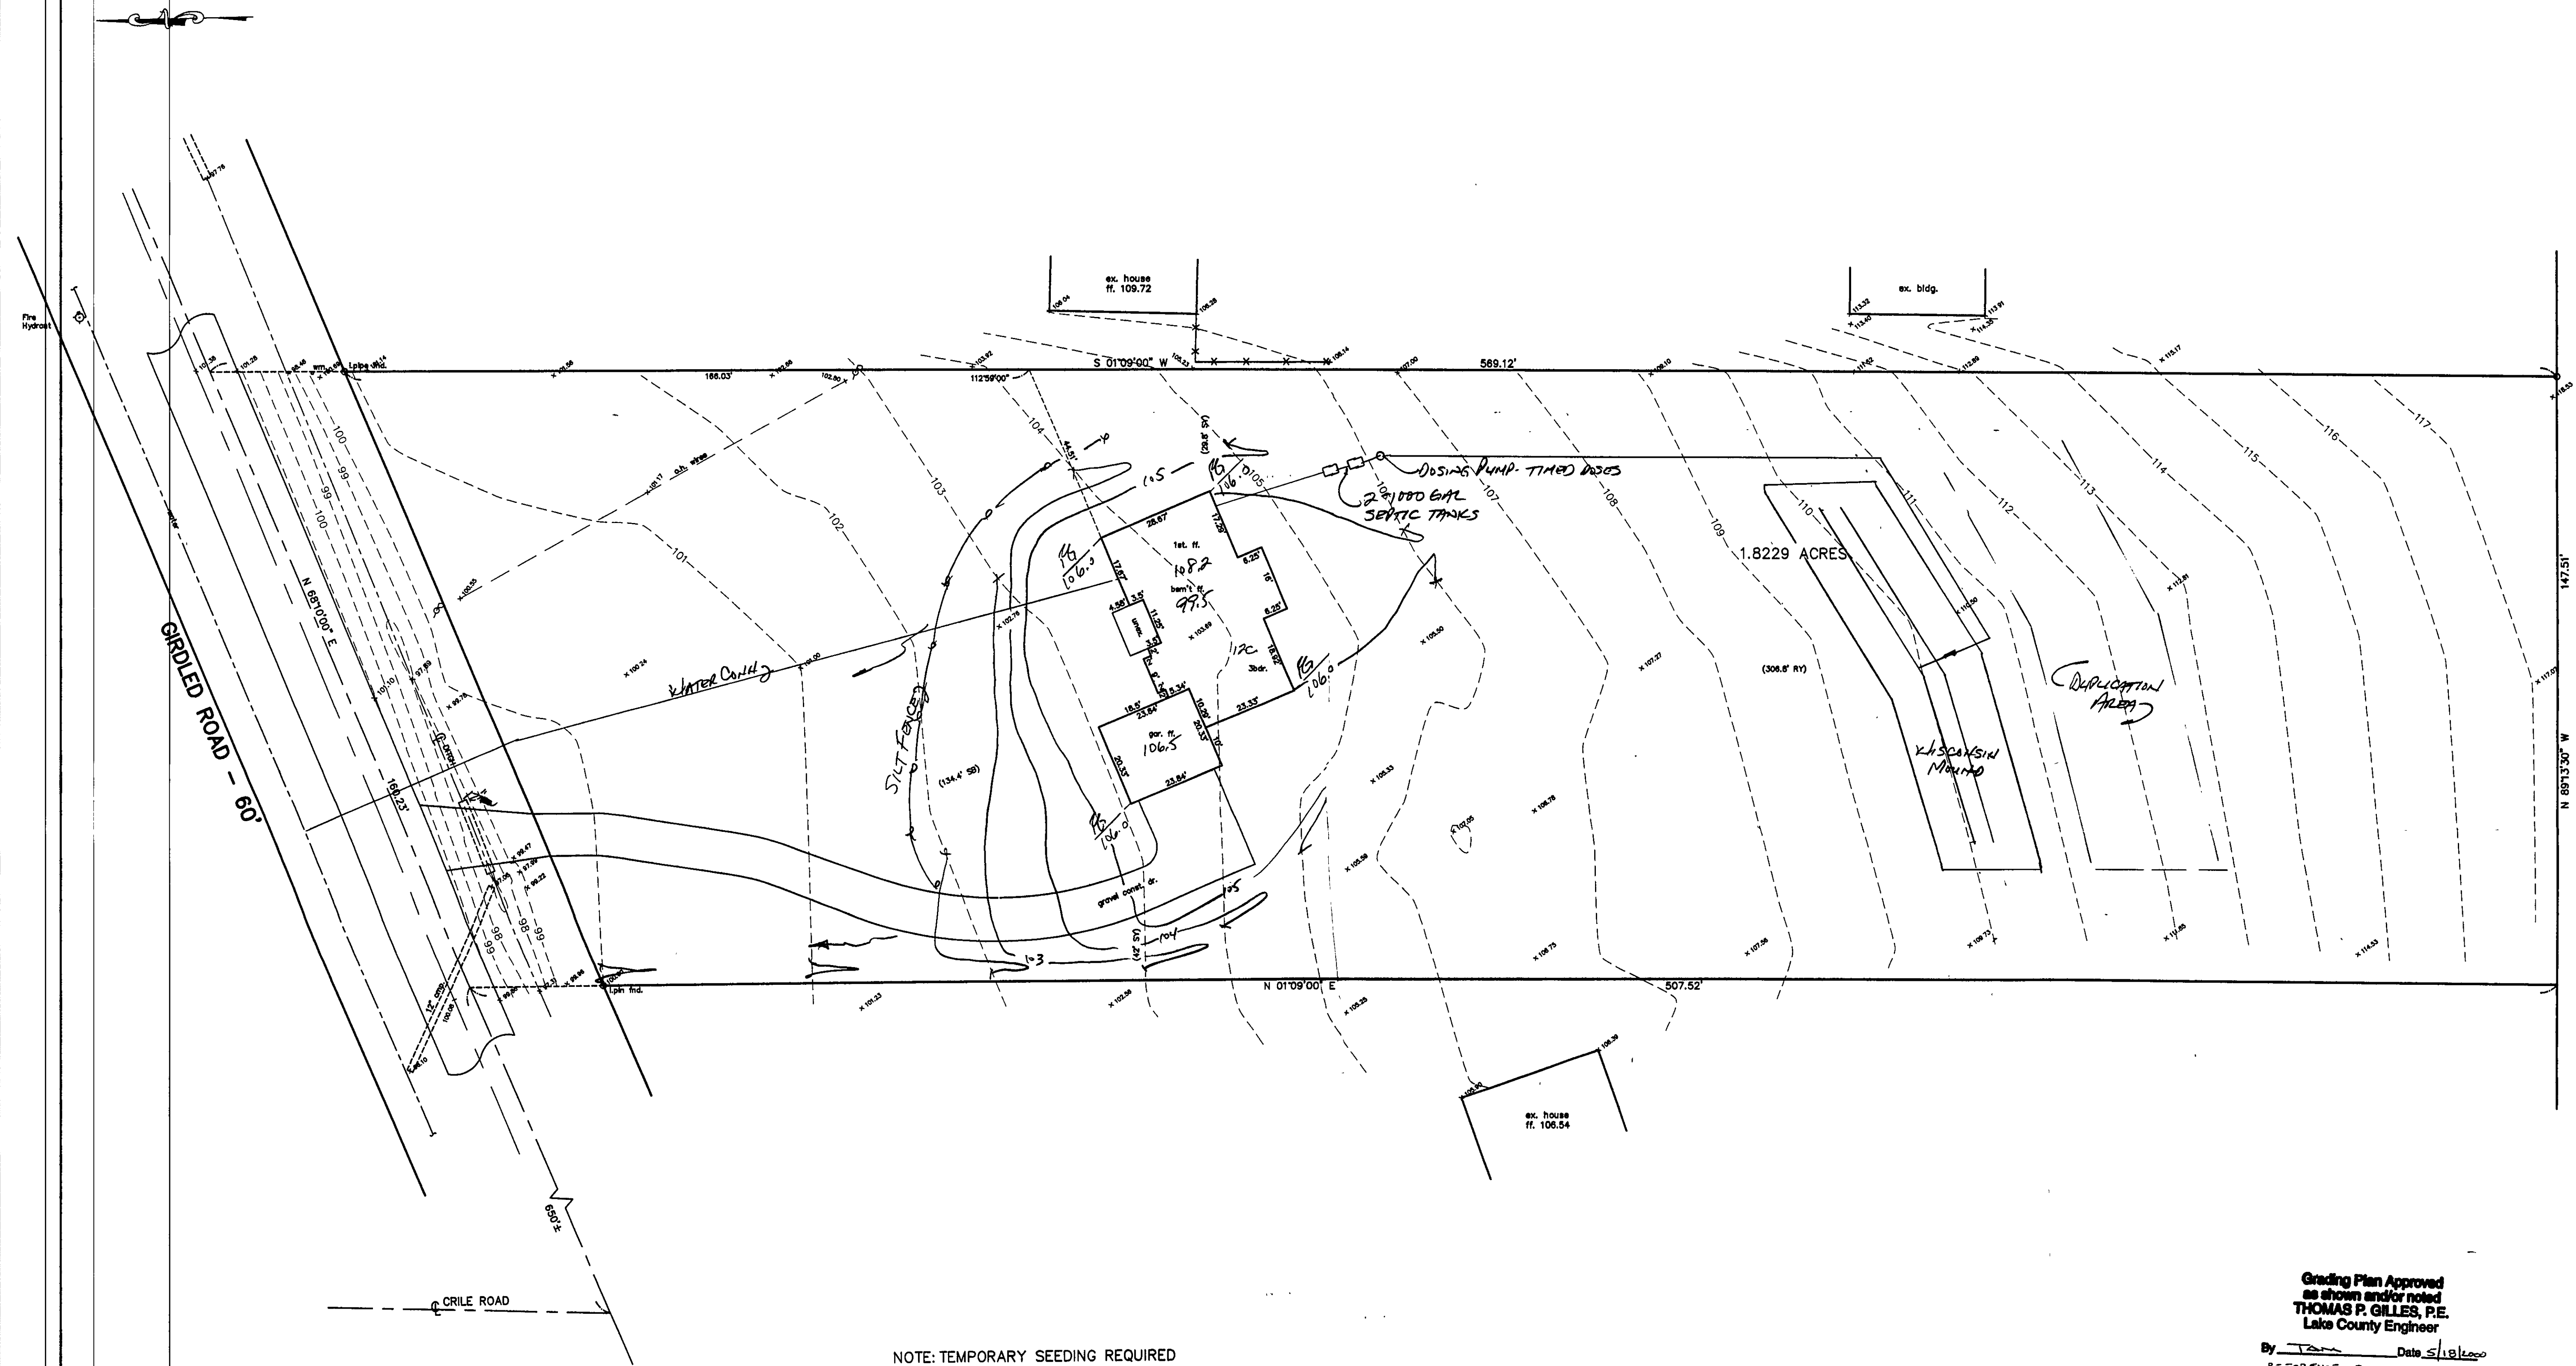

Grading Plan Approved
as shown and/or noted
THOMAS P. GILLES, P.E.
Lake County Engineer
By Tan Date 5/18/00
REFERENCE zoning perm. # 0400 7138

"I, the undersigned hereby certify that
this topography indicated by 6", 1", or 2"
contours, and elevations shown hereon
represent an actual field survey made by
me on the 24th day of April, 2000
and that the elevations were taken at
appropriate intervals and that as of that
date they existed as indicated hereon."

Harry Jones #6343
Name Reg. No.

BM-TOP OF IRON PIN FOUND
ELEV.=100.00



REVIEWED AND ACCEPTED
LAKE COUNTY GENERAL
HEALTH DISTRICT
Date 5-16-00 by Daniel Hall
Local Boardman needed
for discharge line
SEWAGE DISPOSAL PERMIT MUST BE
OBTAINED FROM LAKE COUNTY BEFORE
INSTALLATION OF SEWERAGE SYSTEM
STARTED

REV NO.	DESCRIPTION	DATE	BY	CHK'D
1	REVISED HOUSE LOCATION & MOUND	4/27/00	T.R.	H.J.
2	REVISED MOUND	5/4/00	H.J.	H.J.

bj BABCOCK, JONES AND ASSOCIATES, INC
CIVIL ENGINEERS - SURVEYORS - LAND PLANNERS
PAINESVILLE OHIO 44077

DATE	4/25/00
DESIGN BY	H.J.
DRAWN BY	T.R.
APPROVED BY	H.J.

SITE PLAN
FOR
CORNERSTONE HOMES
CONCORD TOWNSHIP
LAKE COUNTY