


**HARNESSFIELD LANE 60'**

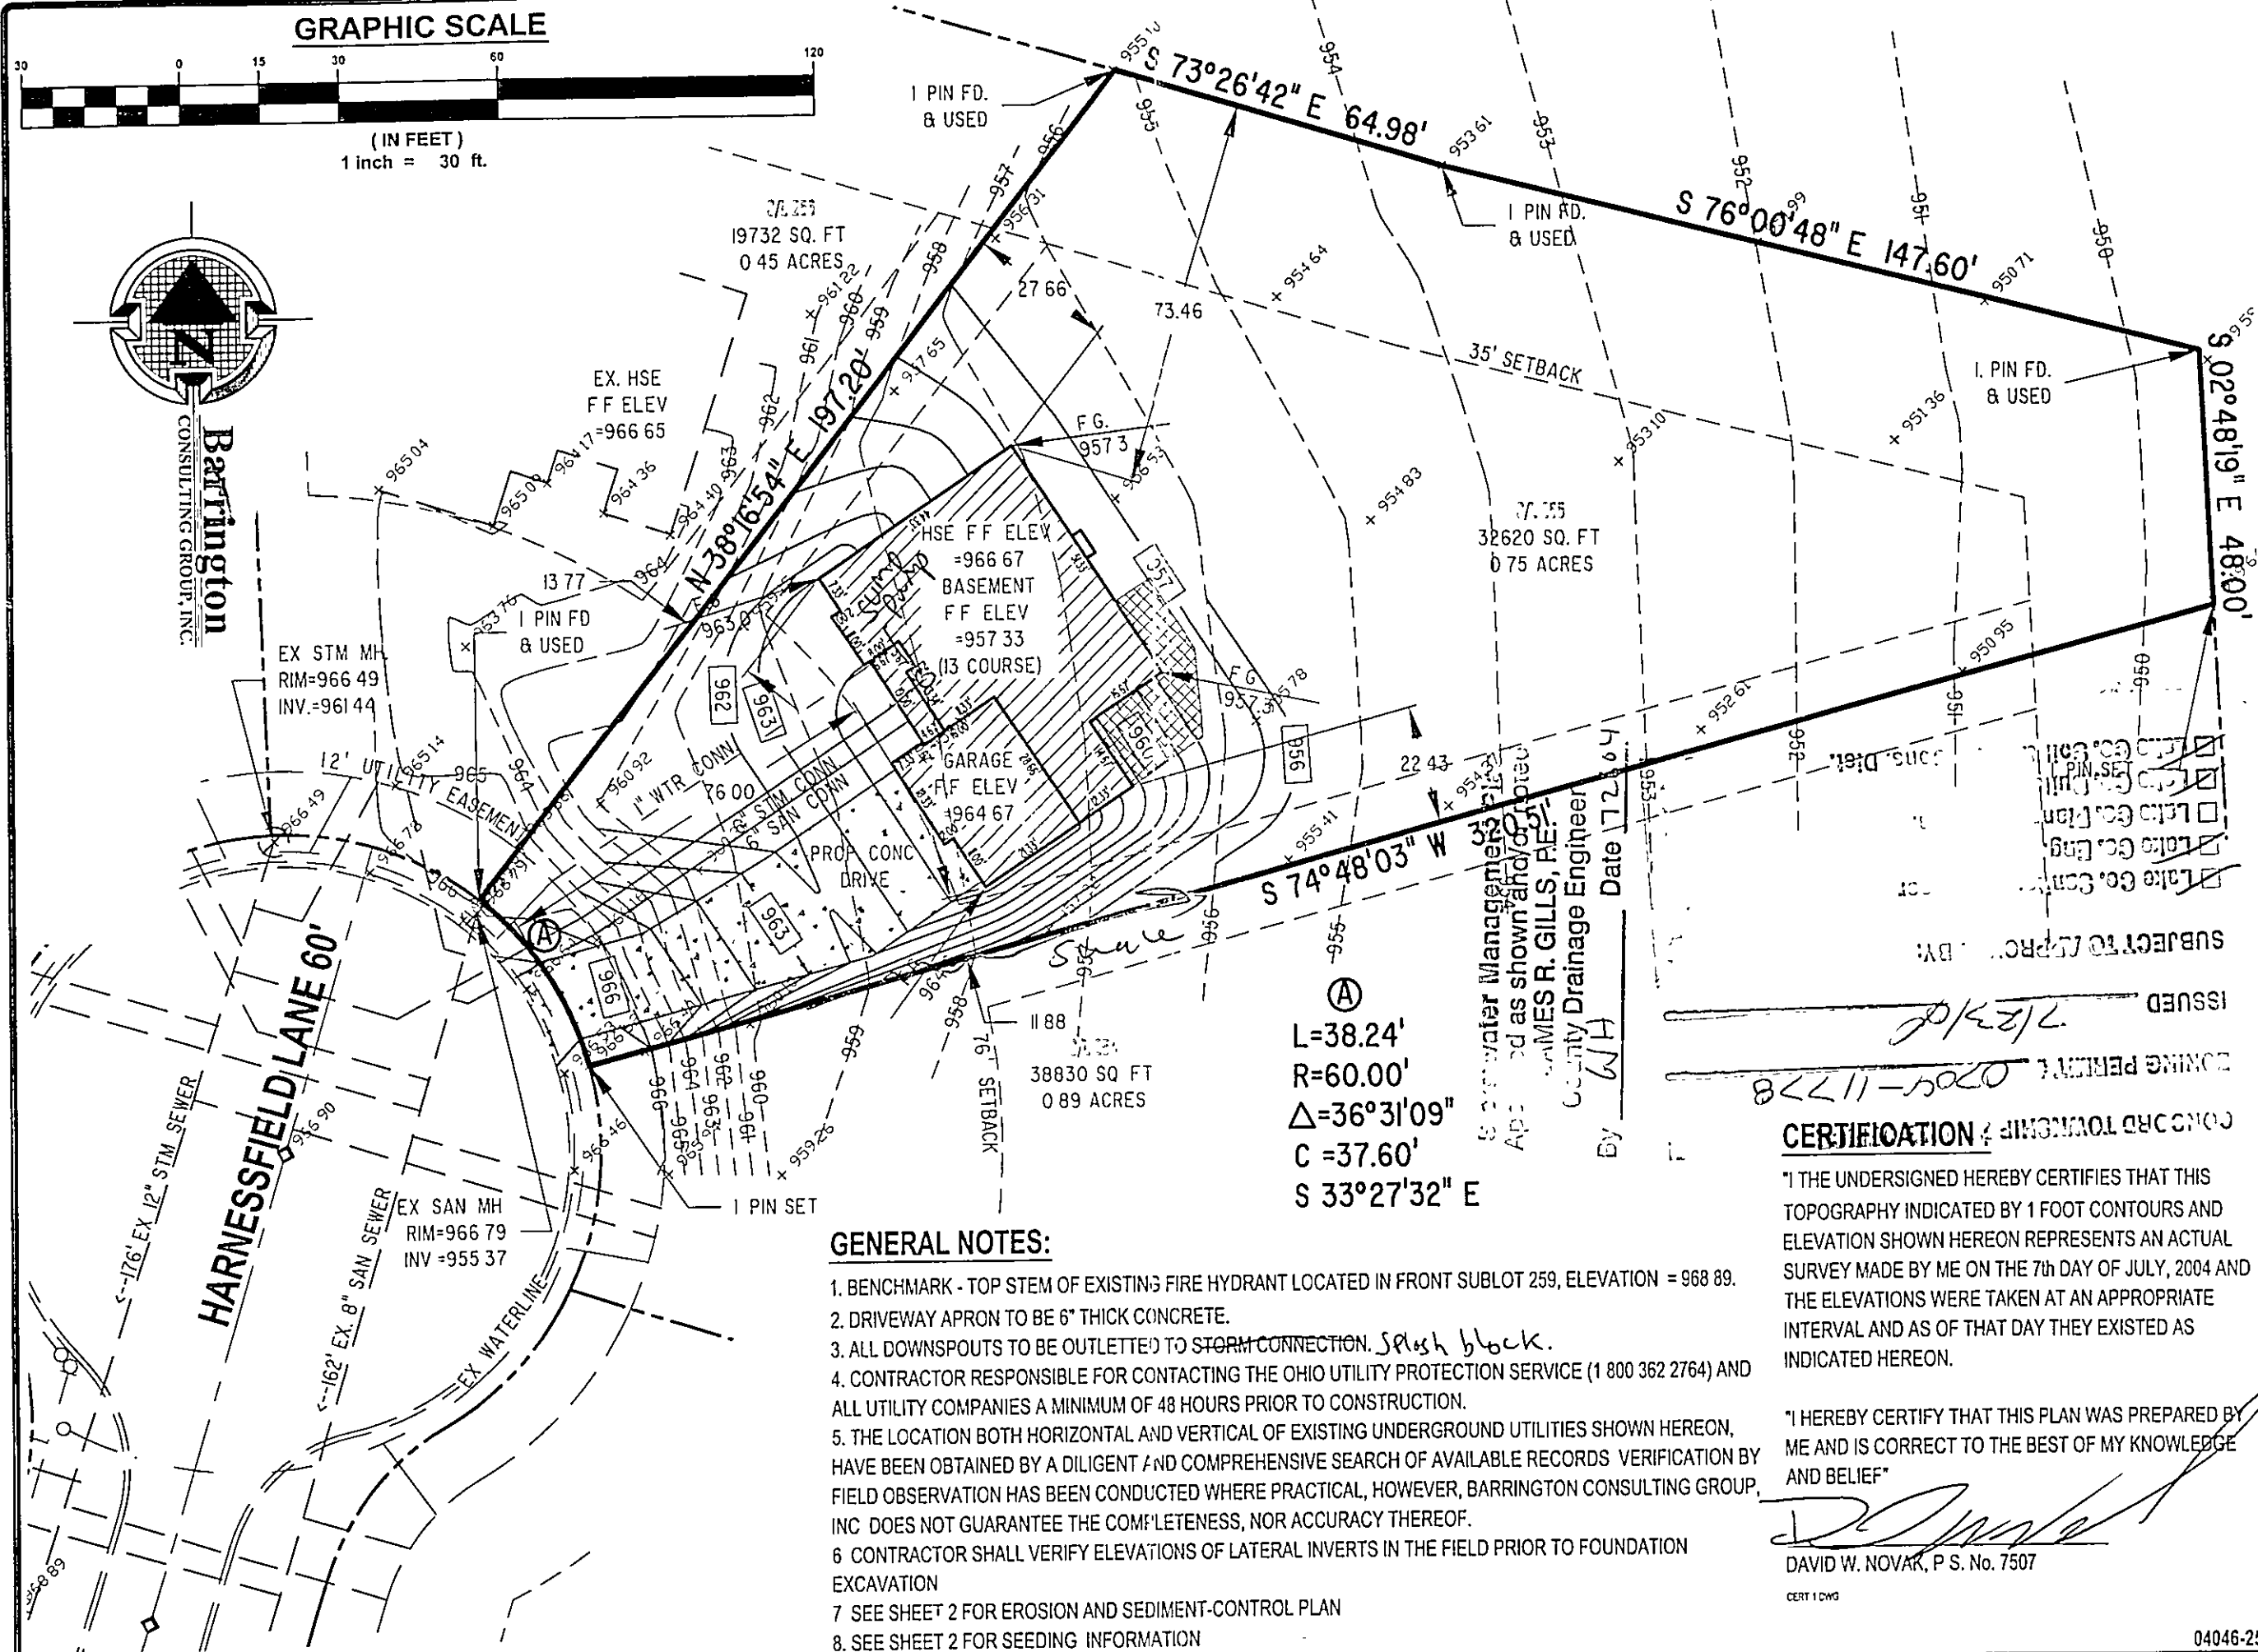

1. BENCHMARK - TOP STEM OF EXISTING FIRE HYDRANT LOCATED IN FRONT SUBLOT 259, ELEVATION = 968.89.
2. DRIVEWAY APRON TO BE 6" THICK CONCRETE.
3. ALL DOWNSPOUTS TO BE OUTLETED TO STORM CONNECTION. *Slash block.*
4. CONTRACTOR RESPONSIBLE FOR CONTACTING THE OHIO UTILITY PROTECTION SERVICE (1 800 362 2764) AND ALL UTILITY COMPANIES A MINIMUM OF 48 HOURS PRIOR TO CONSTRUCTION.
5. THE LOCATION BOTH HORIZONTAL AND VERTICAL OF EXISTING UNDERGROUND UTILITIES SHOWN HEREON, HAVE BEEN OBTAINED BY A DILIGENT AND COMPREHENSIVE SEARCH OF AVAILABLE RECORDS. VERIFICATION BY FIELD OBSERVATION HAS BEEN CONDUCTED WHERE PRACTICAL, HOWEVER, BARRINGTON CONSULTING GROUP, INC. DOES NOT GUARANTEE THE COMPLETENESS, NOR ACCURACY THEREOF.
6. CONTRACTOR SHALL VERIFY ELEVATIONS OF LATERAL INVERTS IN THE FIELD PRIOR TO FOUNDATION EXCAVATION.
7. SEE SHEET 2 FOR EROSION AND SEDIMENT-CONTROL PLAN.
8. SEE SHEET 2 FOR SEEDING INFORMATION.

(A)  
 $L = 38.24'$   
 $R = 60.00'$   
 $\Delta = 36^\circ 31' 09''$   
 $C = 37.60'$   
 $S \ 33^\circ 27' 32'' \ E$

### CERTIFICATION

"I THE UNDERSIGNED HEREBY CERTIFIES THAT THIS TOPOGRAPHY INDICATED BY 1 FOOT CONTOURS AND ELEVATION SHOWN HEREON REPRESENTS AN ACTUAL SURVEY MADE BY ME ON THE 7th DAY OF JULY, 2004 AND THE ELEVATIONS WERE TAKEN AT AN APPROPRIATE INTERVAL AND AS OF THAT DAY THEY EXISTED AS INDICATED HEREON.

"I HEREBY CERTIFY THAT THIS PLAN WAS PREPARED BY  
ME AND IS CORRECT TO THE BEST OF MY KNOWLEDGE  
AND BELIEF"


DAVID W. NOVAR, P S. No. 7507

CERT 1 CMC

04046-255

[illegible]

**Barrington**  
CONSULTING GROUP, INC.  
38342 WESTERN PARKWAY, SUITE 10  
WILLoughBY, OHIO 44094  
PHONE 440.946.1761 FAX 440.918.0486

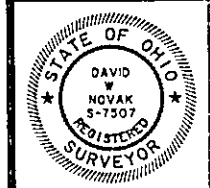

**SITE PLAN**  
S/L 255 HARNESFIELD LANE QUAIL HOLLOW No. 9  
CONCORD, OHIO 44077

**VELOTTA CONSTRUCTION**

DRAWN  
WSO  
CHECKED  
DWN  
DATE  
JULY 12, 2004  
SCALE  
1" = 30'  
JOB NO  
04046-255  
SHEET  
1/2  
OF SHEETS