



CONCORD TOWNSHIP ZONING OFFICE

ZONING PERMIT # 0504-11594


ISSUED 5/6/04

SUBJECT TO APPROVAL BY:

- ☒ Lake Co. Sanitary Eng. 3890 SQ. FT.
- ☒ Lake Co. Eng. Dept. 1.0076 ACRES
- ☐ Lake Co. Planning Comm.
- ☒ Lake Co. Building Dept.
- ☒ Lake Co. Soil & Water Cons. Dist.

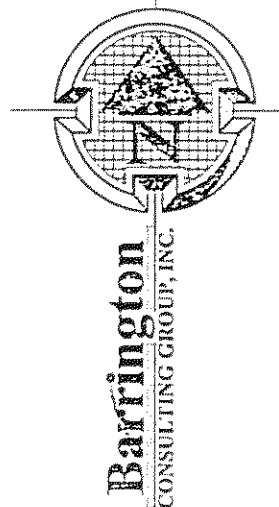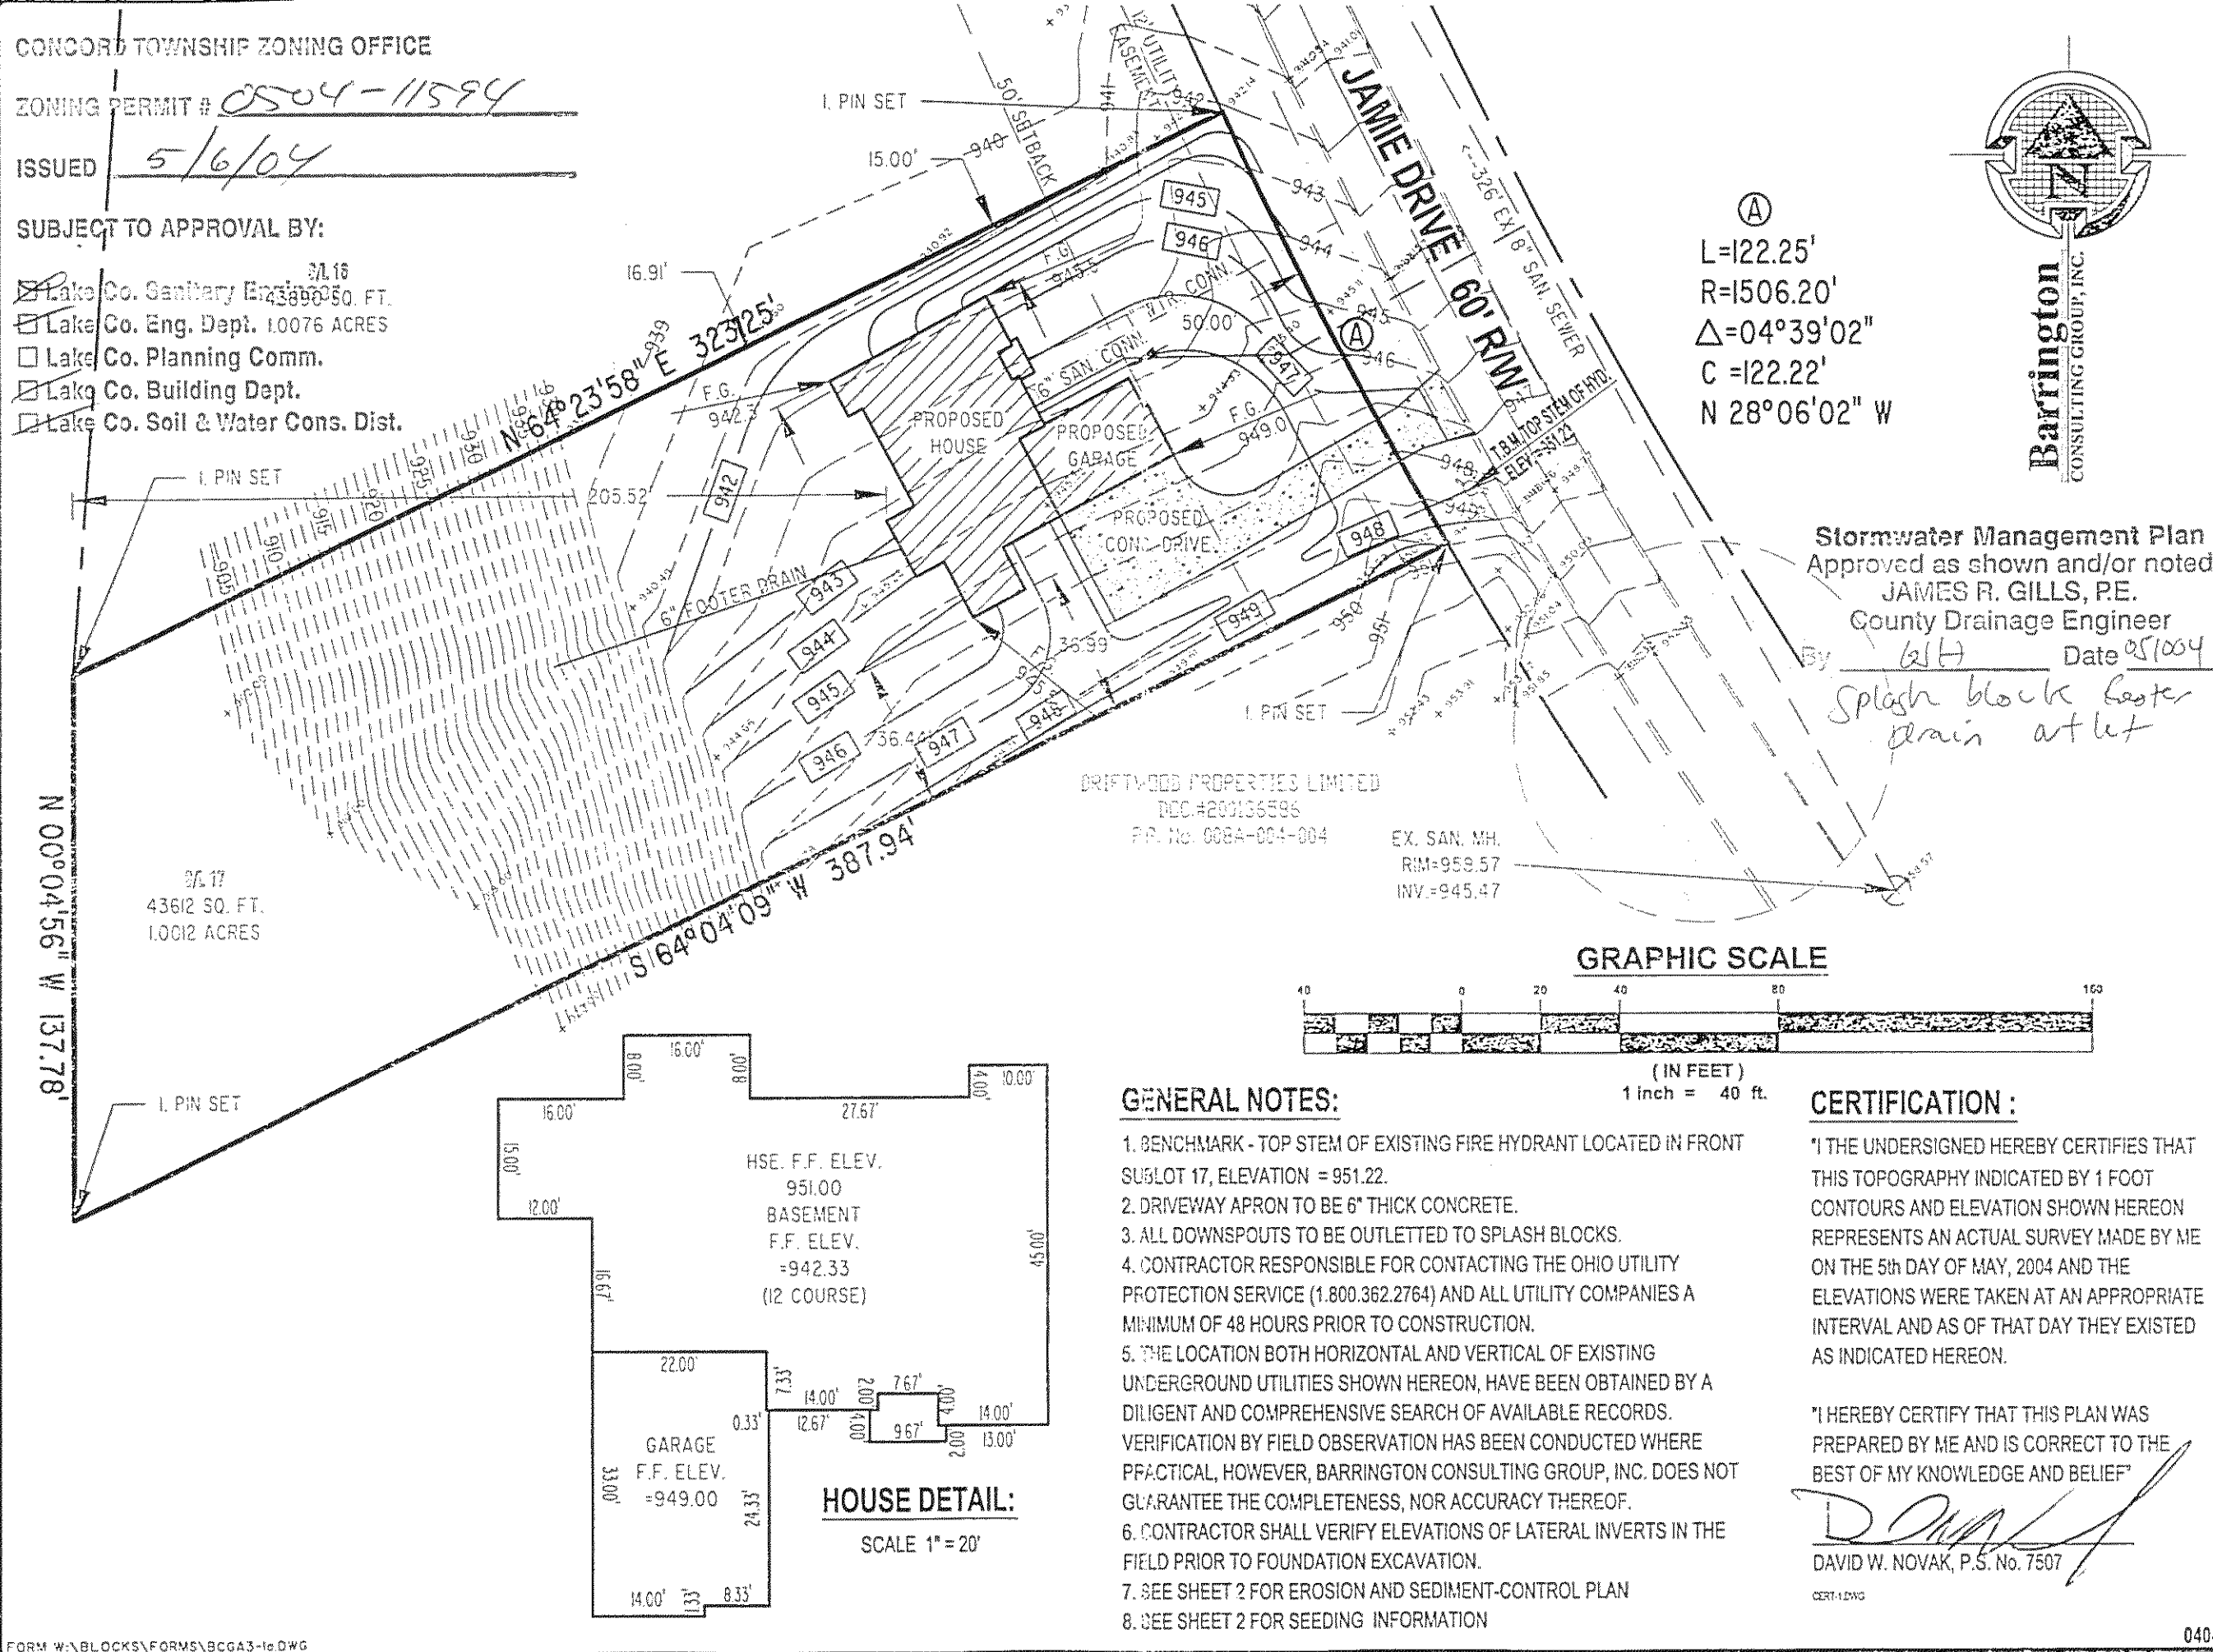

Barrington
CONSULTING GROUP, INC.
38342 WESTERN PARKWAY, SUITE 10
WILLIAMS, OHIO 44094
PHONE 440.946.1761 FAX 440.918.0486

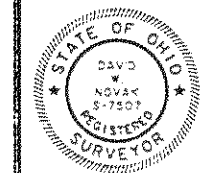

SITE PLAN
S/L 17 JAMIE DR. NOBLE RIDGE ESTATES PH. 1
CONCORD, OHIO 44077
REGENCY CONSTRUCTION, INC.

DATE
MAY 6, 2004
SCALE
1" = 40'
JOB NO.
04045
SHEET
1/2