



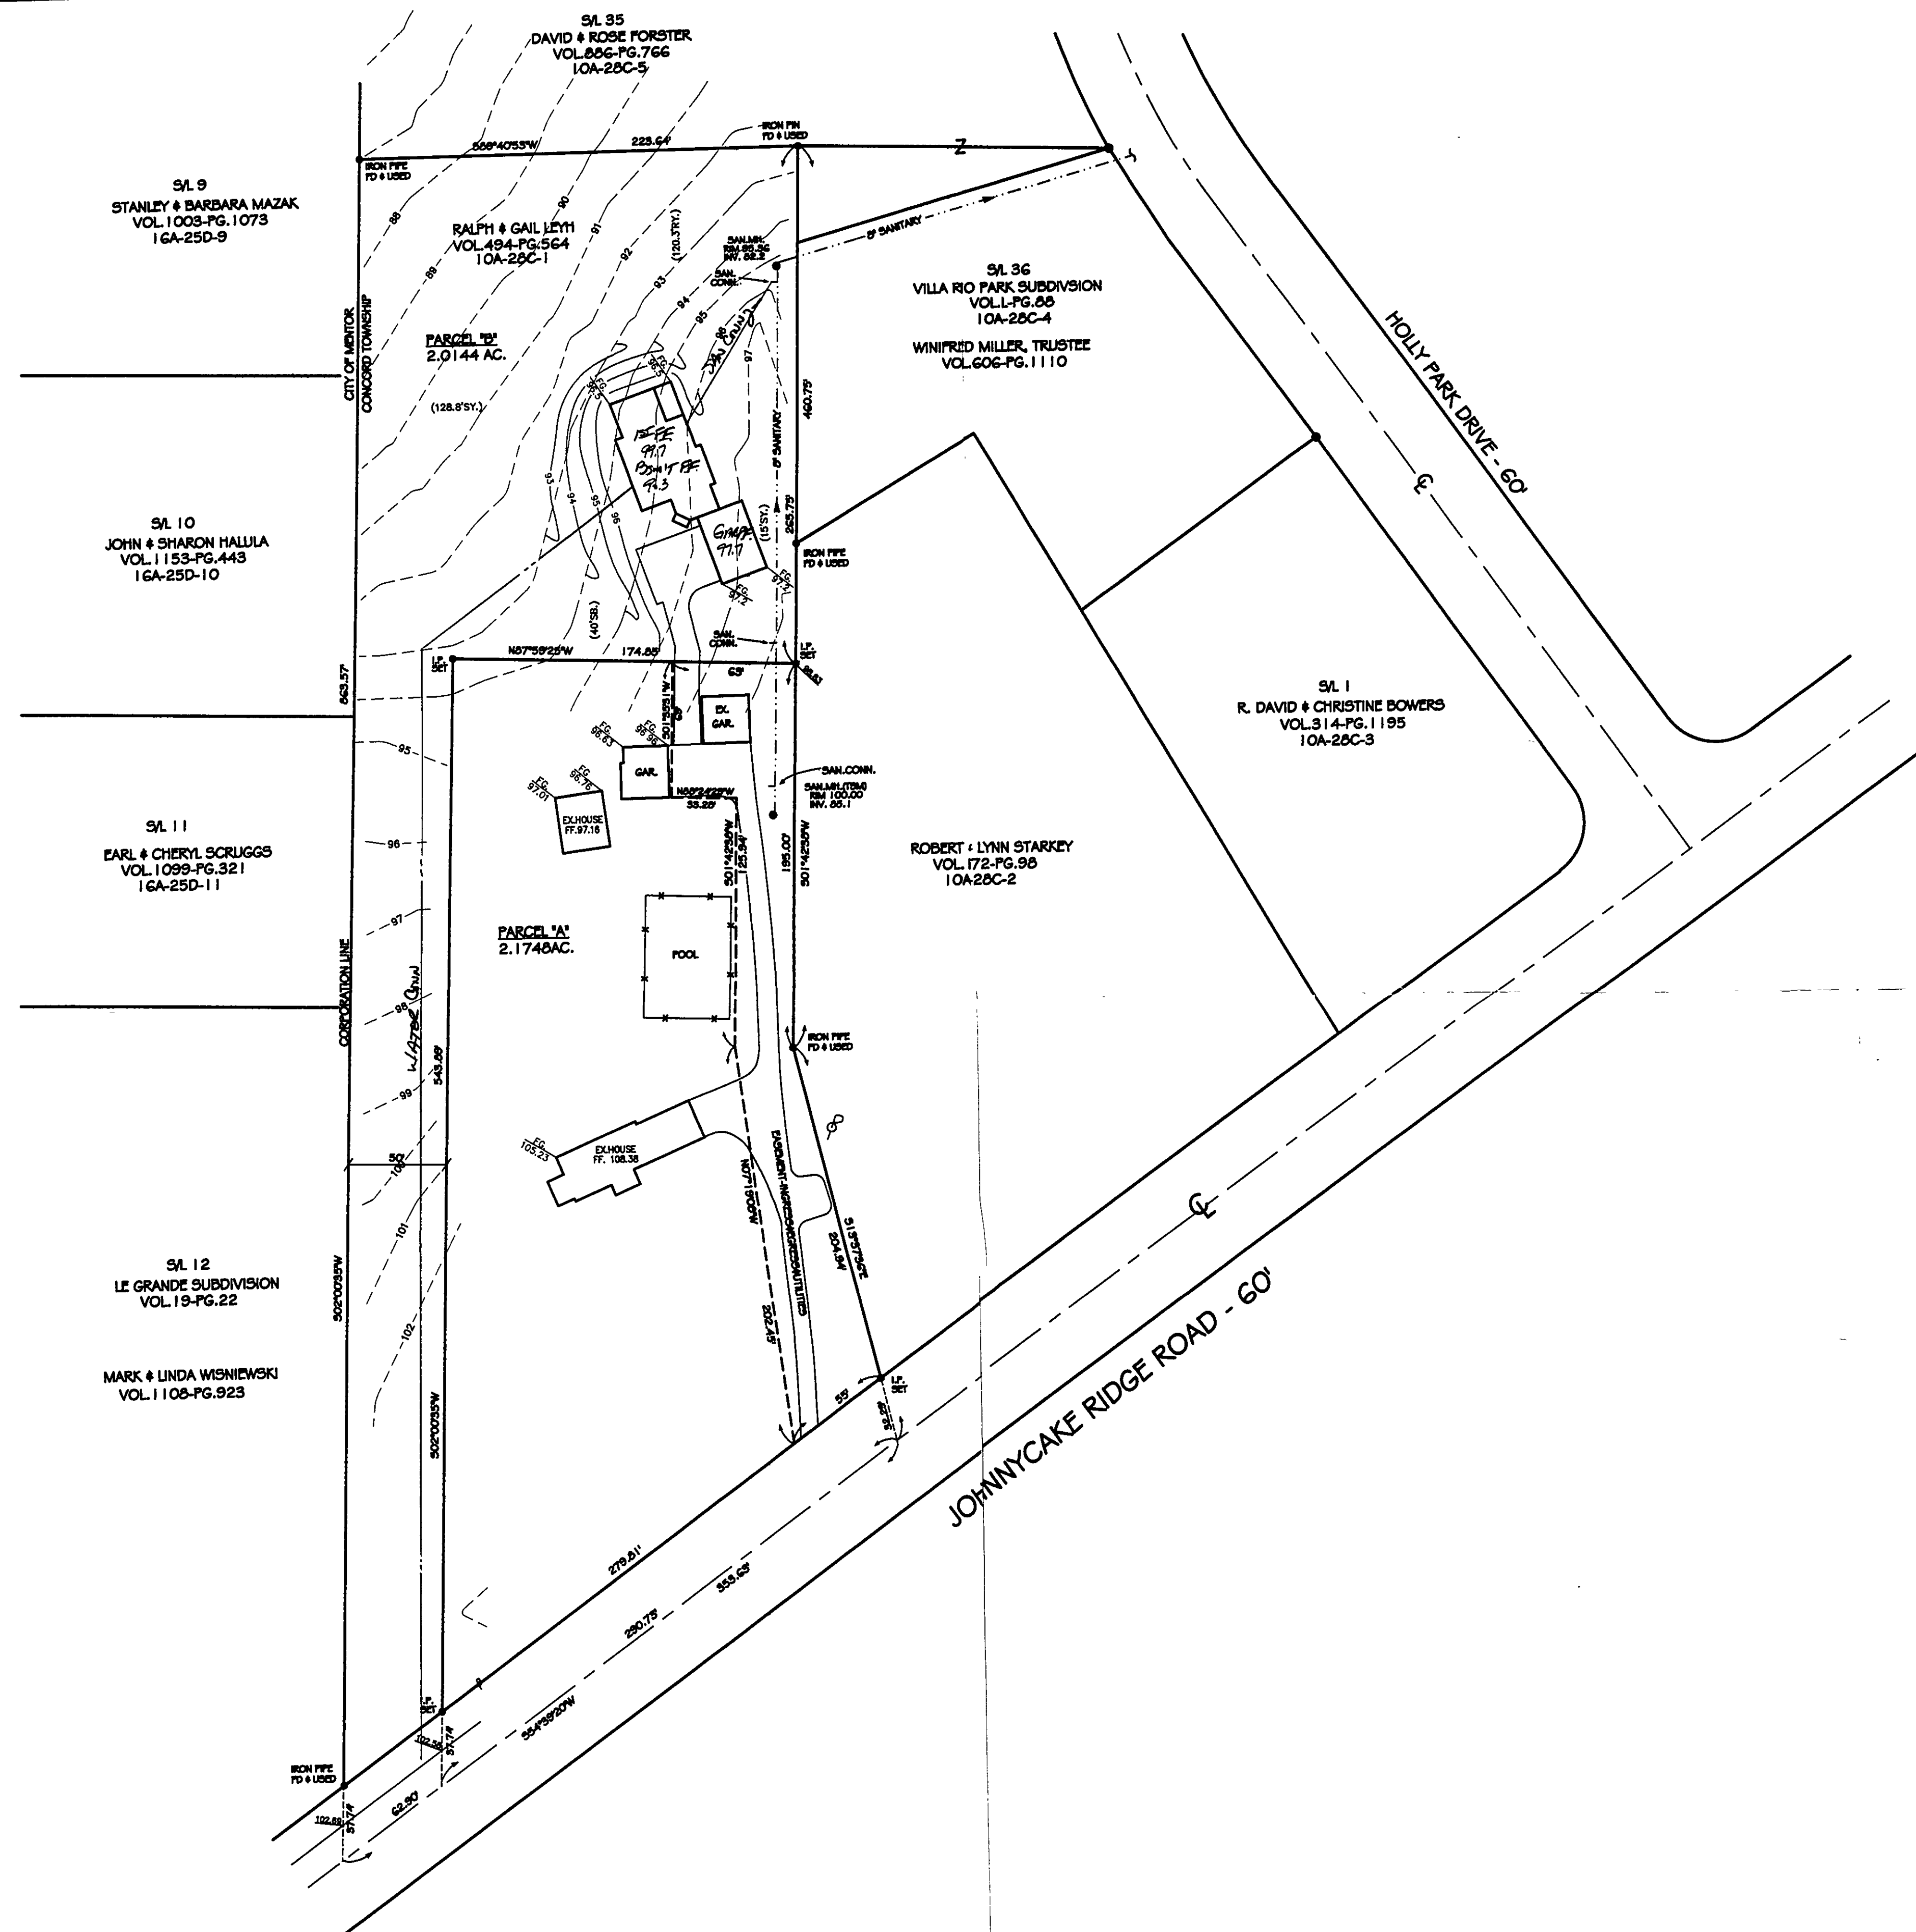

ZONING PERMIT #0718-9126
 ISSUED 7/1/98
 SUBJECT TO APPROVAL BY:
 Lake County Sanitary Eng. ☐
 Lake County Eng. Dept. ☒
 Lake County Planning Comm. ☐
 Lake County Bldg. Dept. ☒

Grading Plan Approved
 as shown and described by
 THOMAS P. GILLES, P.E.
 Lake County Engineer
 By G.H. Date 7.1.98

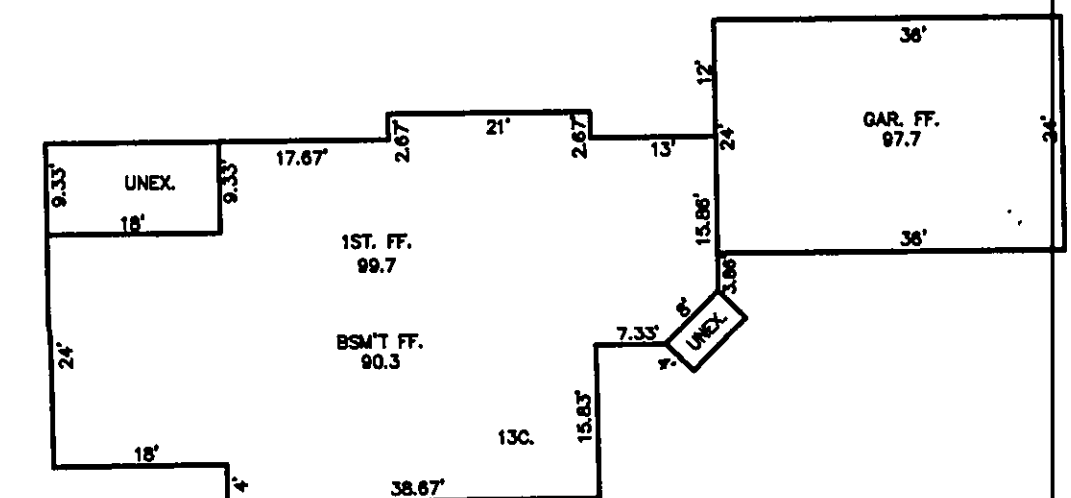

REV. NO.	DESCRIPTION	DATE	BY	CHK'D
1	REVISE HOUSE LOCATION	6/30/98	T.R.	H.J.

bj BABCOCK, JONES AND ASSOCIATES, INC
 CIVIL ENGINEERS - SURVEYORS - LAND PLANNERS
 PAINESVILLE OHIO 44077

DATE 3/26/98
 DESIGN BY H.J.
 DRAWN BY T.R. & M.S.
 APPROVED BY H.J.

SITE PLAN
 FOR
 BILL TOMPKINS
 JOHNNYCAKE RIDGE RD. CONCORD TWP. LAKE COUNTY

SCALE 1" = 50'
 JOB NO 97-267
 SHEET 1 OF 1