



GRAPHIC SCALE

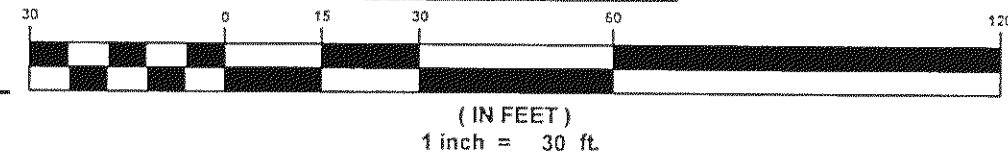

REVISIONS	BY
REVISED HOUSE MARCH 23, 2005	WSO
REVISED HOUSE APR. 05, 2005	WSO

Barrington
CONSULTING GROUP, INC.
9114 TYLER BLVD., MENTOR, OHIO 44060
PHONE 440.295.1260 FAX 440.295.1262
BCG@BarringtonCGI.com

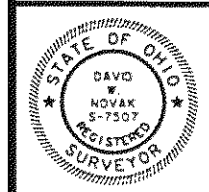

SITE PLAN
SIL 63 KARABOO TR. CONCORD, OH. 44077
MOUNTAINSIDE FARMS SUBDIVISION PH. 2
K & F QUALITY HOMES, INC.

DRAWN WSO	CHECKED OWN
DATE FEB. 28, 2005	SCALE 1" = 30'
JOB NO. 05003-63	SHEET 1/2
OF	SHEETS

GENERAL NOTES:

1. BENCHMARK - TOP STEM OF EXISTING FIRE HYDRANT LOCATED IN FRONT SUBLOT 65, ELEVATION = 948.74.
2. DRIVEWAY APRON TO BE 6" THICK CONCRETE.
3. ALL DOWNSPOUTS TO BE OUTLETED TO SPLASH BLOCKS.
4. CONTRACTOR RESPONSIBLE FOR CONTACTING THE OHIO UTILITY PROTECTION SERVICE (1.800.362.2764) AND ALL UTILITY COMPANIES A MINIMUM OF 48 HOURS PRIOR TO CONSTRUCTION.
5. THE LOCATION BOTH HORIZONTAL AND VERTICAL OF EXISTING UNDERGROUND UTILITIES SHOWN HEREON, HAVE BEEN OBTAINED BY A DILIGENT AND COMPREHENSIVE SEARCH OF AVAILABLE RECORDS. VERIFICATION BY FIELD OBSERVATION HAS BEEN CONDUCTED WHERE PRACTICAL, HOWEVER, BARRINGTON CONSULTING GROUP, INC. DOES NOT GUARANTEE THE COMPLETENESS, NOR ACCURACY THEREOF.
6. CONTRACTOR SHALL VERIFY ELEVATIONS OF LATERAL INVERTS IN THE FIELD PRIOR TO FOUNDATION EXCAVATION.
7. SEE SHEET 2 FOR EROSION AND SEDIMENT-CONTROL PLAN
8. SEE SHEET 2 FOR SEEDING INFORMATION

CERTIFICATION :



"I THE UNDERSIGNED HEREBY CERTIFIES THAT THIS TOPOGRAPHY INDICATED BY 1 FOOT CONTOURS AND ELEVATION SHOWN HEREON REPRESENTS AN ACTUAL SURVEY MADE BY ME ON THE 7th DAY OF FEBRUARY, 2005 AND THE ELEVATIONS WERE TAKEN AT AN APPROPRIATE INTERVAL AND AS OF THAT DAY THEY EXISTED AS INDICATED HEREON.

"I HEREBY CERTIFY THAT THIS PLAN WAS PREPARED BY ME AND IS CORRECT TO THE BEST OF MY KNOWLEDGE AND BELIEF"

David Novak
DAVID NOVAK, P.E., N.M.S. OFFICE

CONCORD TOWNSHIP ZONING OFFICE
Zoning Permit # 0605-12219
Date Issued 6/2/05

- Subject to Approval By:
- ☒ Lake Co. Engineer/Storm Water Mgmt.
 - ☒ Lake Co. Utilities Dept
 - ☒ Lake Co. Soil & Water District
 - ☐ Lake Co. Health District
 - ☒ Lake Co. Building Dept.

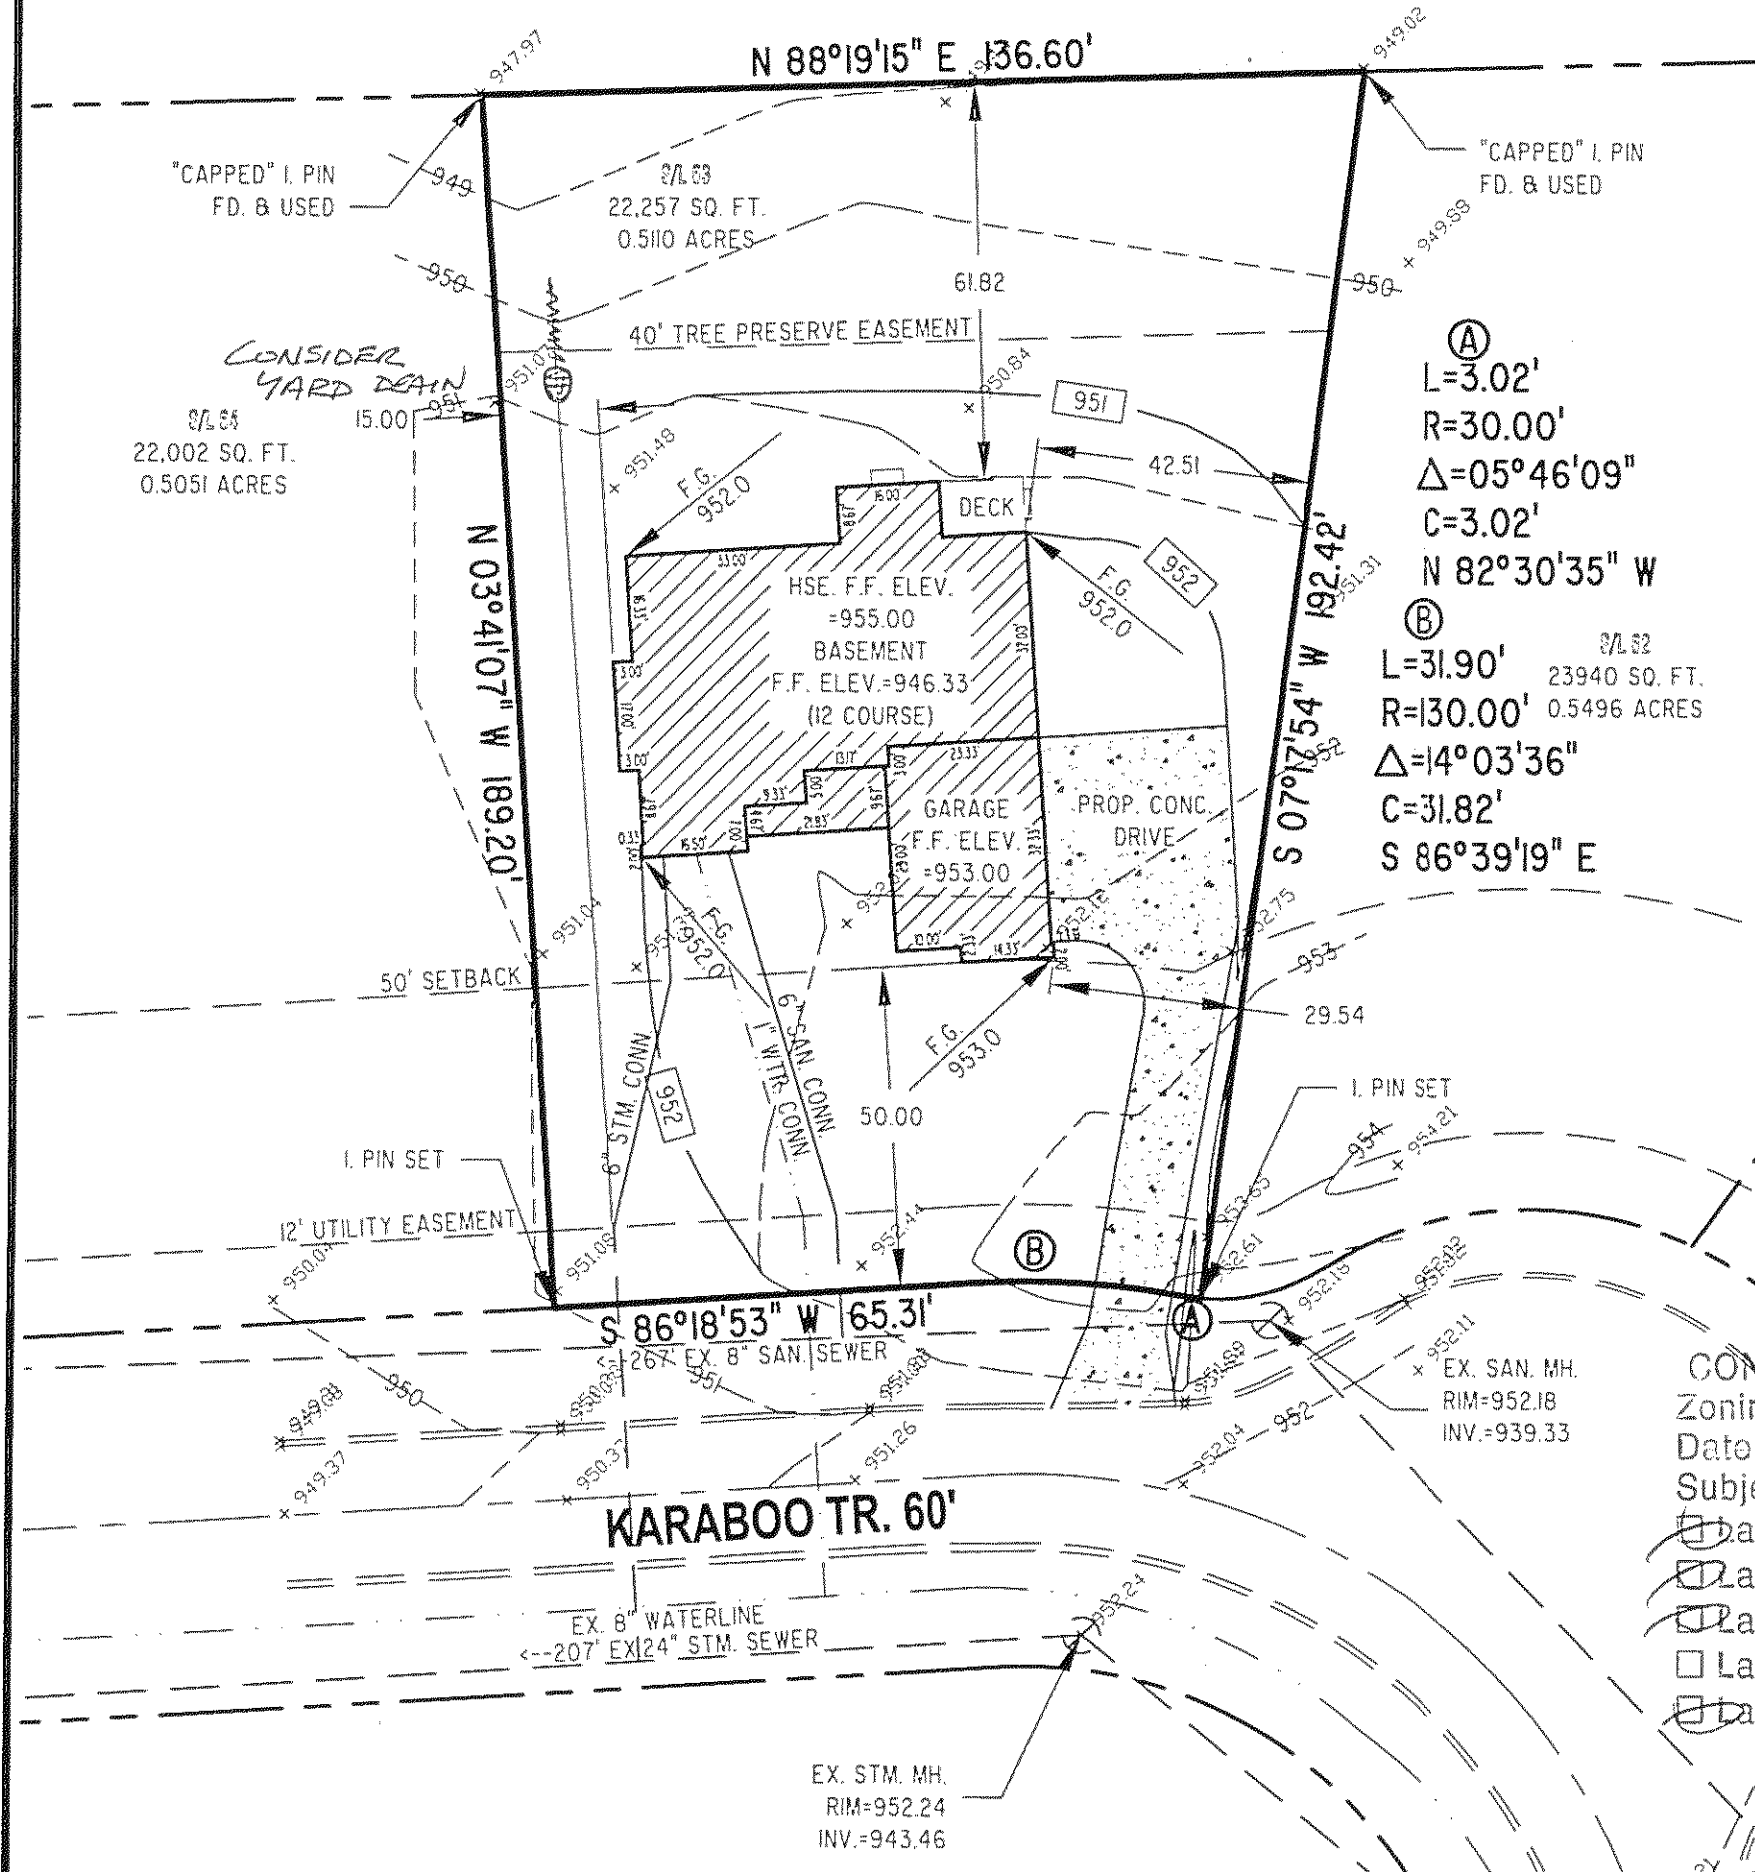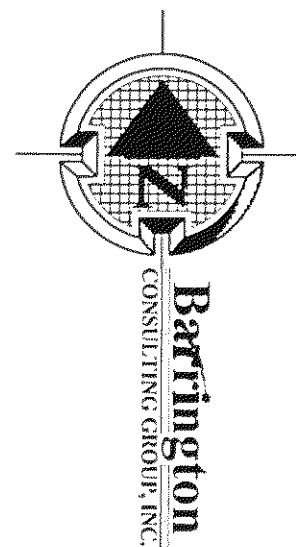

W:\2005\10\00\10\00\03\03.dwg, 04/02/2005 09:50:37 AM, Copyrighted Barrington Consulting Group