
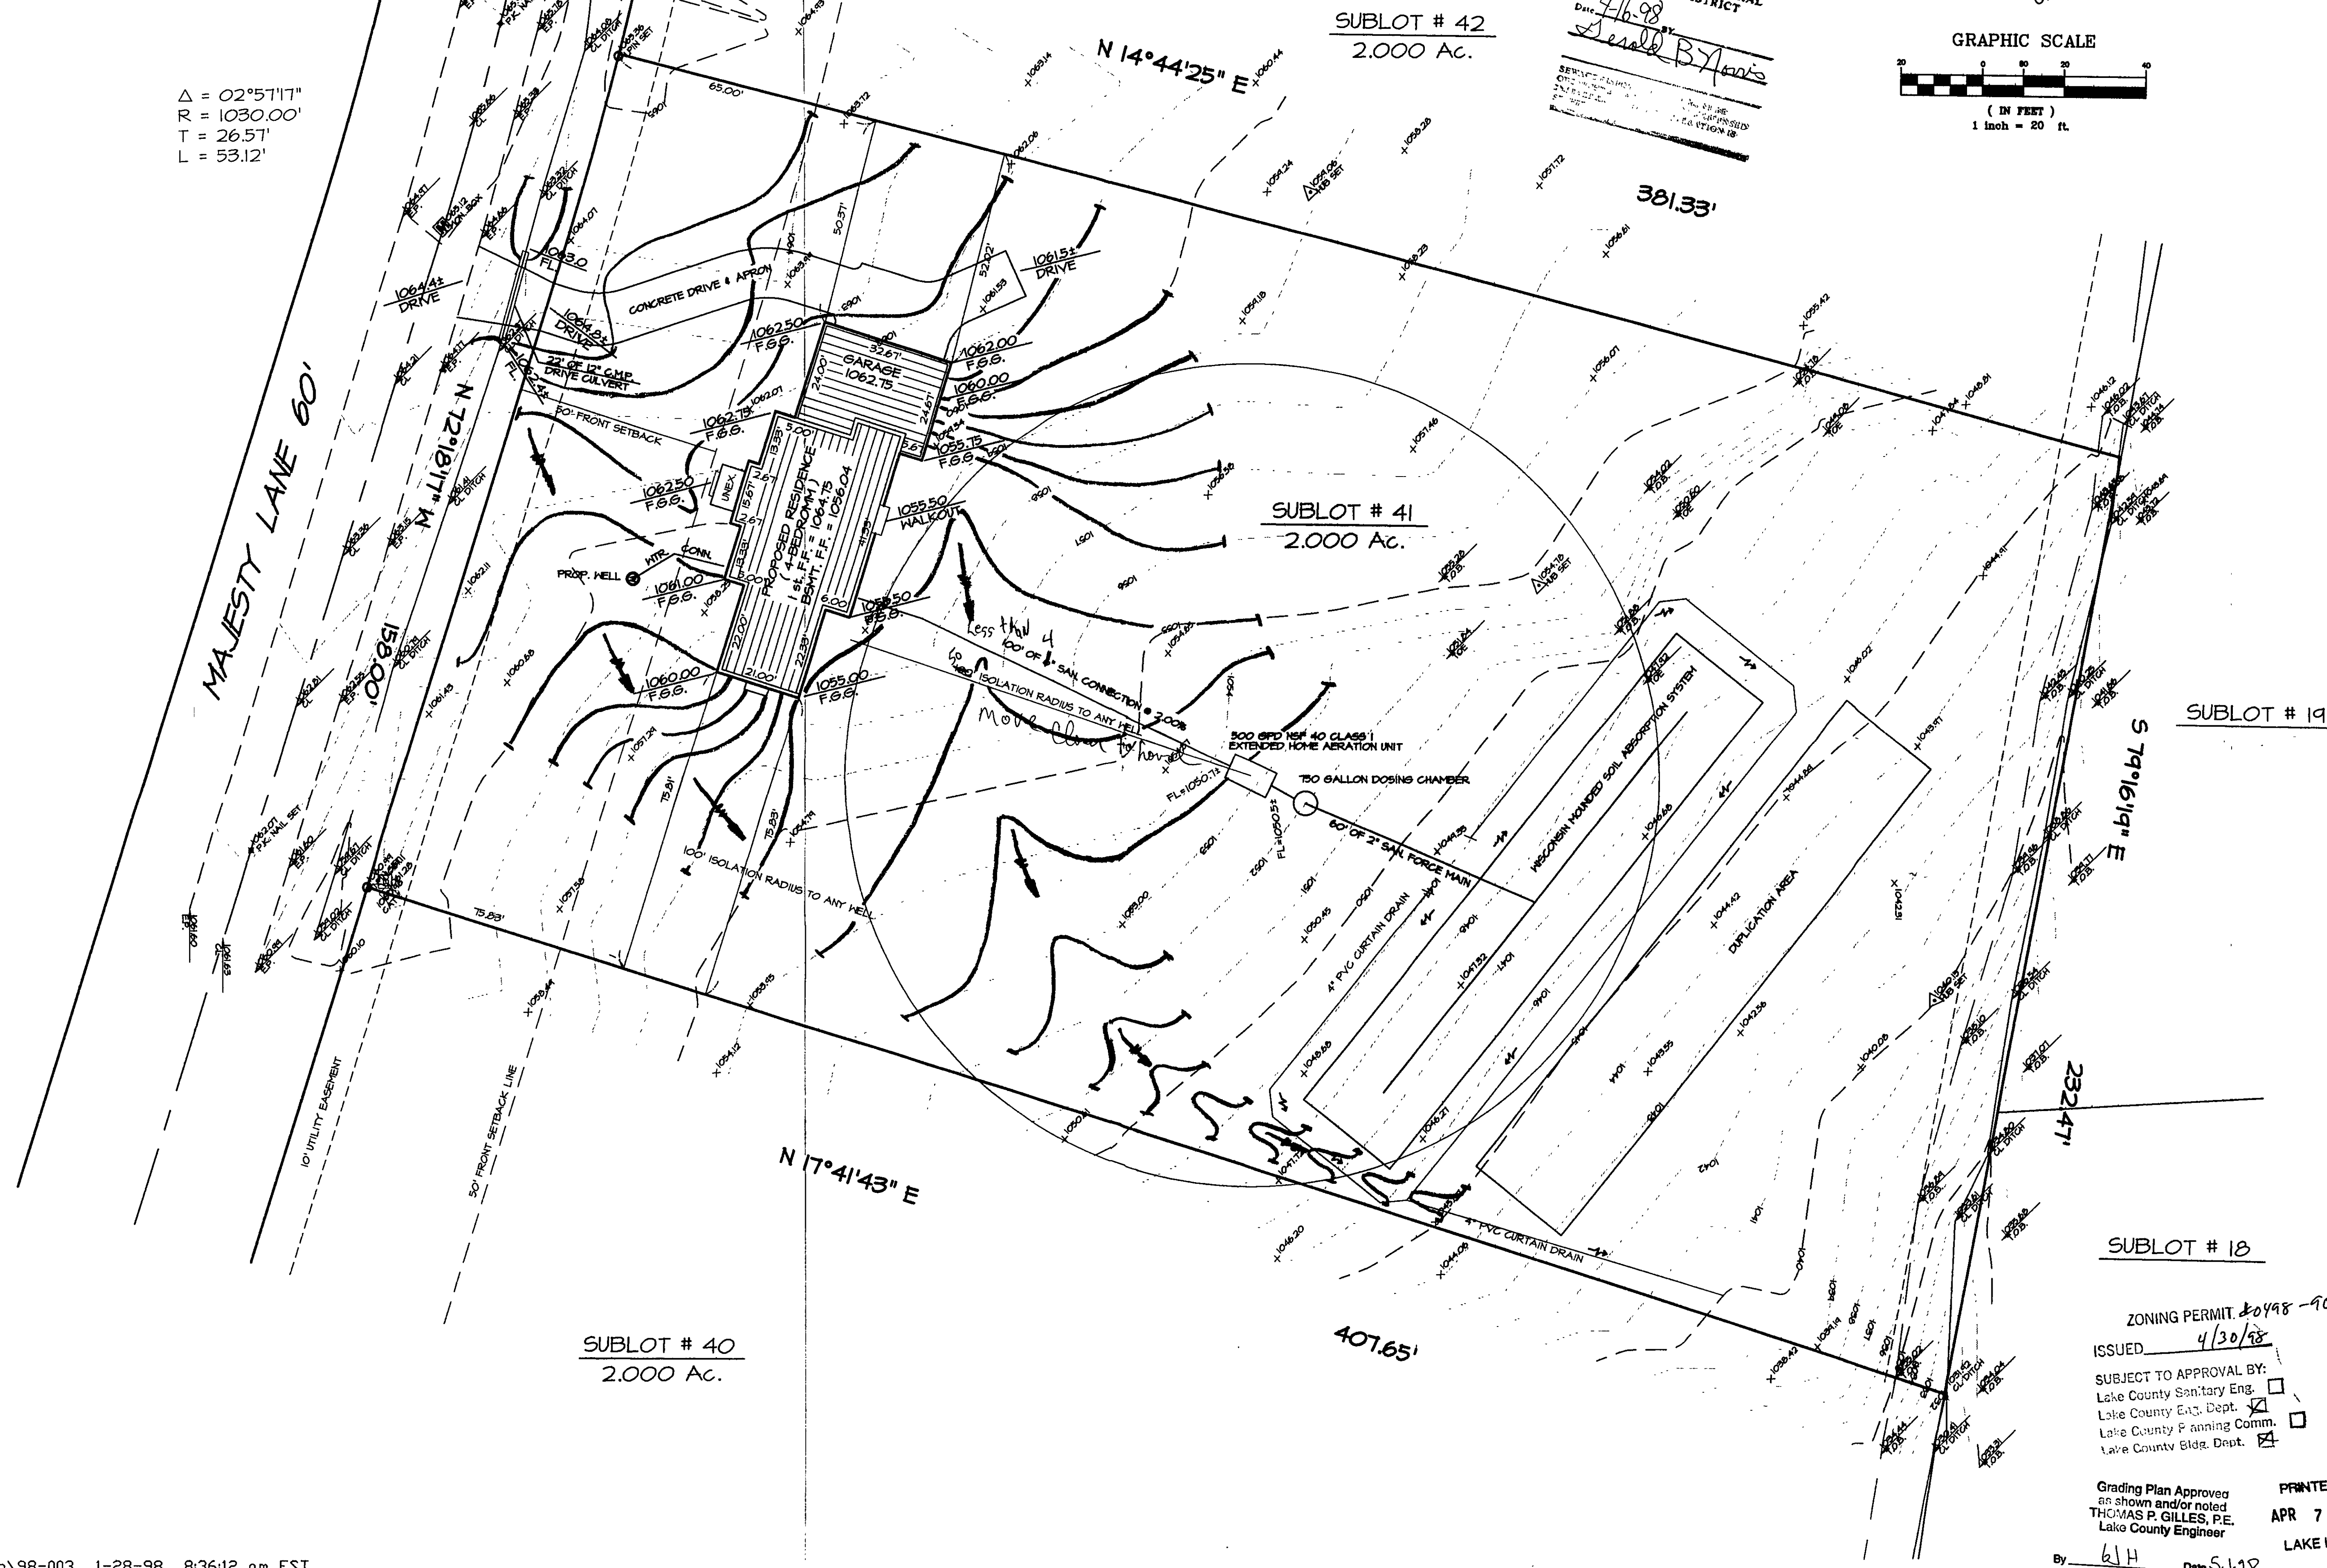


REVIEWED AND ACCEPTED
LAKE COUNTY GENERAL
HEALTH DISTRICT

DIC 4/6-98 BY
Arnold B. Norris

SERIALIZED
INDEXED
FILED

APR 6 1998
FBI - LAKE COUNTY
SECTION 18

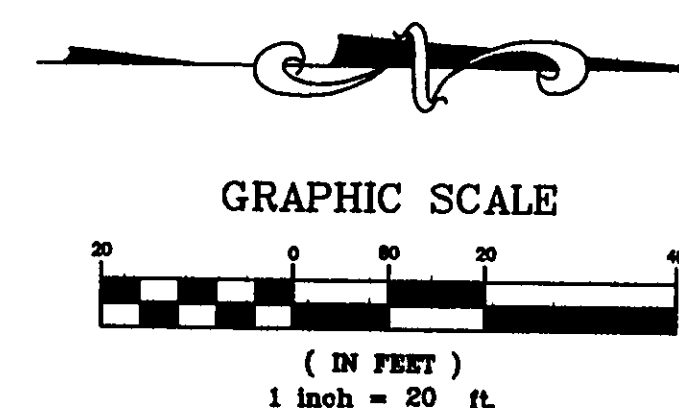

LAKE, INC.
ENGINEERS & SURVEYORS
30601 EUCLID AVENUE WICKLIFFE, OHIO 44092
PHONE: (216) 585-2700 FAX: (216) 585-5122

[illegible]

SITE PLAN for
MR. & MRS. TOMMASONE
CONCORD, LAKE COUNTY, OHIO

Drawn By	D.P.
Filename:	98-003R
Checked By:	
Approved By:	
Date:	FEB. 1998

S/L # 41

Scale:		
1"=20'		
Sheet No.		of
1		2