
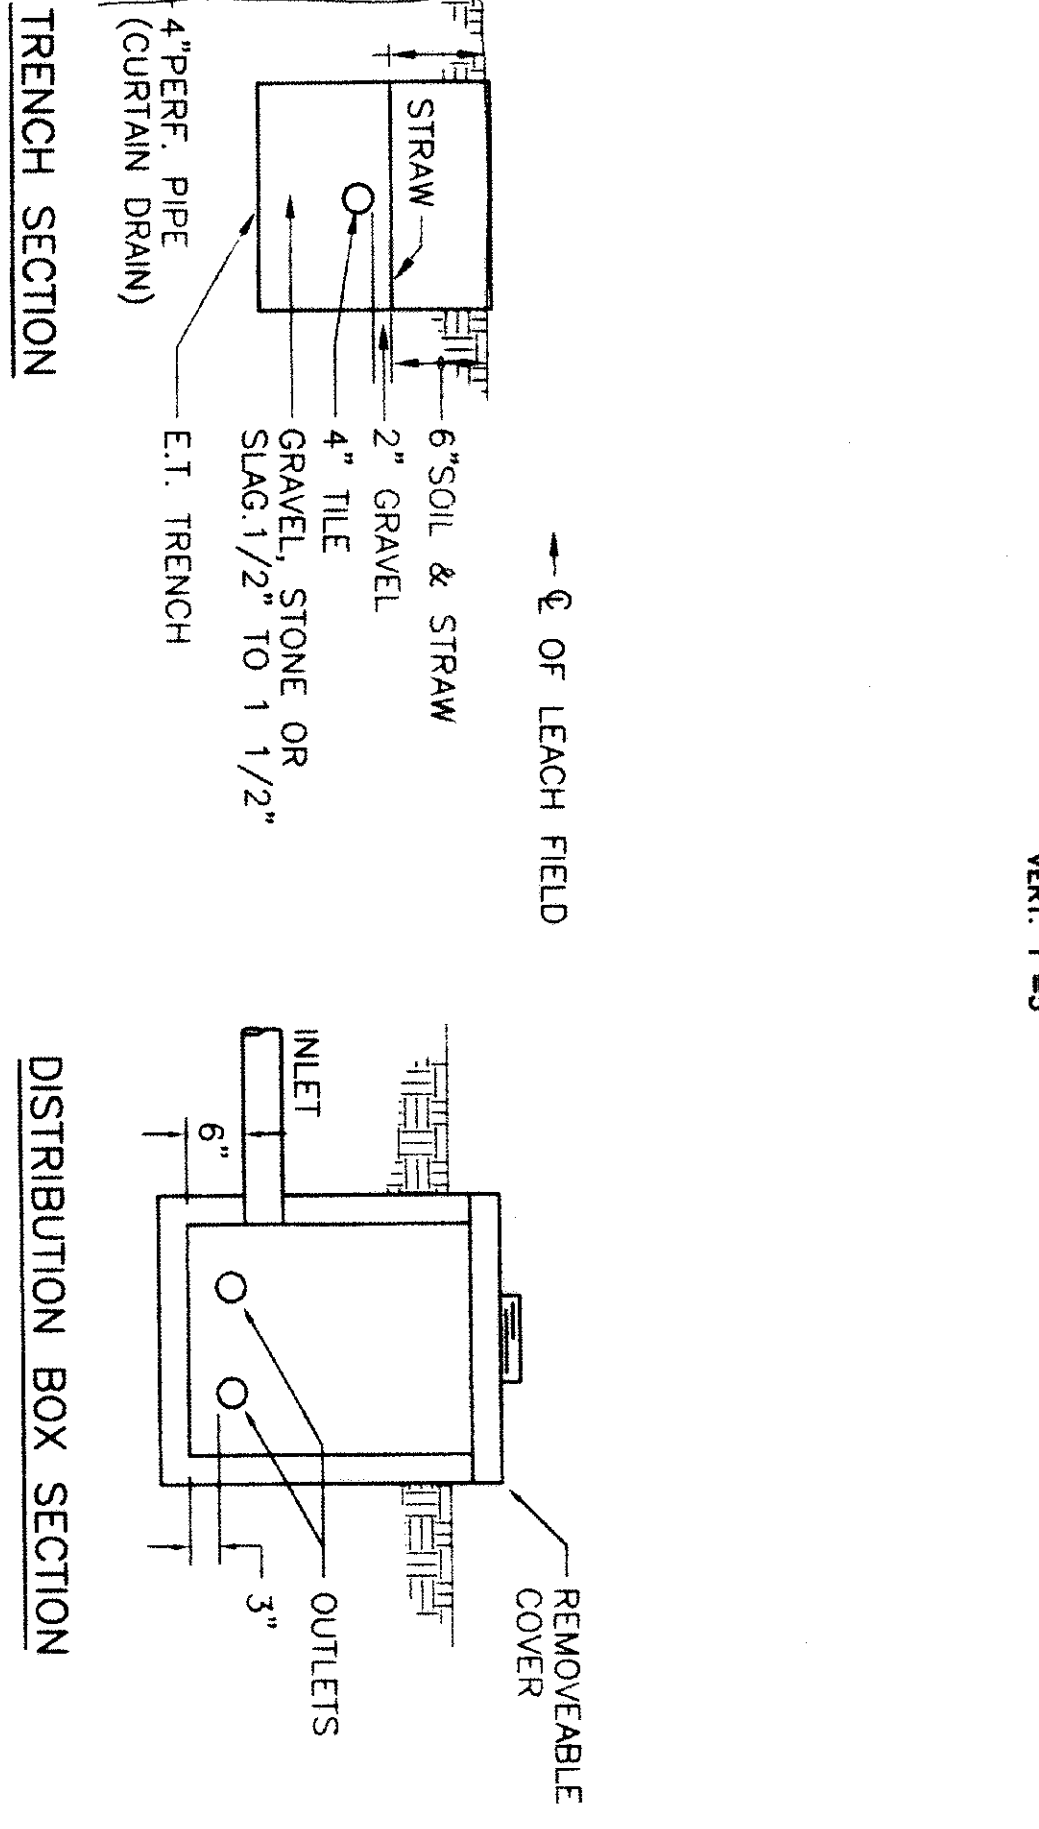


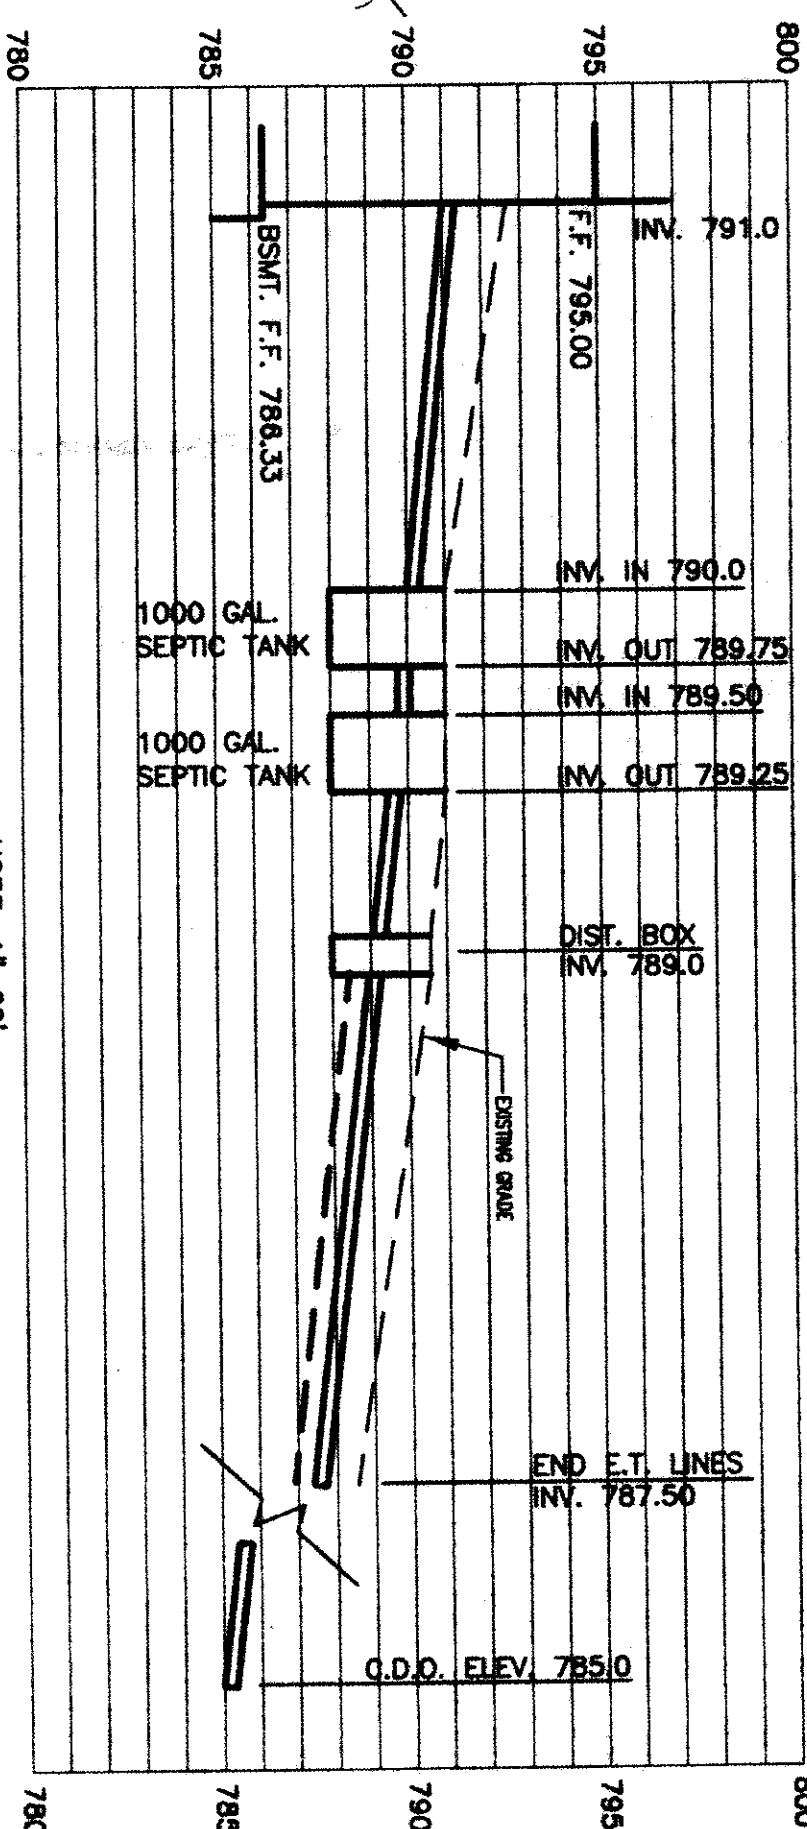

EVAPO-TRANSPIRATION TILE FIELD


LOW YIELD WATER FIXTURES REQUIRED ON ALL Shower Head Toilet

REMARKS: ALL BOUNDARY DATA SHOWN WAS OBTAINED FROM DEEDS, RECORDED SUBDIVISION PLATS OR OTHER PUBLIC RECORDS.

DESIGN CERTIFICATION: THIS PLAN WAS PREPARED UNDER MY SUPERVISION, AND IS CORRECT TO THE BEST OF MY KNOWLEDGE.

NO.	DESCRIPTION	DATE	BY
1	DESIGN	10/31/96	DAVID A. RAPP
2	REVISION		

CURVE	1	2
RADIUS	30.00'	1203.80'
LENGTH	45.66'	173.14'
CHORD	41.38'	172.99'
BEARING	N 54°11'21"W, S 86°19'29"W	

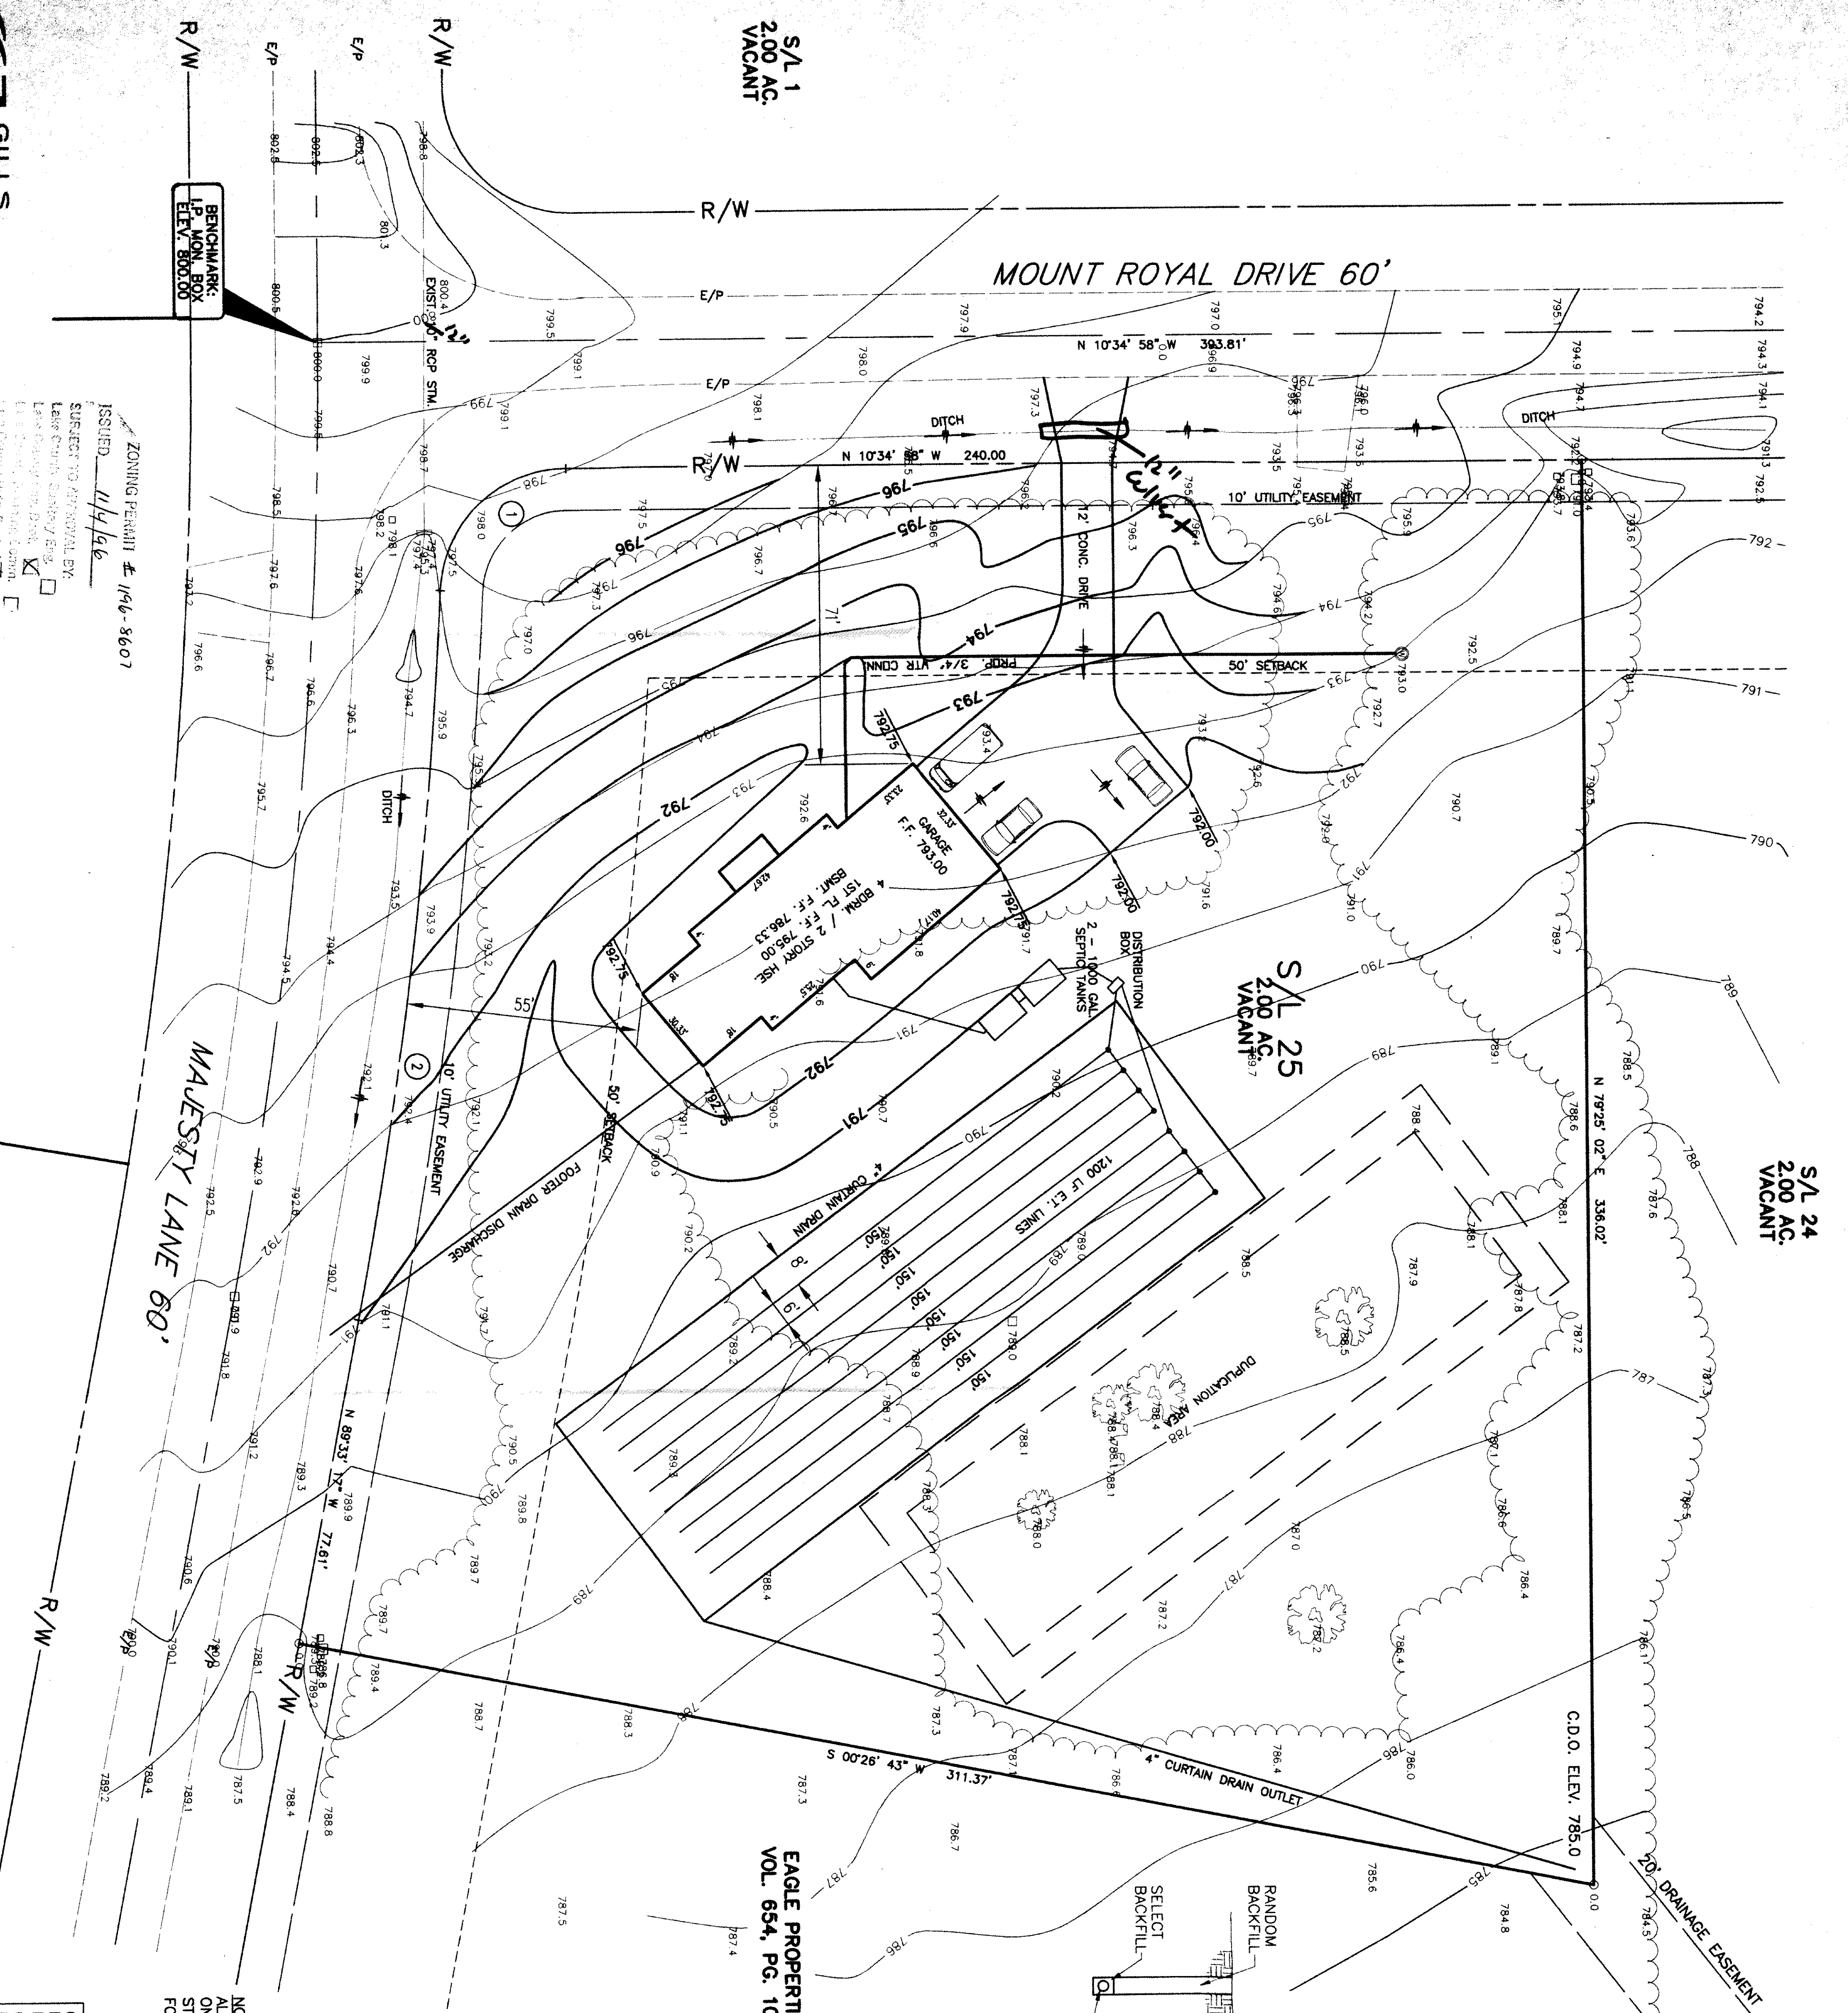

ISSUED: 11/4/96
SUBJECT TO APPROVAL BY:
Lake County Engineer's Office
E.O. 12812, Affirmative Action
U.S. Department of Housing and Urban Development