

TOPOGRAPHIC SURVEY & LOT IMPROVEMENT PLAN

CONCORD TOWNSHIP - LAKE COUNTY - QUAIL HOLLOW

PROJ. DATE: 4-03-92 SCALE: 1" = 20' VDL
EXISTING GROUND FLOW DIRECTION OF EXISTING ELEVATION
PROPOSED GRADE SURFACE DRAINAGE PROPOSED ELEVATION
BUILDER: SUTTON HOMES, INC. PROPERTY CORNERS WERE FOUND OR SET AS INDICATED

ZONING PERMIT # 0532-7149

ISSUED 5-11-92

SUBJECT TO APPROVAL BY:

- ☐ Lake County Sanitary Eng.
☒ Lake County Eng. Dept.
☐ Lake County Planning Comm.
☒ Lake County Bldg. Dept.

Grading Plan Approved

as shown and/or noted


THOMAS P. GILL, P.E.

Lake County Engineer

By TH Date 5/18/92

- DISCHARGE Sump pump to MANHOLE.
- RAISE YARD DRAIN & AND REGRADE LOTS TO
SPLIT WATER RUNOFF

7361

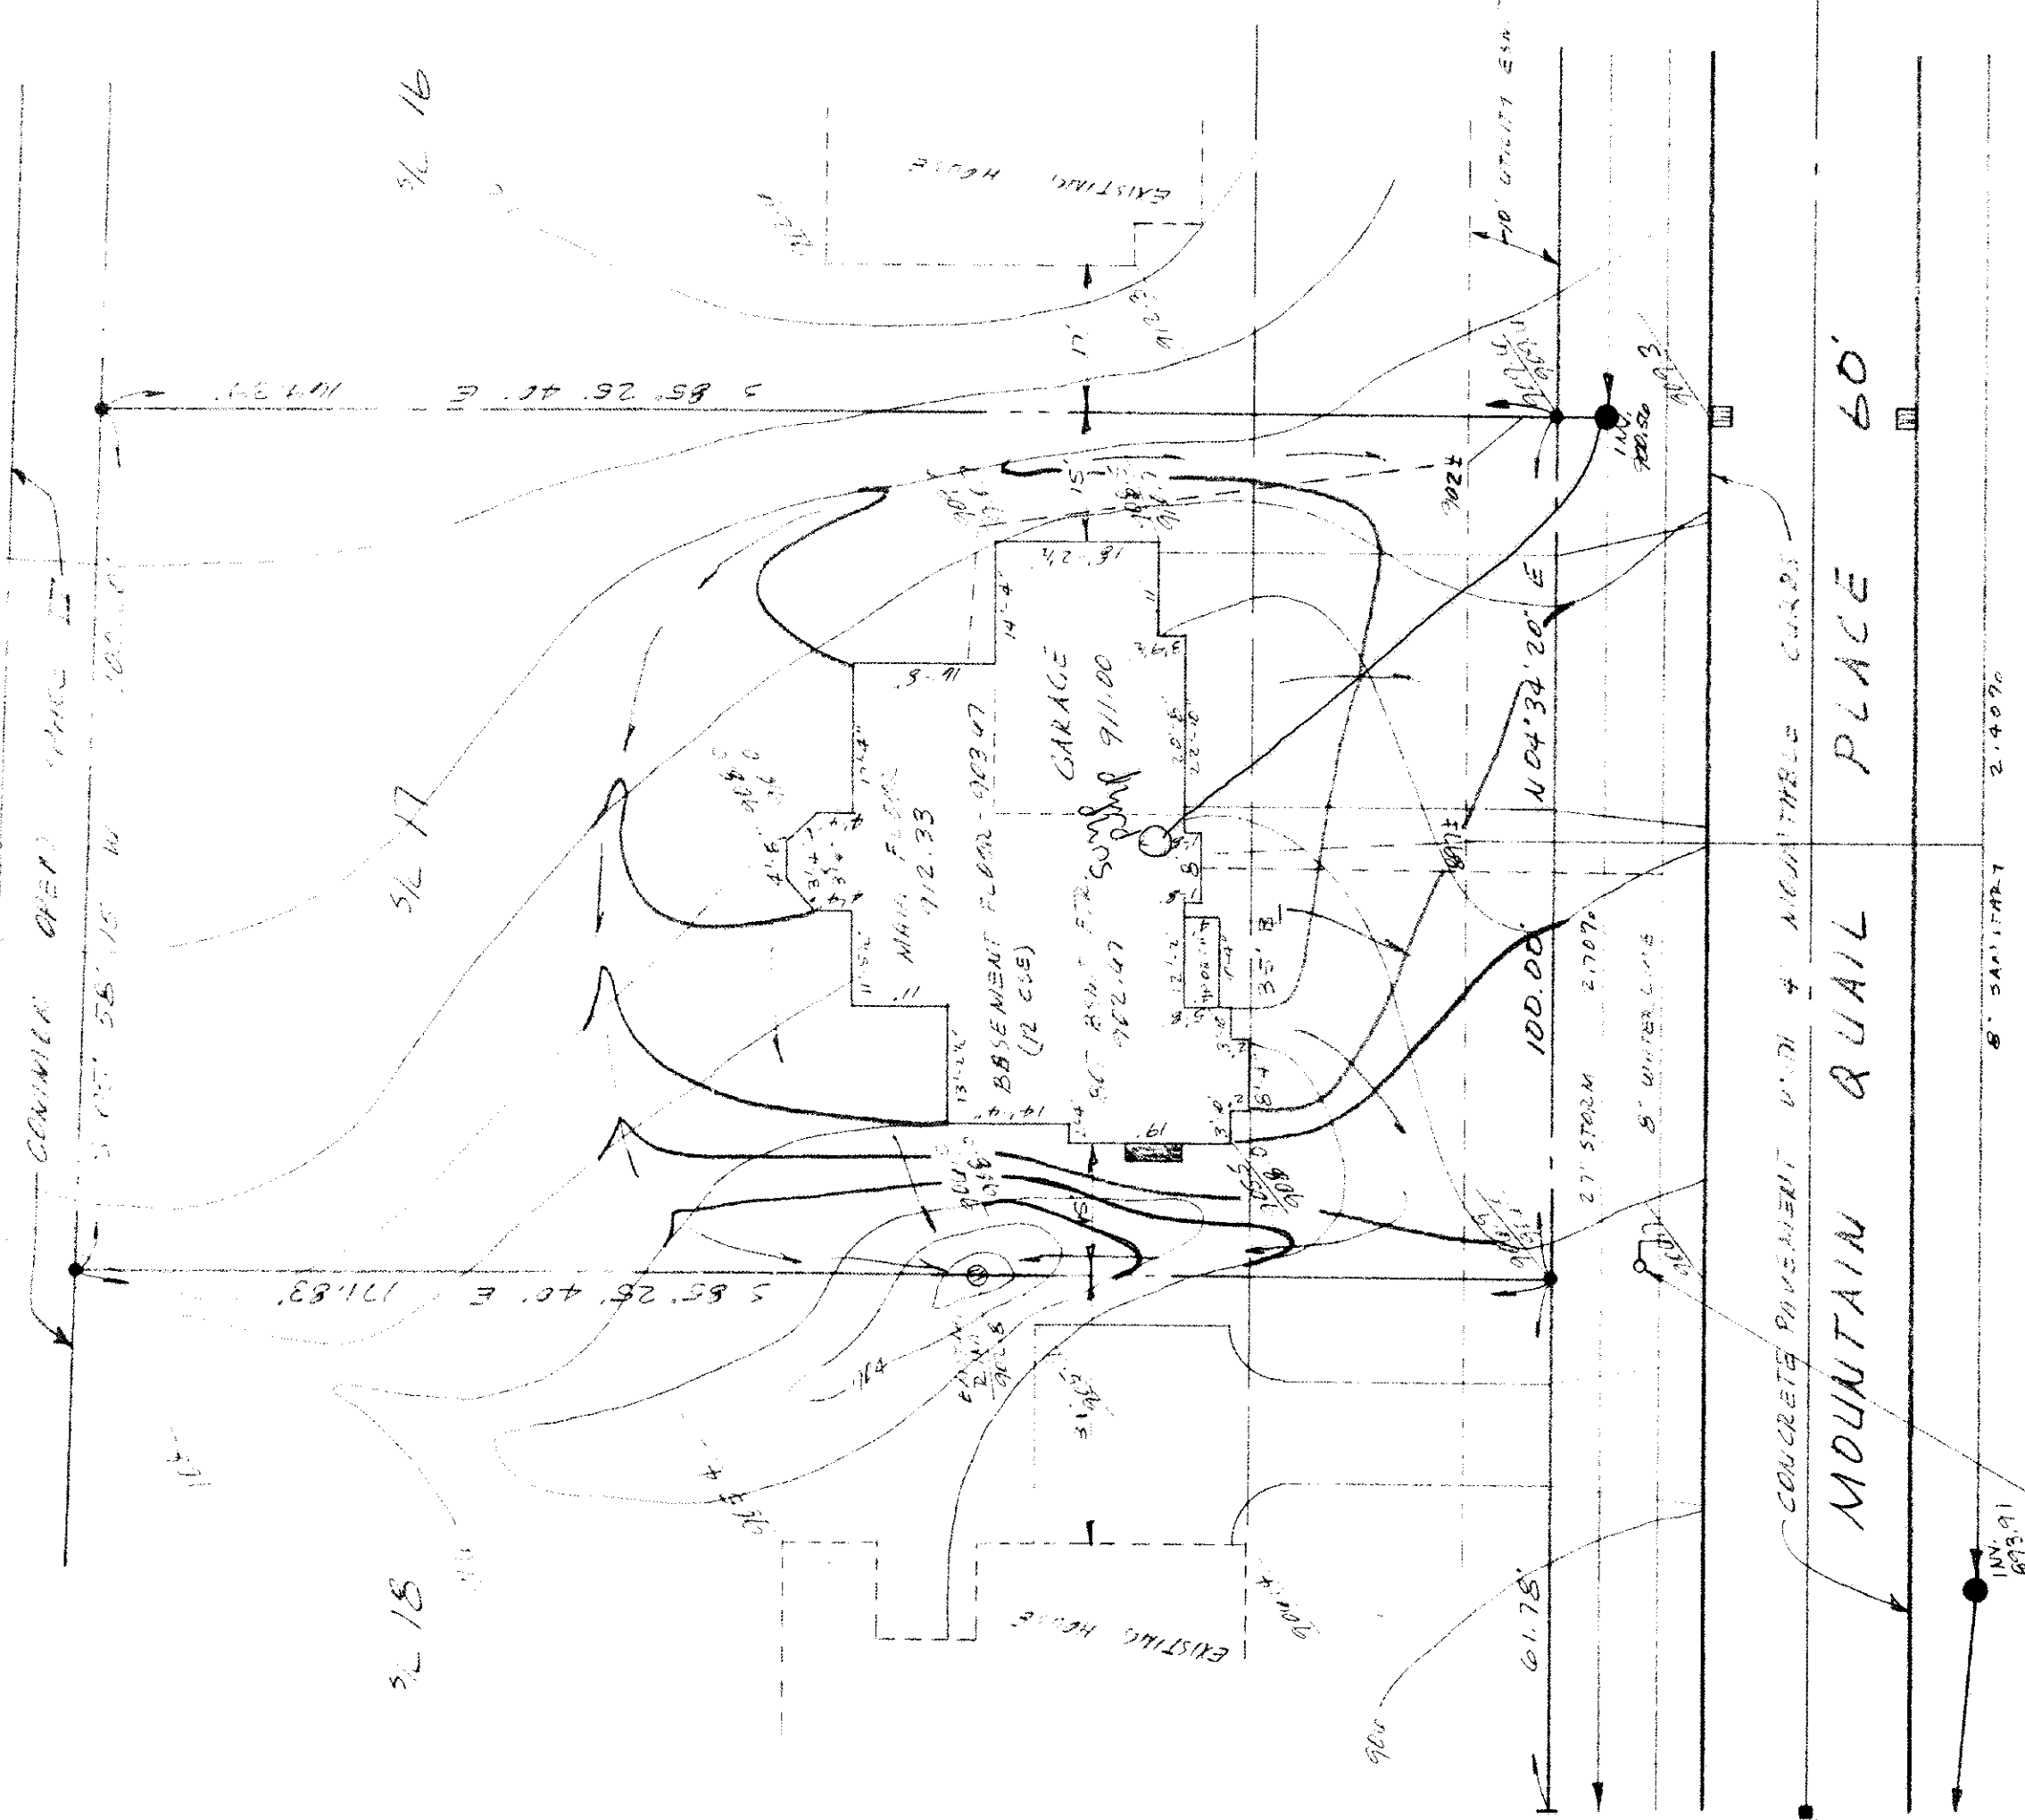

BENCH MARK: TOP OF HYDRANT, ELEV. 909.66