

WATERFORD DESIGN HOMES, INC
~~A D SIBLEY INC~~
CLIENT

20 WATERFORD LANE
ADDRESS STREET
PAINESVILLE CITY

SUBJECT No.	12	WOODS OF CONCORD	SUBDIVISION NAME	16	VOL.	27	PAGE
-------------	----	------------------	------------------	----	------	----	------

LOT, TRACT	COLOR	DIR

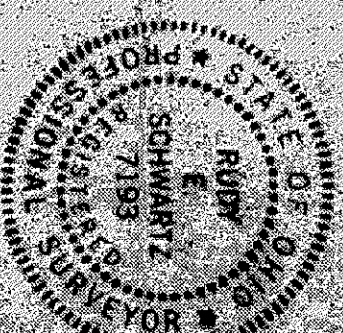
LAND DESIGN consultants
Civil Engineers and Surveyors
255 East Main St., Suite 200, and 4400
Bulwer St., and 500-5500 St.-1400

DESIGN CERTIFICATION

THIS PLAT WAS PREPARED BY ME, AND IS CORRECT TO THE BEST OF MY KNOWLEDGE AND BELIEF.

MEMO

CHECK LIST

[illegible]

AS BUILT CERTIFICATION

I HEREBY CERTIFY THAT THE CIRCLED INFORMATION IS EXISTING AS OBTAINED ON THE SITE 16 AND IS CORRECT TO THE BEST OF MY KNOWLEDGE AND BELIEF.

TABLE

DRAIN BT		SCALE
735		1" = 20'
CHED BY	DATE	
1	5/15/80	DATE REC'D 4/14/80
2		

ACCEPTED :

CLIENT	DATE

BENCHMARK: 8.44 = 7.83, SET ON RIM OF SAME FORMWORK.

11-2; ELN 703.2

ZONING PERMIT #0495-8105

ISSUED 4-19-95

SUBJECT TO APPROVAL BY

Lake County Est. 0-1-04

Lake County Bldg. Dept

92-176

