


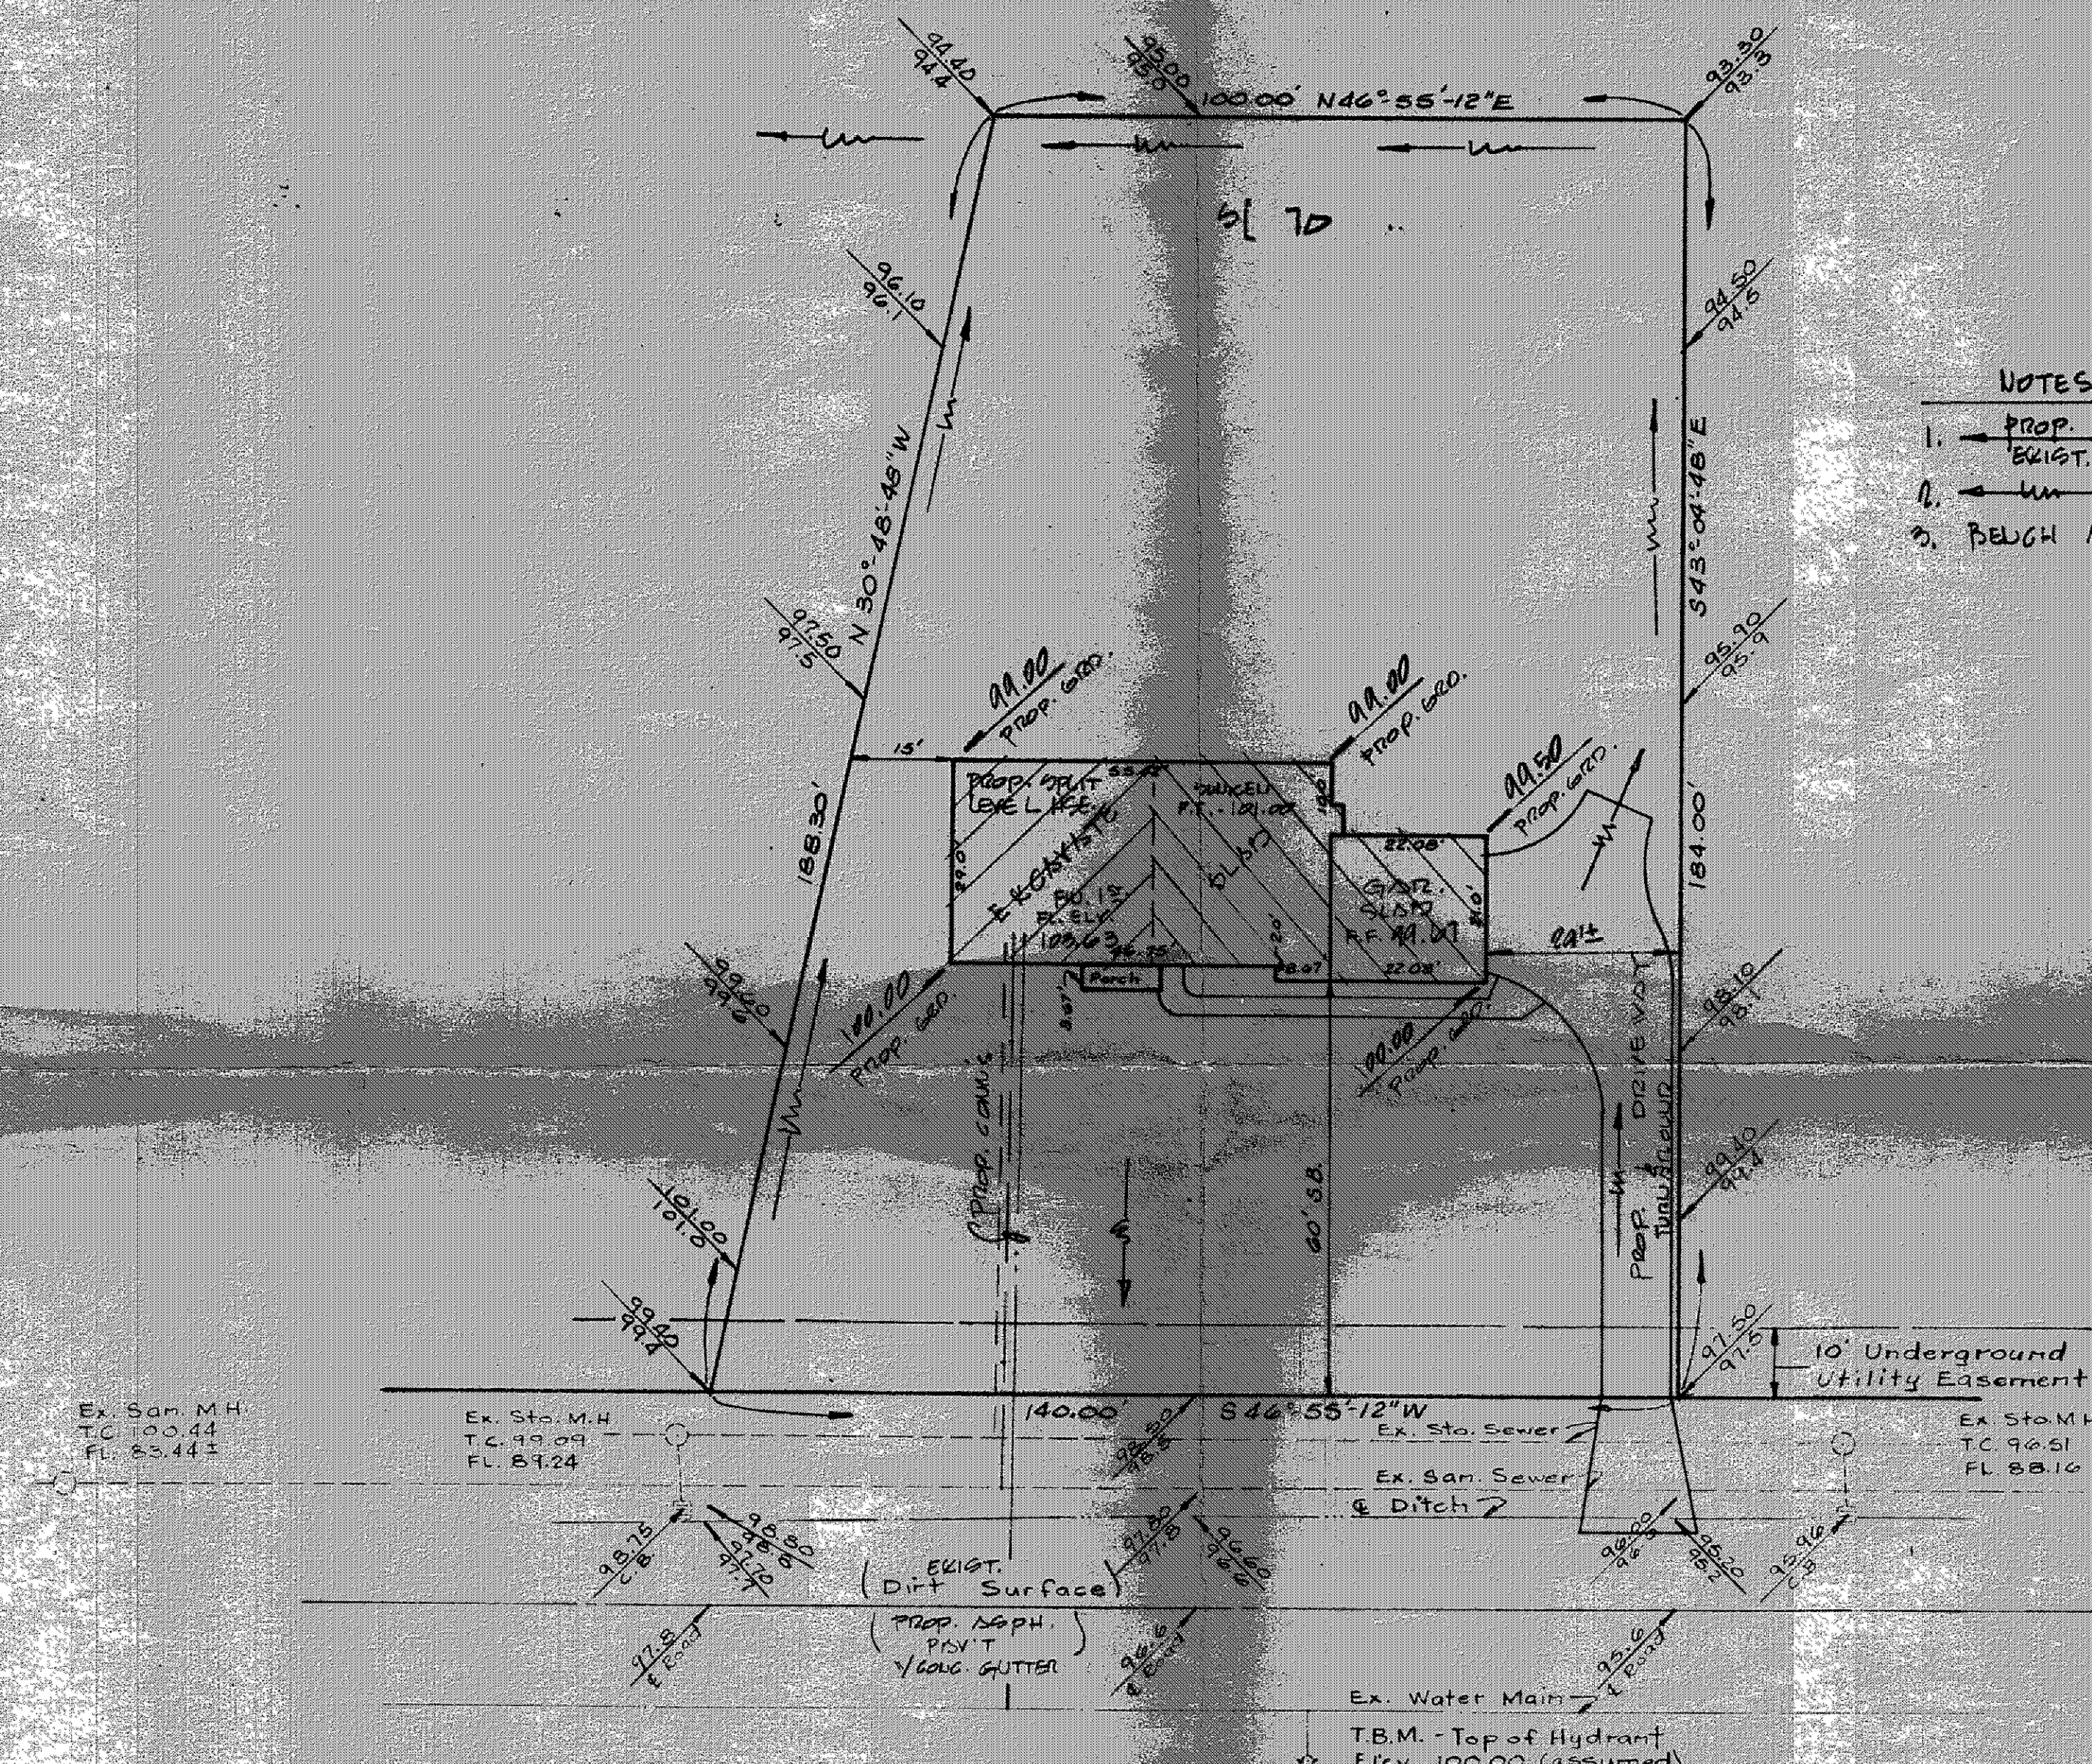

- NOTES:**
1. ~~PROP.~~ EXIST. GROUND GRADES.
 2. W OVERLAND DRAINAGE FLOW.
 3. BELCH MARK: TOP OF HYD. OPP. 4.70 ELEV. 100.00 ASSUMED


Grading Plan Approved
as shown and/or noted
THOMAS P. GILLES, P.E.
Lake County Engineer
JWG Date 6-30-75

*Joining Point # 2855
marked 6-25-75
JWG*

Oakridge Dr. 60'

PRINTED
JUN 24 1975
F. A. THOMAS & ASSOC. INC.

SCALE:
HORIZ. 1" = 20'
VERT. 1" = 20'
1 of 1 SHEETS

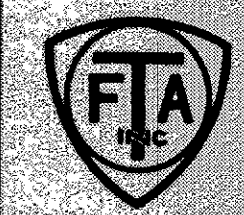

Plot Plan
of S/L 70 in the Morley Hills Ests. Subdivision No 2
for Sam Friedman
Concord Twp., Ohio

FRANK A. THOMAS & ASSOCIATES, INC.
CONSULTING ENGINEERS
WILLOUGHBY, OHIO

DRAWN BY: Smith
CHECKED BY:
DATE: 6-20-75