


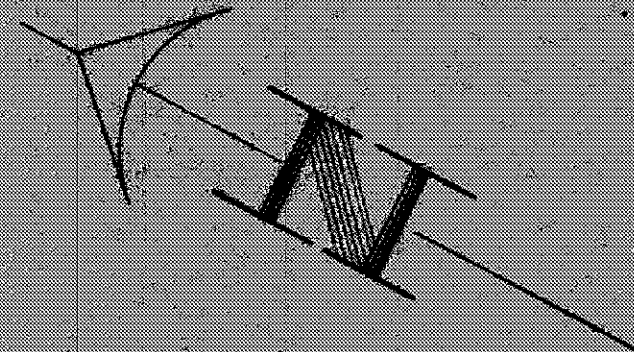

SL 5

EXISTING RAVINE
SL 6

SL 7


SITE PLAN FOR:
RYAN HOMES
23600 MERCANTILE RD.
BEACHWOOD, OHIO

BEING SUBLOT NO. 6 IN THE MORLEY HILLS ESTATES
SUBDIVISION NO. 1 IN CONCORD TWP., OHIO.

PREPARED BY:
WM. R. GRAY ASSOC. INC.
7547 MENTOR AVE.
MENTOR, OHIO

DATE: MAY 8, 1976 SCALE: 1" = 20'

CERTIFICATION:
I HEREBY CERTIFY THAT THIS PLAN IS
CORRECT TO THE BEST OF MY KNOWLEDGE.
By: Wm. R. Gray
WM. R. GRAY R.S.#2752

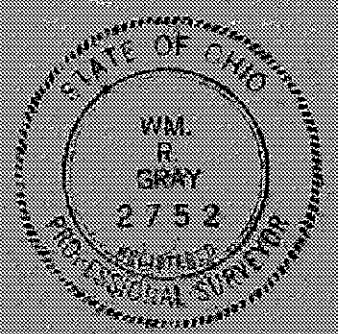

Grading Plan Approved
as shown and/or noted
THOMAS P. GILLES, P.E.
Lake County En.

By: JWK 5-11-76

ZONING PERMIT
Approved #3029 5/10/76
Randy

CURVE DATA:
R=340.32 A=27.65'
C=27.53' N. 24° 53' 11" W.

