
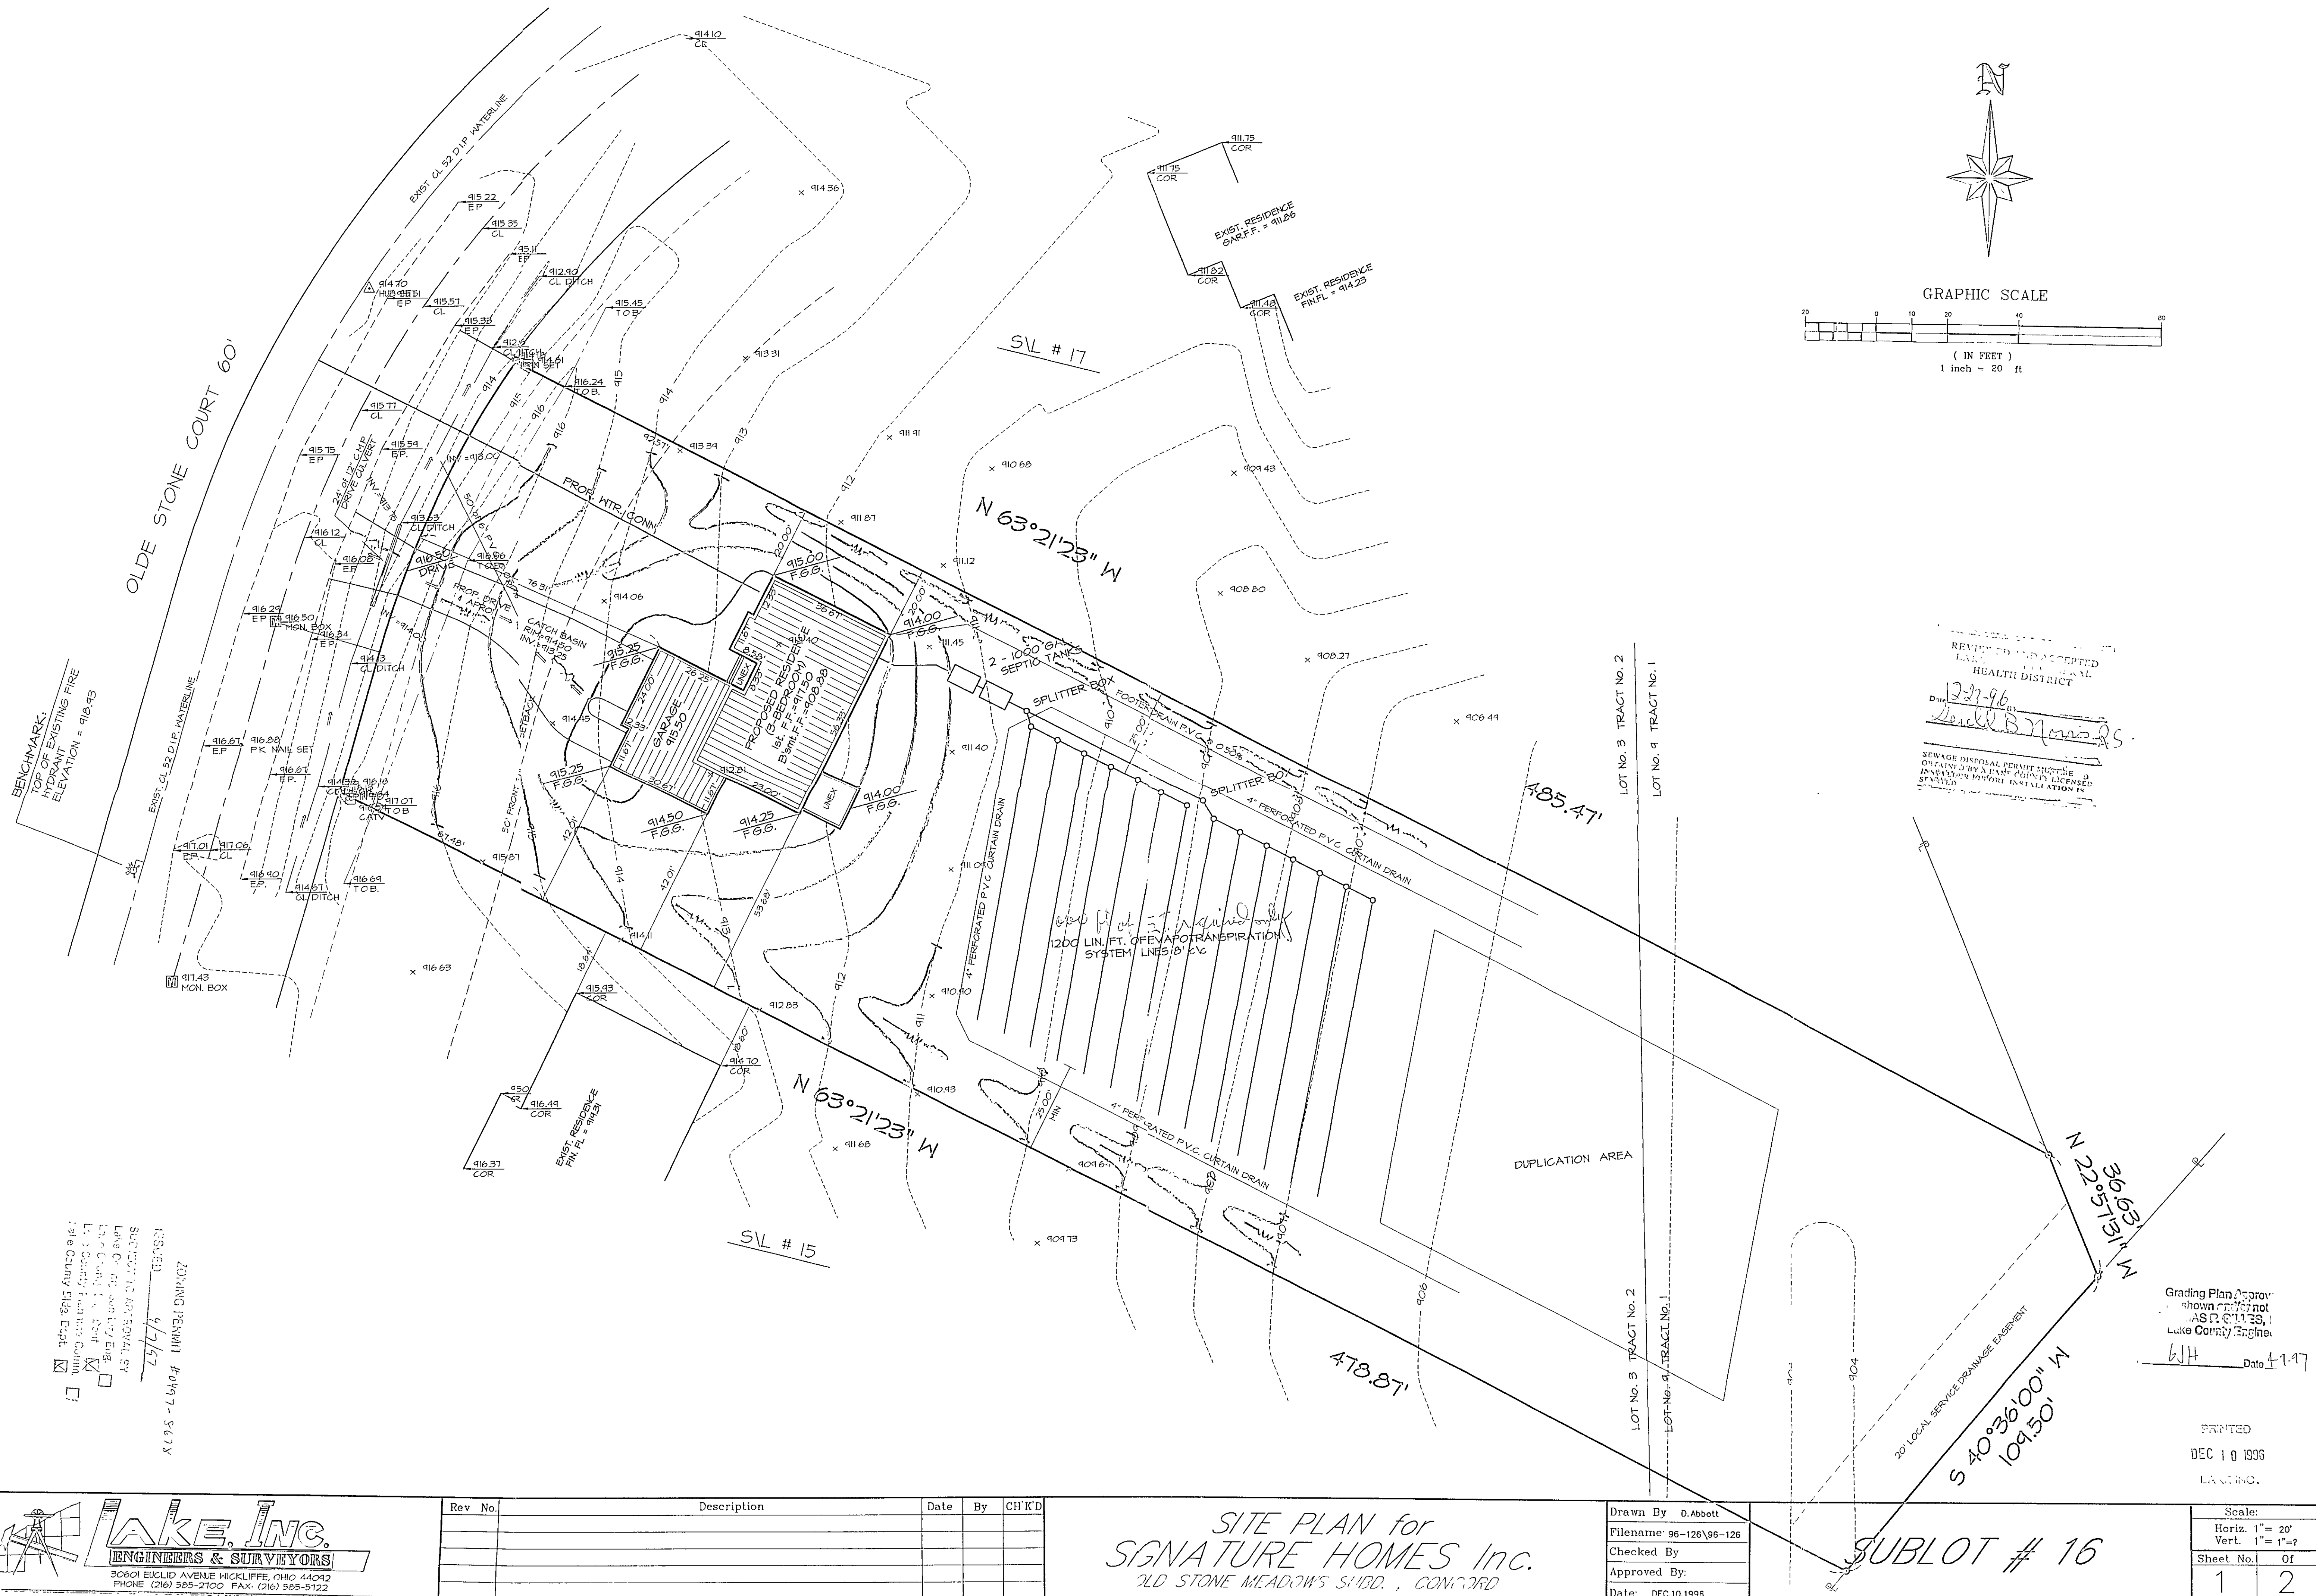
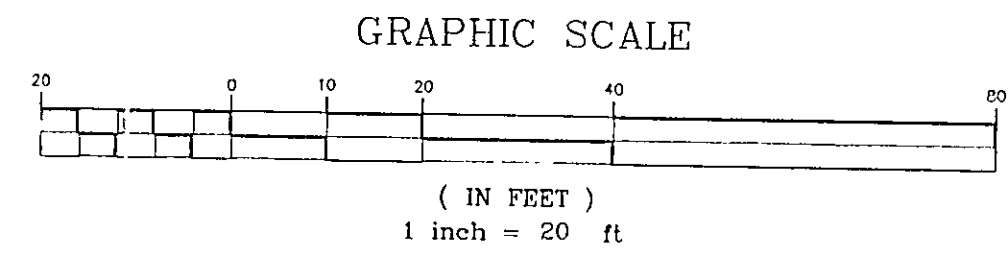


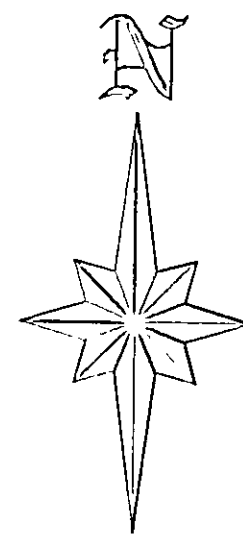

REVIEWED AND ACCEPTED
DATE: 12-27-96
BY: [Signature]
HEALTH DISTRICT

SEWAGE DISPOSAL PERMIT MUST BE
OBTAINED BY A D.P. ENGINEER LICENSED
IN OHIO BEFORE INSTALLATION IS
STARTED

Grading Plan Approved
shown on this plan
AS P. 61135, I
Lake County Engineer
Date: 1-1-97

PRINTED
DEC 10 1996
LAKELAND

Lake, Inc.
ENGINEERS & SURVEYORS
30601 EUCLID AVENUE WICKLIFFE, OHIO 44092
PHONE (216) 585-2100 FAX: (216) 585-5122

Rev No.	Description	Date	By	CHK'D

SITE PLAN for
SIGNATURE HOMES Inc.
OLD STONE MEADOWS SUBD., CONCORD

Drawn By D.Abbott
Filename: 96-126\96-126
Checked By
Approved By
Date: DEC.10,1996

SUBLOT # 16

Scale:	
Horiz. 1"= 20'	
Vert. 1"= 1'-2"	
Sheet No. 1	Of 2