

STAKE SCHEDULE


8.00'
5.00'
20.67'
34.00'
DIAG. 10' = 77.82'

Reviewed and Accepted
LINE COUNTY ENGINEER, HEALTH DISTRICT
DATE: 8-28-91
JULIA B. B. S. M. P. E.
Himebaugh and Associates
BY: *[Signature]*

- A. To be brought to finished grade
1. Septic tank cover
2. Distribution box cover
3. Distribution box cover
B. No footer drains or downspouts
to be discharged into septic tanks
C. All waste water to be discharged into
septic tanks



LOW YIELD WATER
FIXTURES REQUIRED
ON ALL:
Shower
Head
Toilet

SEWAGE DISPOSAL PERMIT MUST BE
OBTAINED BY A LAKE COUNTY LICENSED
ENGINEER BEFORE INSTALLATION OF
SEWER.

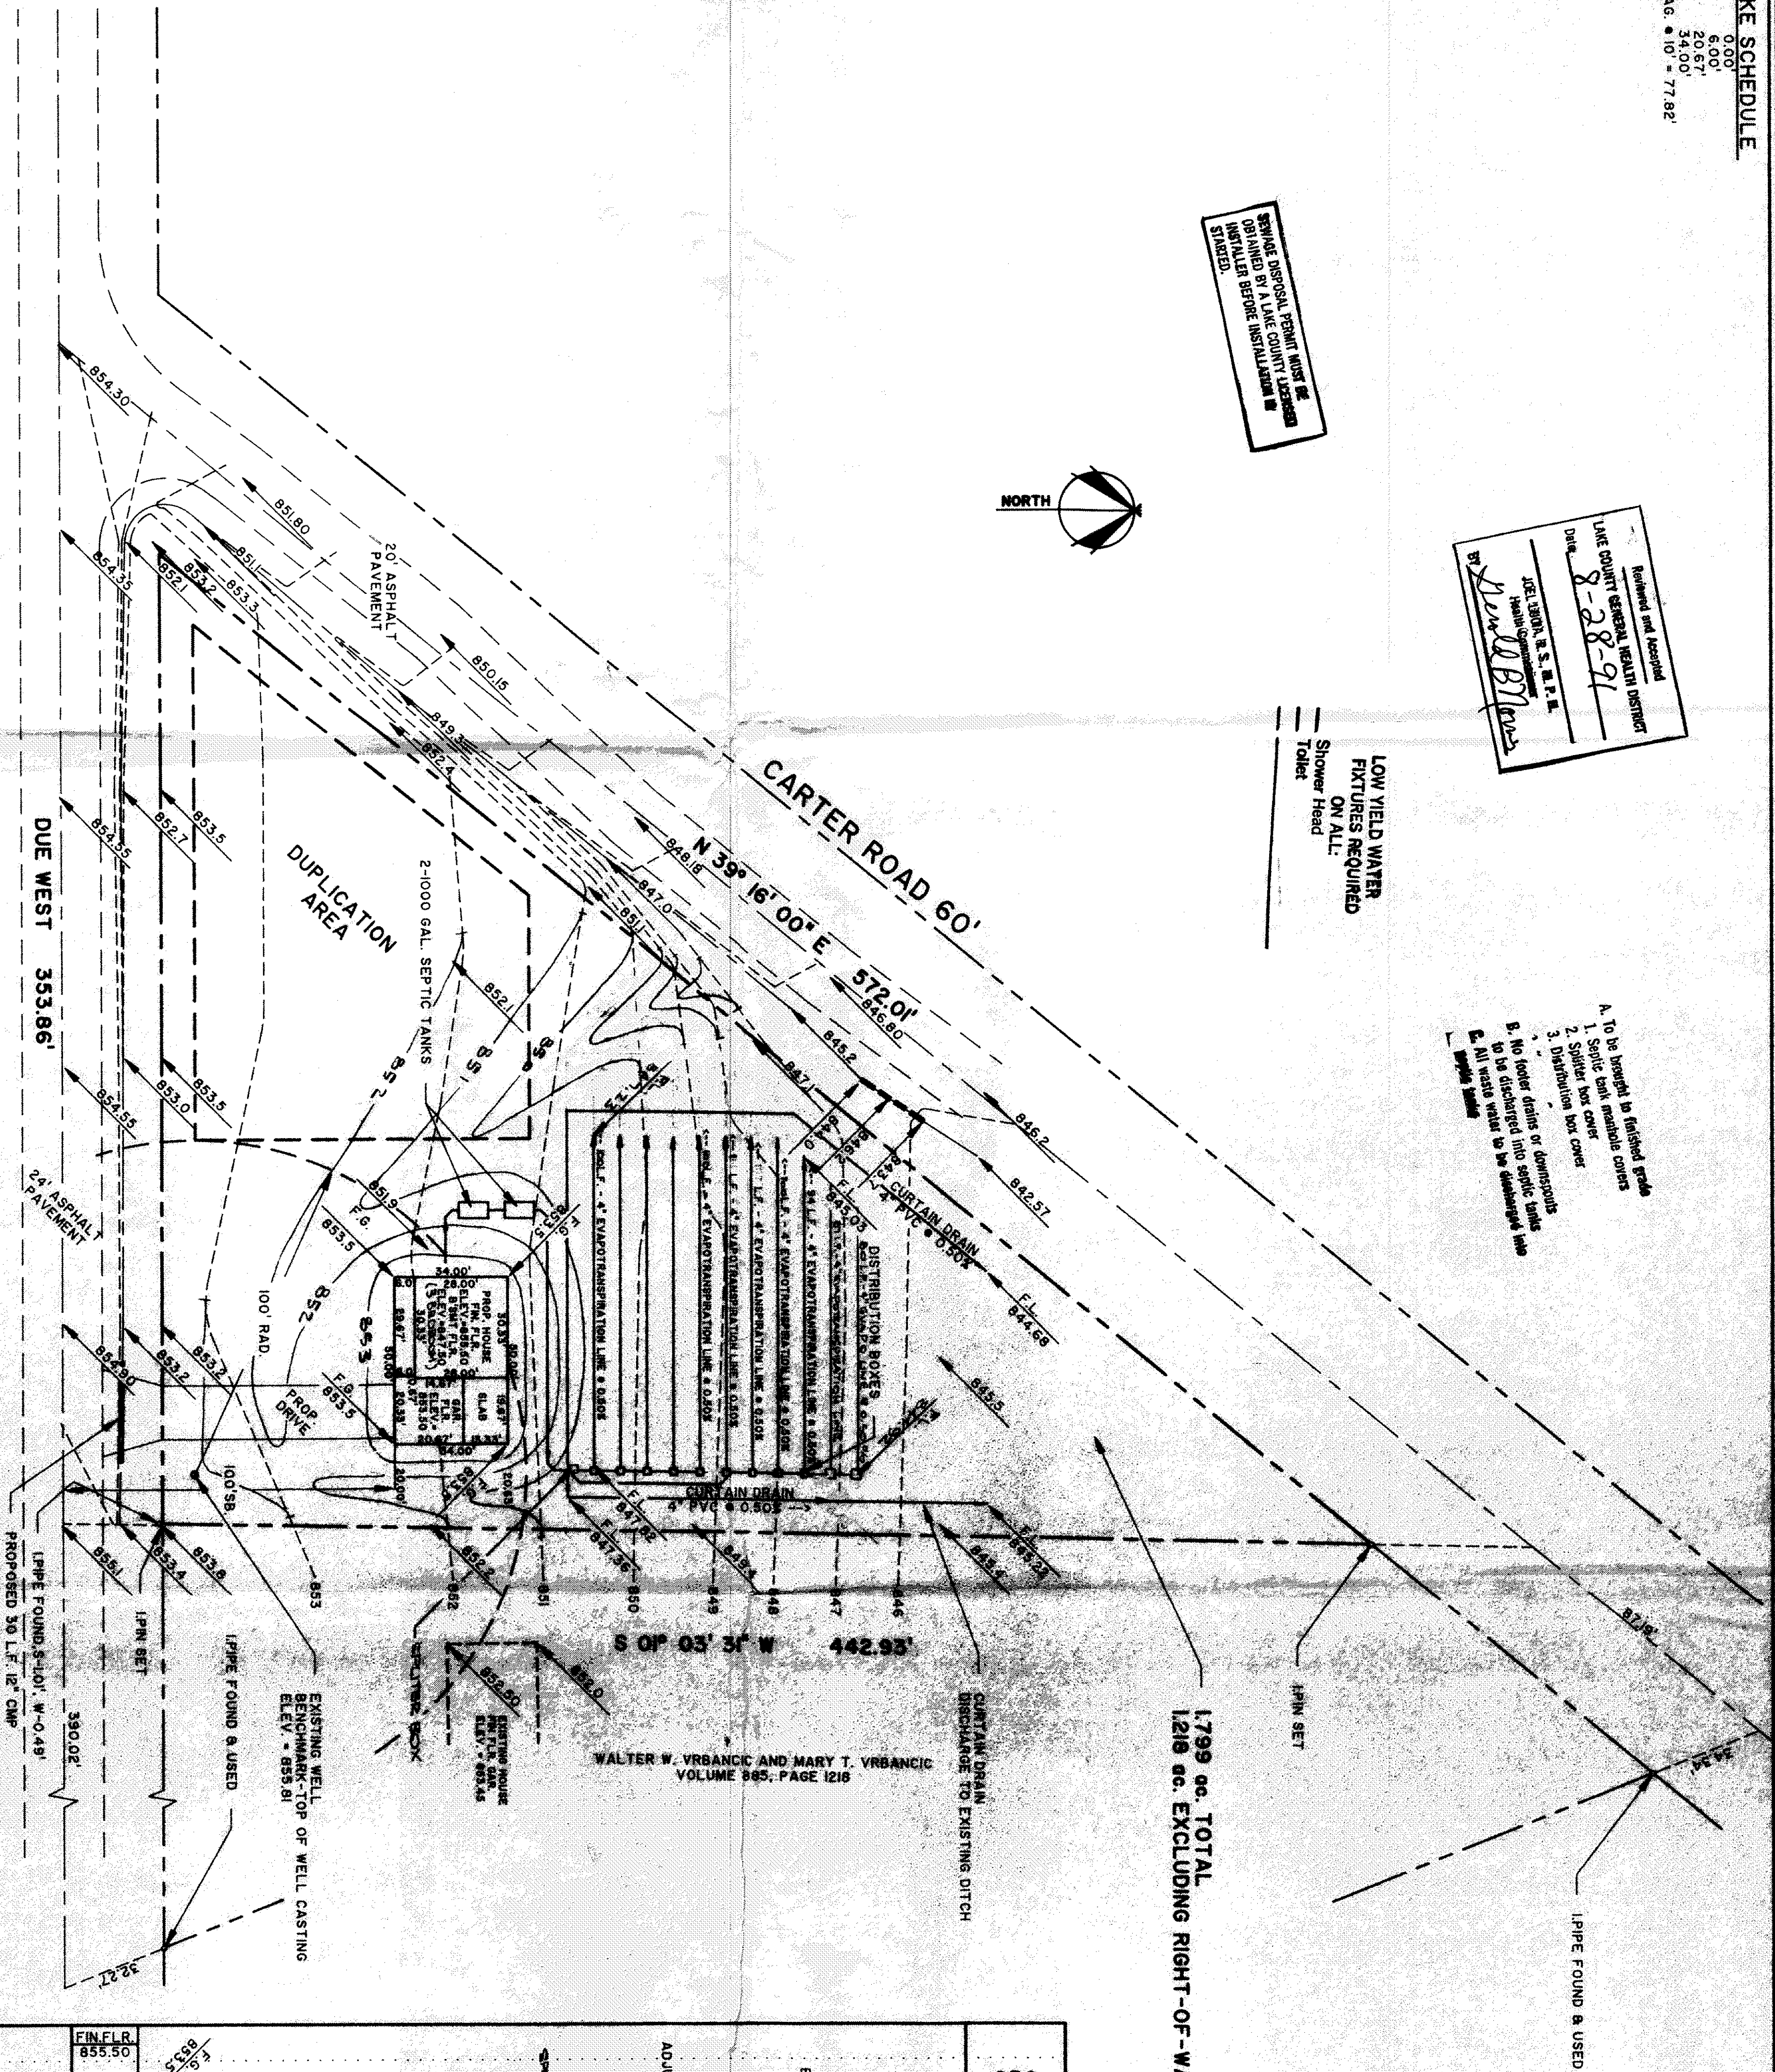


1,799 sq. TOTAL
1,218 sq. EXCLUDING RIGHT-OF-WAY

TYPICAL EVAPOTRANSPIRATION TRENCH CROSS SECTION

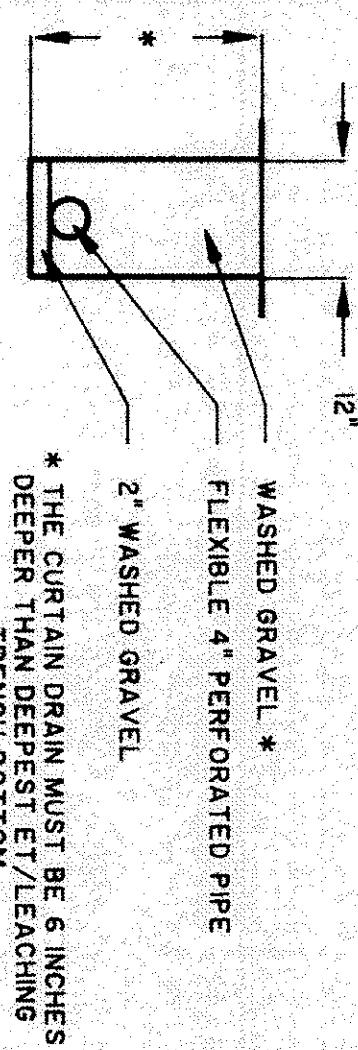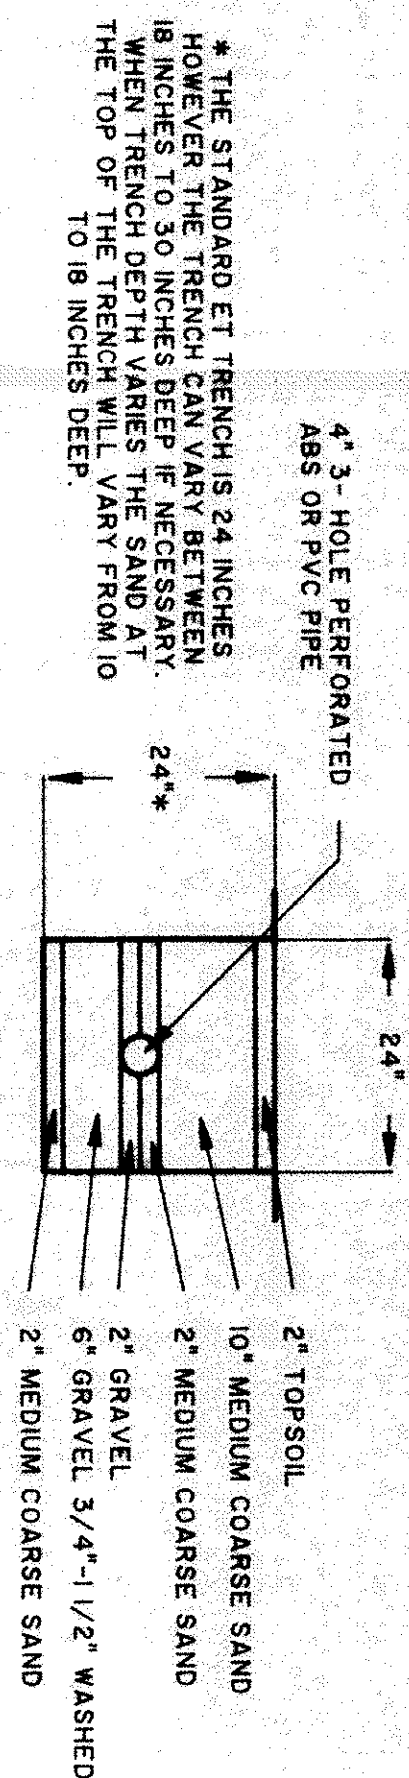

TYPICAL CURTAIN DRAIN CROSS SECTION

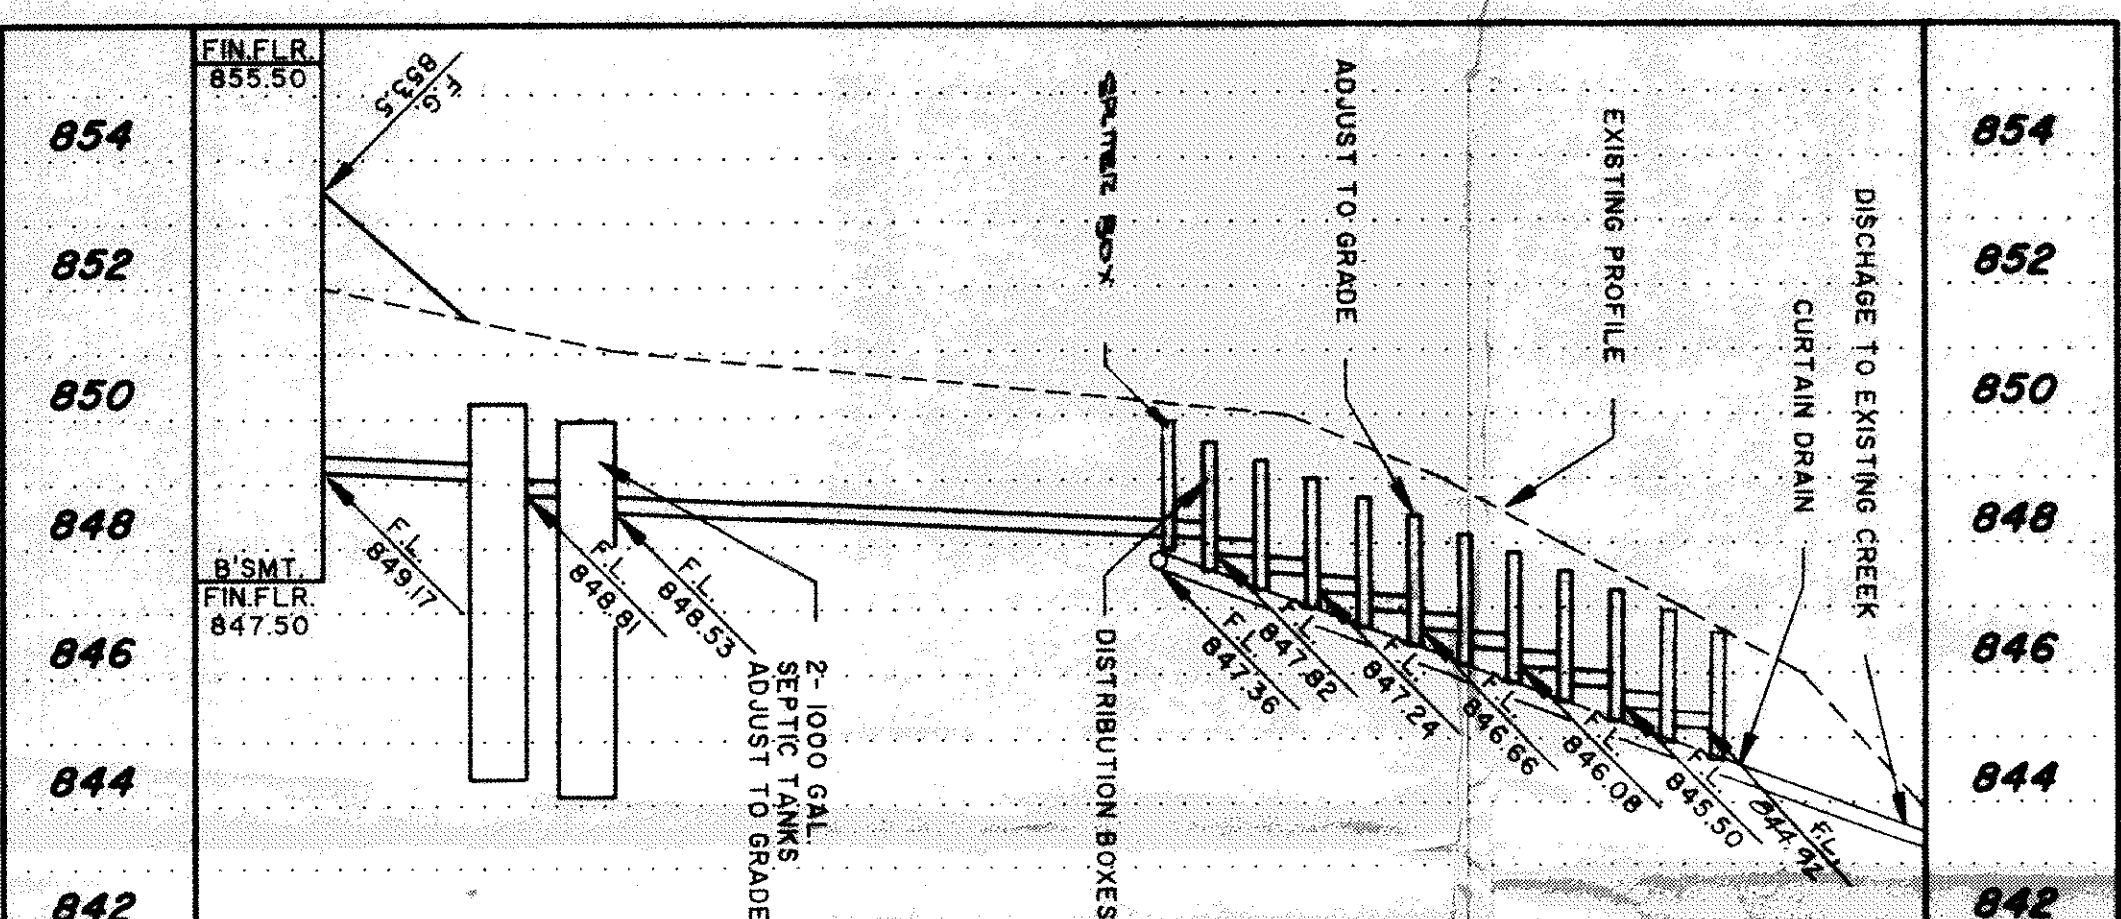

HYDRAULIC PROFILE

SCALE: HORIZ. 1\"/>

GENERAL NOTES:

1. BENCHMARK - TOP OF EXISTING WELL CASTING
ELEVATION = 855.81

LEGEND

- EXISTING CONTOUR
PROPOSED CONTOUR
EXISTING ELEVATION
PROPOSED ELEVATION

CERTIFICATION

"I, THE UNDERSIGNED HEREBY CERTIFY THAT THIS TOPOGRAPHY INDICATED BY 'I' CONTOURS AND ELEVATIONS SHOWN HEREON REPRESENTS AN ACTUAL SURVEY MADE BY ME ON THE 15th DAY OF AUGUST, 1991 AND THE ELEVATIONS WERE TAKEN AT APPROPRIATE INTERVALS AND AS OF THAT DAY THEY EXISTED AS INDICATED HEREON.

"I HEREBY CERTIFY THAT THIS PLAN WAS PREPARED BY ME AND IS CORRECT TO THE BEST OF MY KNOWLEDGE."

[Signature]
QUENTIN S. HIMEBAUGH, P.S. No. 6820

Grading Plan Approved
By: *[Signature]*
Date: 8/28/91
Right of Way Permit Required
From: DOT.

Himebaugh and Associates
Surveyors and Site Consultants
38083 West Spaulding St.
Willoughby, Ohio 44094
(216) 946-1761

WAYNE S. HORTON
6823 WILLIAMS ROAD
PAINESVILLE, OHIO 44077

SITE PLAN

1,799 ACER PARCEL AT 12313 PAINESVILLE-WARREN ROAD
BEING PART ORIGINAL LOT NO. 13, TRACT NO. 1
CONCORD TOWNSHIP, LAKE COUNTY, OHIO

91-086