


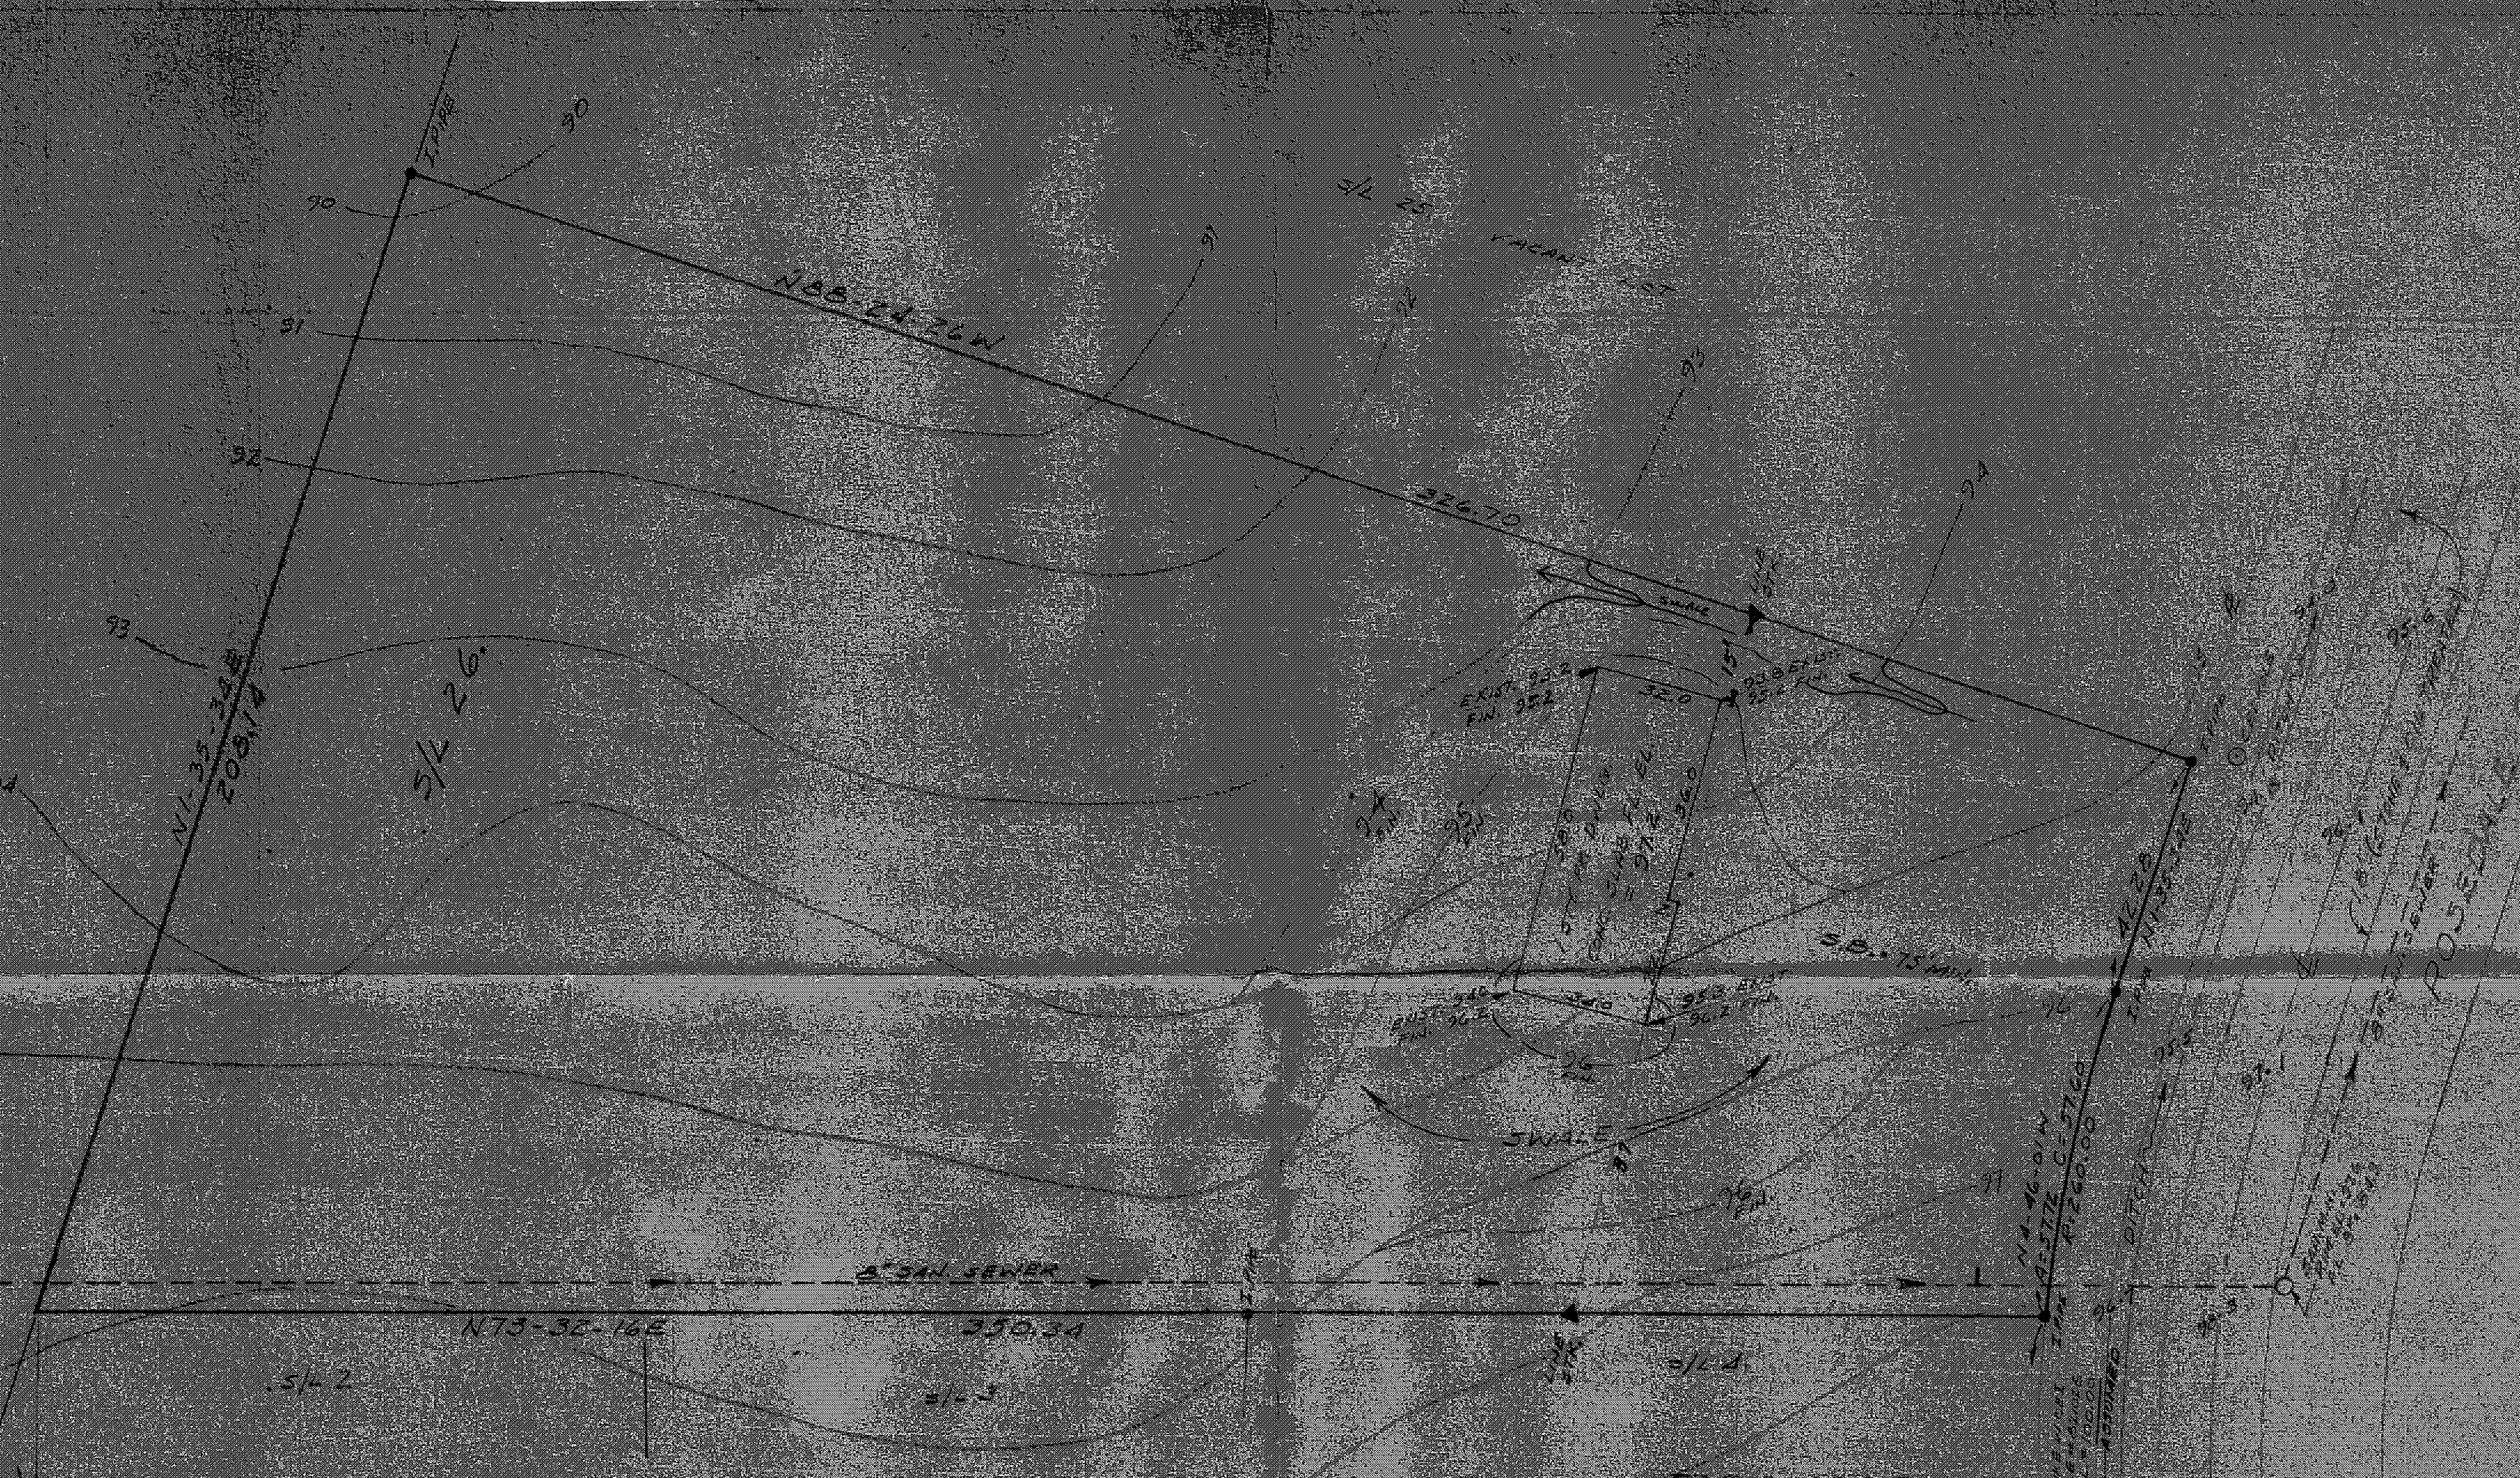

SITE PLAN

JOHN W. DWYER

3/4 26 ROSEMONT TERRACE SUBD.

LOTS 25 & 26, TR. 4, CONCORD TWP.

LAKE CO.

OHIO

JAN. 1976

SCALE: 1"=20'

Grading Plan Approved
as shown and/or noted
THOMAS P. GILLES, P.E.
Lake County Engineer

JWK Date 1-29-76

ZONING
PERMIT

Approved 1/29/76 #2978
Chapman

WATER SERVICE AVAILABLE, O.W.S.
R.C. DILLWORTH, RES. SUR. No. 4215.

EXIST.
D.W.G.

BAXTER ROAD (RT. 54)