
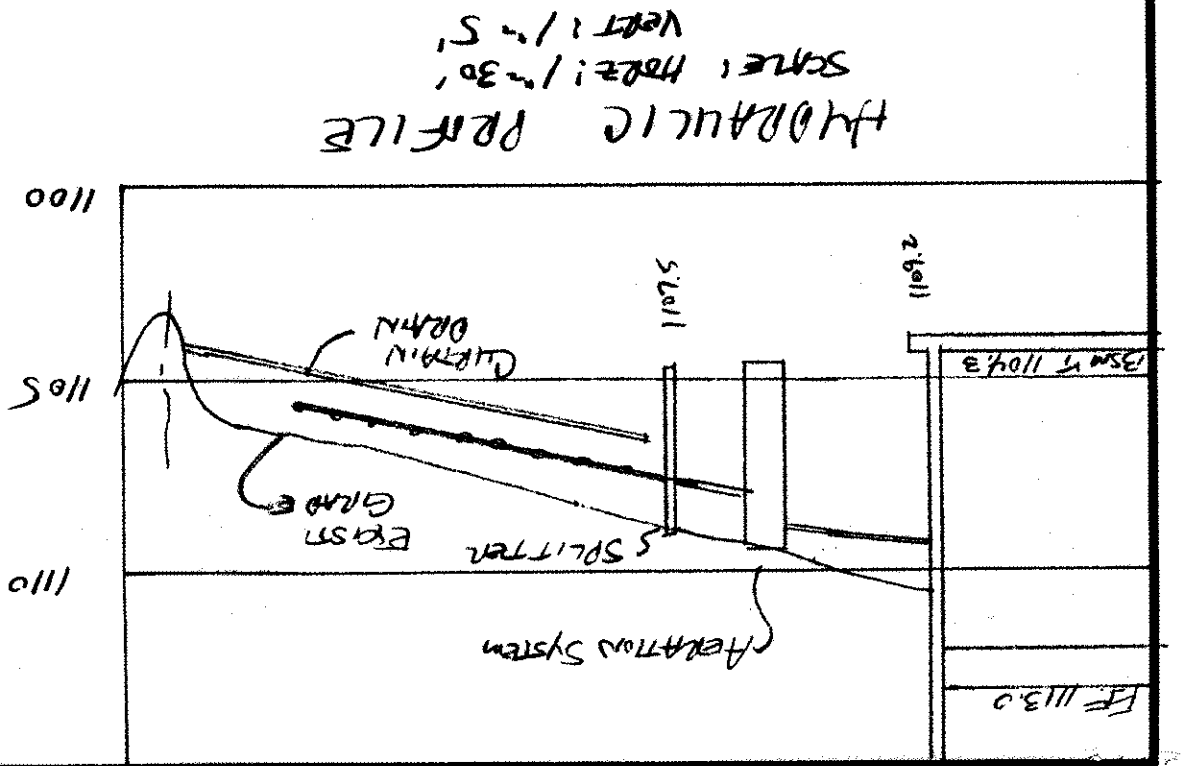
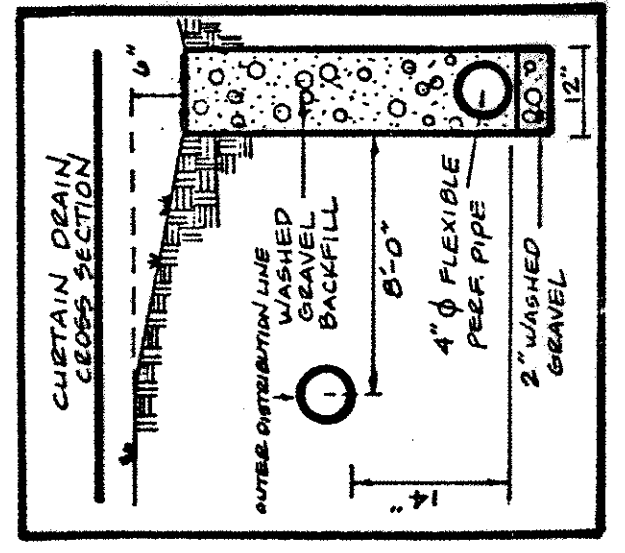


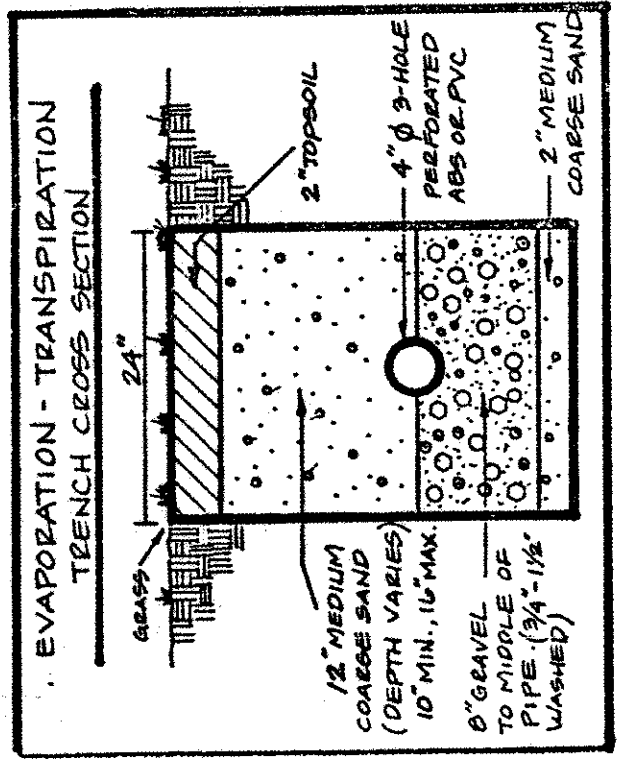

SITE PLAN
Caledon Township, Lake County, Ohio

for: Kay Homes CLIENT OWNER

ADDRESS: State Creek Sub CITY: State Creek ZIP: 43081

SUBDIVISION: State Creek Sub LOT: 10 TRACT: 10

VOLUME: 10 PAGE: 10

PERM. PARCEL NO.: 10 STREET: State Creek Lake

LEGEND

SANITARY MANHOLE: WATER VALVE (GAS): INDICATES DIRECTION OF SURFACE DRAINAGE

STORM MANHOLE: WATER METER (GAS): AS BUILT ELEVATION

INLET OR CATCH BASIN: HYDRANT: EXISTING CONTOURS: PROPOSED CONTOURS: EXIST. ELEV.: PROP. ELEV.:

REMARKS

ALL BOUNDARY DATA SHOWN WAS OBTAINED FROM (DEEDS, RECORDED SUBDIVISION PLAT OR OTHER PUBLIC RECORDS)

LOCATIONS AS SHOWN OF ADJACENT WELLS AND SEPTIC TANKS OBTAINED FROM LAKE COUNTY HEALTH DEPARTMENT

DESIGN CERTIFICATION

THIS PLAT WAS PREPARED BY ME, AND IS CORRECT TO THE BEST OF MY KNOWLEDGE AND BELIEF.

NAME: Harry S. Jones, Jr. SURVEYOR REGISTRATION NO.: 5-6343

CHECK LIST

NO. OF BEDROOMS: 3 WATER MAIN SIZE, LOCATION

DIMENSIONS: 30' x 30' SAN. SEWER SIZE, % GR. LOC.

TIE TO NEAREST STREET: State Creek Lake SAN. MH. CAST. ELEV. INV. ELEV.

SUBLOT NO. PARCEL NO.: 10 SAN. CONN. SIZE, LOC. DEPTH

SURROUNDING OWNERS: State Creek Lake STORM SEWER SIZE, % GR. LOC.

BLOG. DIMENSIONS FIN. GR.: 30' x 30' STORM MH. CAST. ELEV. INV. ELEV.

APRON TYPE WIDTH THICKNESS: 30' x 30' PAVT TYPE GRADE CURBS

SEPTIC TANK LOCATION & DUPLICATION AREA: State Creek Lake GAS LINE LOC. SIZE PRESSURE

WELL LOCATION: State Creek Lake ISOLATION RADIUS FROM WELL

PLAN PREPARED BY: BABCOCK & JONES & ASSOCIATES, INC. PAINESVILLE, OHIO

SCALE: 1" = 30' PHONE NO.: 357-1811

DATE: 3/5/96 DRAWING NO.: 89-081-10

CHK'D: HA APP'D: HA CREW CHIEF: HA

"AS BUILT" CERTIFICATION

HEREBY CERTIFY THAT THE CIRCLED GRADES ARE EXISTING FINISH GRADES CHECKED IN THE FIELD ON 3/5/96, 1996 AND ARE CORRECT TO THE BEST OF MY KNOWLEDGE AND BELIEF.

REGISTERED SURVEYOR: Harry S. Jones, Jr. REG. NO.: 5-6343

TSM - E PAVEMENT @ S.W. CORNER OF 9L 10 ELEV. ~ 1108.82

