

**SITE PLAN**

Located Township, Lake County, Ohio

For: Don & Rich Builders

691-1022

LOT	TRACT
VOLUME	PAGE
PERM. PARCEL NO.	STREET

**LEGEND**

- WATER VALVE (GAS)
- WATER METER (GAS)
- AS BUILT ELEVATION
- EXISTING CONTOURS
- PROPOSED CONTOURS
- EXIST. ELEV. 1980 PROP. ELEV.
- INDICATES DIRECTION OF SURFACE DRAINAGE

**REMARKS**


ALL BOUNDARY DATA SHOWN WAS OBTAINED FROM IDEEDS, RECORDED SUBDIVISION PLAT OR OTHER PUBLIC RECORDS

LOCATIONS AS SHOWN OF ADJACENT WELLS AND SEPTIC TANKS OBTAINED FROM LAKE COUNTY HEALTH DEPARTMENT

**DESIGN CERTIFICATION**

THIS PLAN WAS PREPARED BY ME, AND IS CORRECT TO THE BEST OF MY KNOWLEDGE AND BELIEF.

NAME: HARRY S. JONES, JR. SURVEYOR REGISTRATION NO. 5-6343

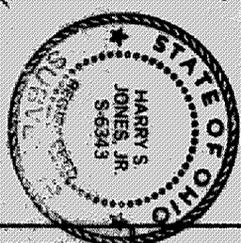

**CHECK LIST**

NO. OF BEDROOMS: 100.57

NO. OF BATHROOMS: 100.57

NO. OF GARAGES: 100.57

NO. OF DRIVEWAYS: 100.57

NO. OF SIDEWALKS: 100.57

NO. OF STAIRS: 100.57

NO. OF PORCHES: 100.57

NO. OF TERRACES: 100.57

NO. OF PATIOS: 100.57

NO. OF BALCONIES: 100.57

NO. OF DECKS: 100.57

NO. OF FENCES: 100.57

NO. OF UTILITY LINES: 100.57

NO. OF SEWER LINES: 100.57

NO. OF WATER LINES: 100.57

NO. OF GAS LINES: 100.57

NO. OF CABLE LINES: 100.57

NO. OF TELEPHONE LINES: 100.57

NO. OF POWER LINES: 100.57

NO. OF OTHER LINES: 100.57

**PLAN PREPARED BY:**

**BABCOCK & JONES & ASSOCIATES, INC.**

FAIRBANKS, OHIO

**REVISIONS**

NO.	DATE	BY
1	4/1/72	HJ
2		
3		
4		
5		
6		

**"AS BUILT" CERTIFICATION**

I, HEREBY CERTIFY THAT THE CIRCLED GRADES ARE EXISTING FINISH GRADES CHECKED IN THE FIELD ON 19 11/1/72 AND ARE CORRECT TO THE BEST OF MY KNOWLEDGE AND BELIEF.

REGISTERED SURVEYOR REG. NO. 11478

THOMAS P. GILL

GRADING PLAN APPROVED

DATE 4/14/72


BY GPH

LAKE COUNTY ENGINEER

"I, the undersigned hereby certify that this topography indicated by 8', 1' or 2' contours, and elevations shown hereon represent an actual field survey made by me on the 19th day of April, 1972, and that the elevations were taken at appropriate intervals and that as of that date they existed as indicated hereon."

Harry S. Jones, Jr.

Reg. No. 6543

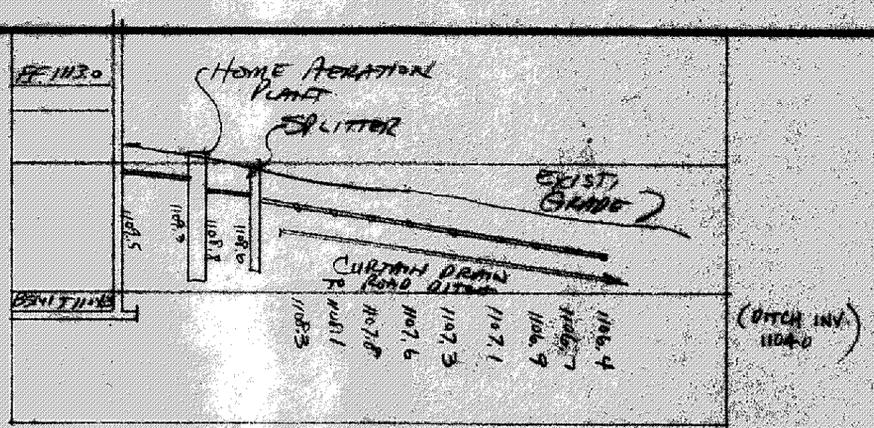

**HYDRAULIC PROFILE**

SCALE: HORIZ. 1"=30'

VERT. 1"=5'

\* NOTE: HOUSE DIMENSIONS TO BE VERIFIED BEFORE HOUSE STARTING. (INTERIOR DIMENSIONS UNLESS NOTED)

