

SITE PLAN

CONCORD TOWNSHIP, LAKE COUNTY, OHIO

for: DANIEL HONES

|                       |        |                  |        |
|-----------------------|--------|------------------|--------|
| ADDRESS               | STREET | CITY             | ZIP    |
| 10512 STATE HOLLOW RD |        |                  |        |
| SUBDIVISION           |        | LOT              | TRACT  |
| 10                    |        | 10               | 10     |
| SUBLOT NO.            |        | VOLUME           | PAGE   |
| 10                    |        | 10               | 10     |
| STREET                |        | PERM. PARCEL NO. | STREET |

|                      |                                         |
|----------------------|-----------------------------------------|
| SANITARY MANHOLE     | WATER VALVE (GAS)                       |
| STORM MANHOLE        | WATER METER (GAS)                       |
| INLET OR CATCH BASIN | AS BUILT ELEVATION                      |
| HYDRANT              | INDICATES DIRECTION OF SURFACE DRAINAGE |
| EXISTING CONTOURS    |                                         |
| PROPOSED CONTOURS    |                                         |
| EXIST. ELEV.         | PROP. ELEV.                             |

REMARKS

ALL BOUNDARY DATA SHOWN WAS OBTAINED FROM (DEEDS, RECORDED SUBDIVISION PLAT OR OTHER PUBLIC RECORDS)

LOCATIONS AS SHOWN OF ADJACENT WELLS AND SEPTIC TANKS OBTAINED FROM LAKE COUNTY HEALTH DEPARTMENT

DESIGN CERTIFICATION

THIS PLAT WAS PREPARED BY ME, AND IS CORRECT TO THE BEST OF MY KNOWLEDGE AND BELIEF.

NAME: HARRY JONES, JR. S-6343

SURVEYOR REGISTRATION NO. 16343

CHECK LIST

|                              |                                          |
|------------------------------|------------------------------------------|
| NO. OF BEDROOMS              | WATER MAIN SIZE, LOCATION                |
| DIMENSIONS                   | SAN. SEWER SIZE, GR. LOC.                |
| BEARINGS                     | SAN. MH. CAST. ELEV. INV. ELEV.          |
| TIE TO NEAREST STREET        | SAN. CONN. SIZE, LOC. DEPTH              |
| SUBLOT NO. PARCEL NO.        | STORM SEWER SIZE, GR. LOC.               |
| SURROUNDING OWNERS           | STORM MH. CAST. ELEV. INV. ELEV.         |
| BLDG. DIMENSIONS FIN. GR.    | PAYT TYPE GRADE CURBS                    |
| ALTERN. TYPE WIDTH THICKNESS | GAS LINE LOC. SIZE PRESSURE              |
| SEWER TYPE DIA. LENGTH       | SEPTIC TANK LOCATION & DUPPLICATION AREA |
| ROCK OUTCROPPINGS            | WELL LOCATION                            |
|                              | ISOLATION RADIUS FROM WELL               |

PLAN PREPARED BY:

BABCOCK • JONES & ASSOCIATES, INC.

PAINESVILLE, OHIO

|     |      |    |
|-----|------|----|
| NO. | DATE | BY |
| 1   |      |    |
| 2   |      |    |
| 3   |      |    |
| 4   |      |    |
| 5   |      |    |

DRAWN BY: HJ SCALE: 1" = 20'

CHK'D: HJ DATE: 8/10/94 PHONE NO. 337-1811

CREW: LT APP'D: HJ DRAWING NO. 91-230-10

"AS BUILT" CERTIFICATION

I, HEREBY CERTIFY THAT THE CIRCLED GRADES ARE EXISTING FINISH GRADES CHECKED IN THE FIELD ON 19

AND ARE CORRECT TO THE BEST OF MY KNOWLEDGE AND BELIEF.

BY: GJL Date: 8/22/94 REGISTERED SURVEYOR REG. NO.

ROOF DRAINS SHALL DISCHARGE TO SPLASH BLOCKS.

Col ESTO 6/A

ZONING PERMIT

ISSUED: 08/14/94



SUBJECT TO APPROVAL BY:

Lake County Sanitary Eng. ☐

Lake County Eng. Dept. ☒

Lake County Planning Comm. ☐

Lake County Bldg. Dept. ☒

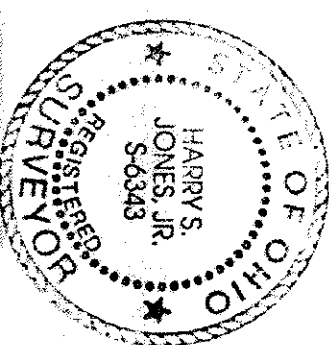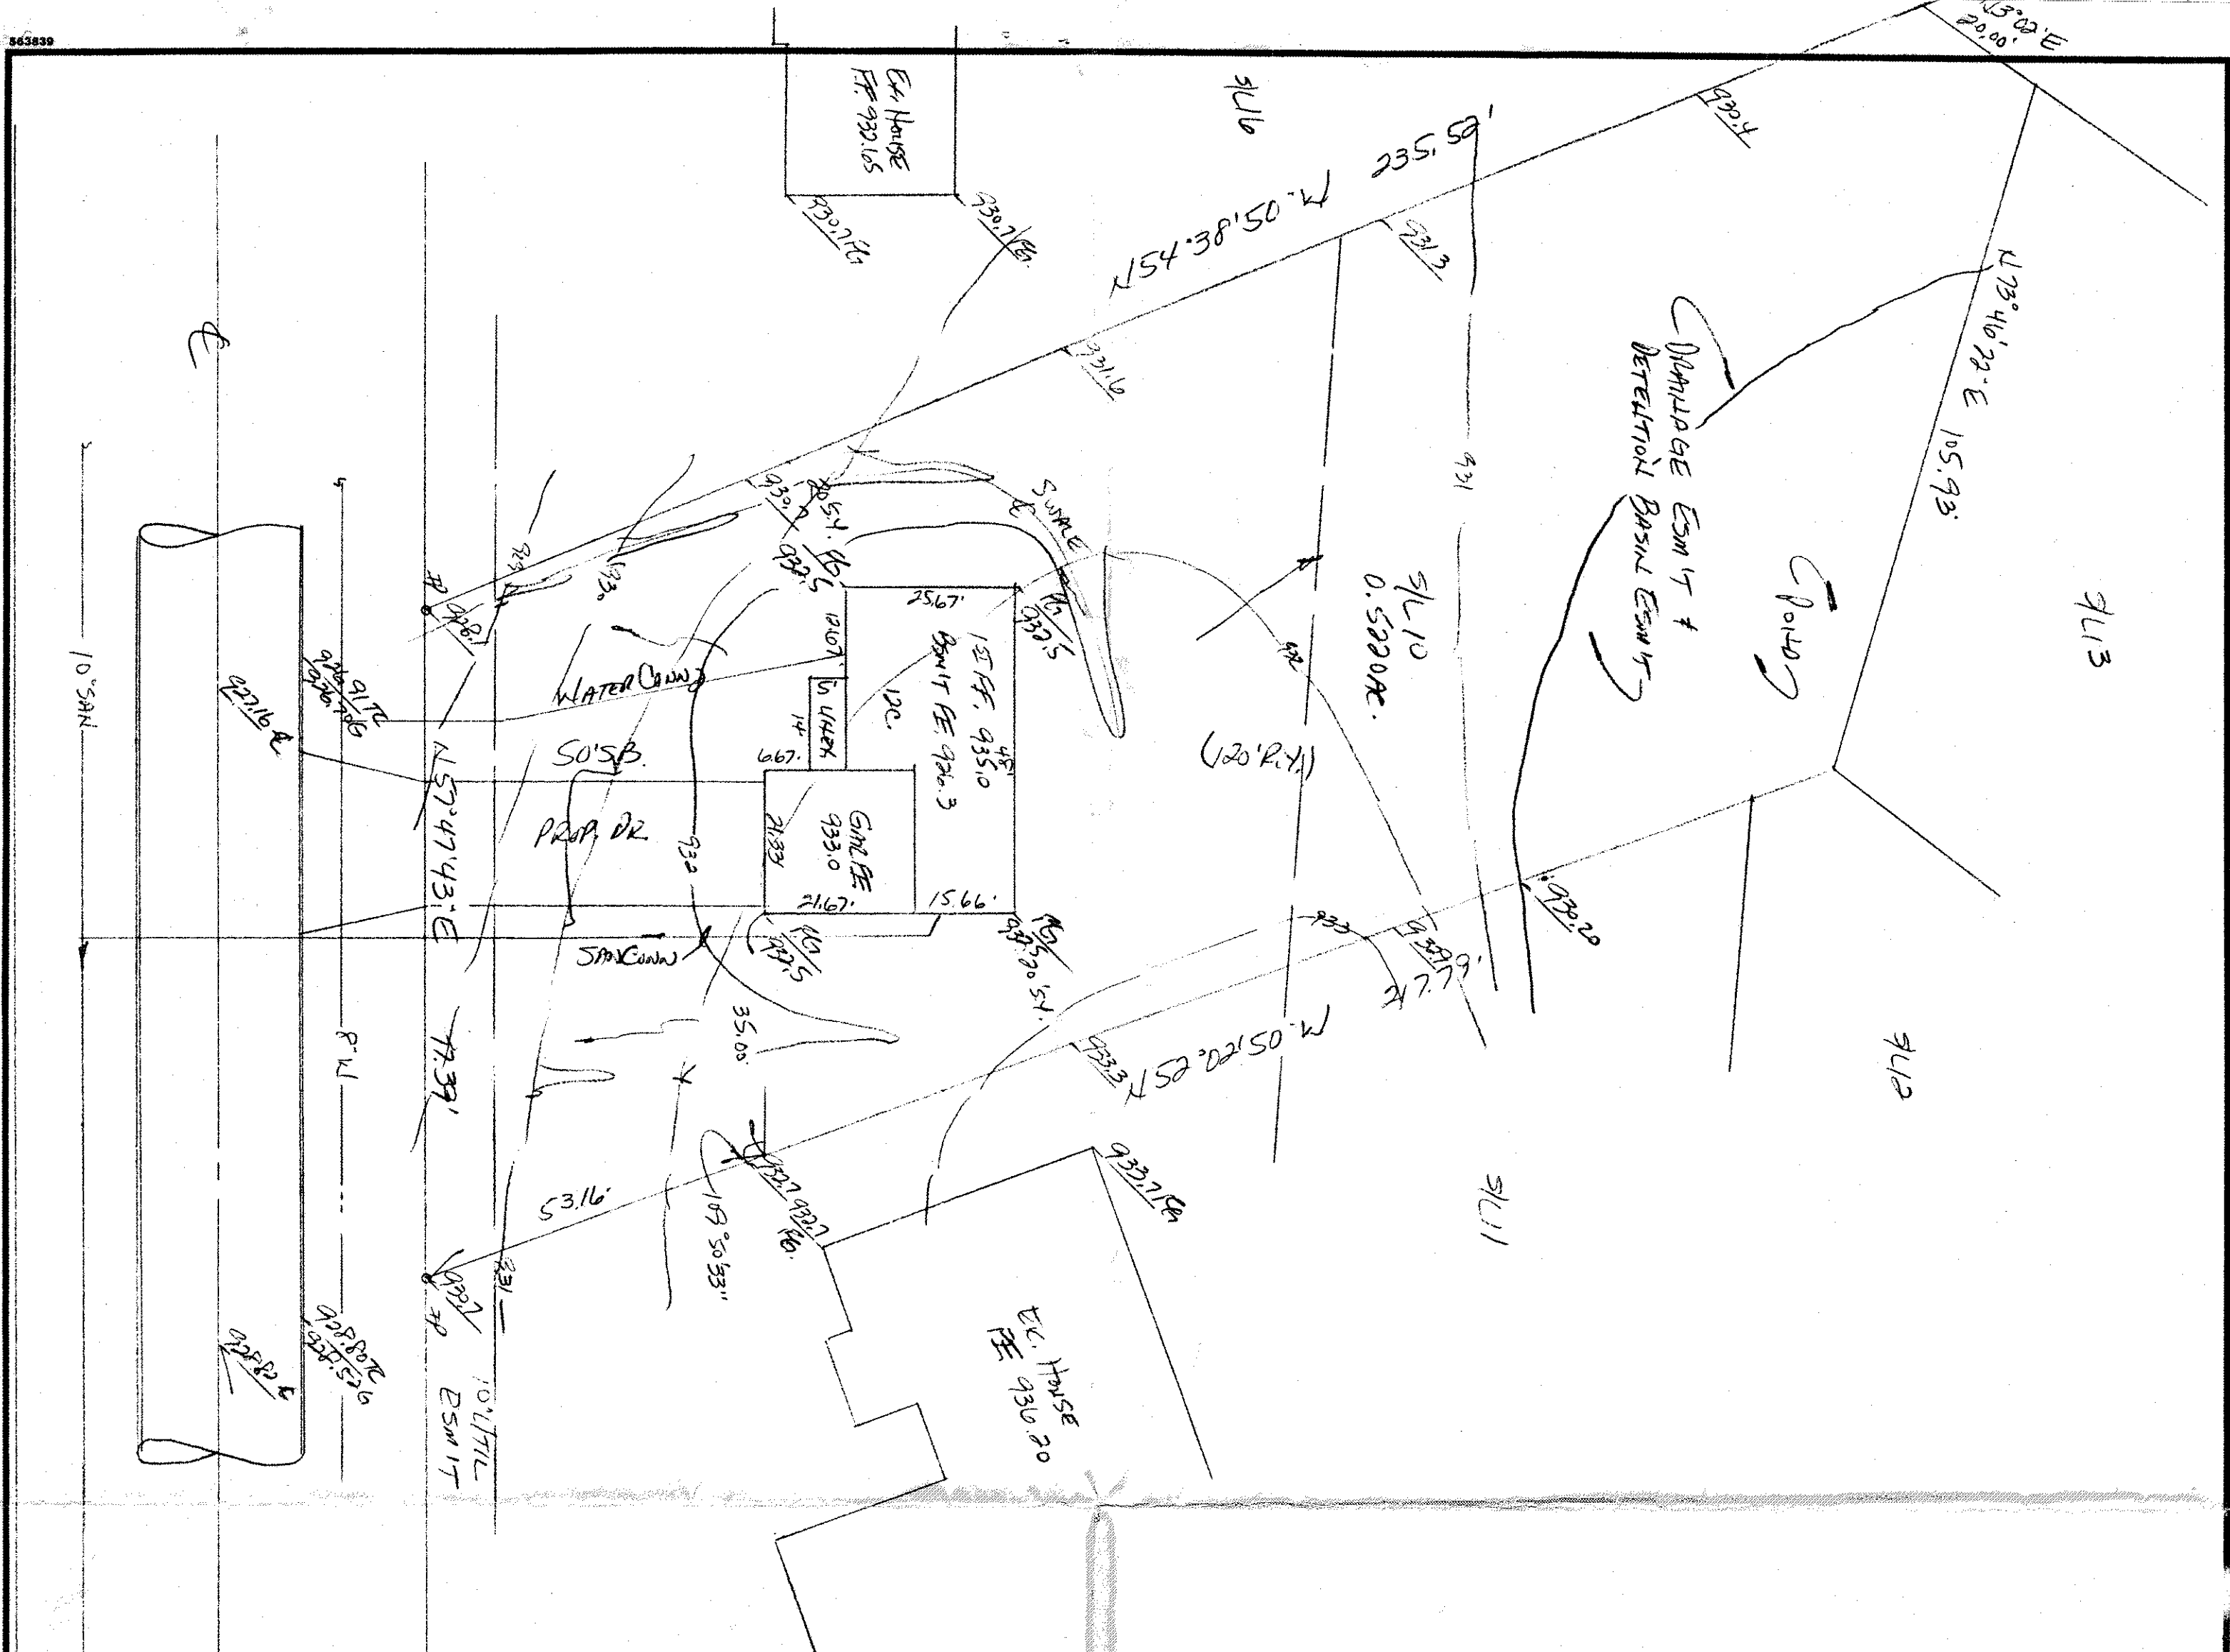

STATE HOLLOW RD - 60'