



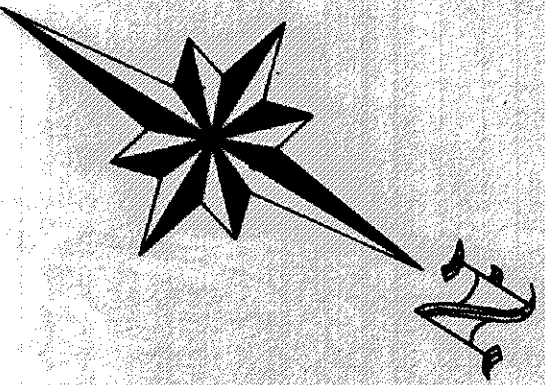

SCALE : 1" = 20'

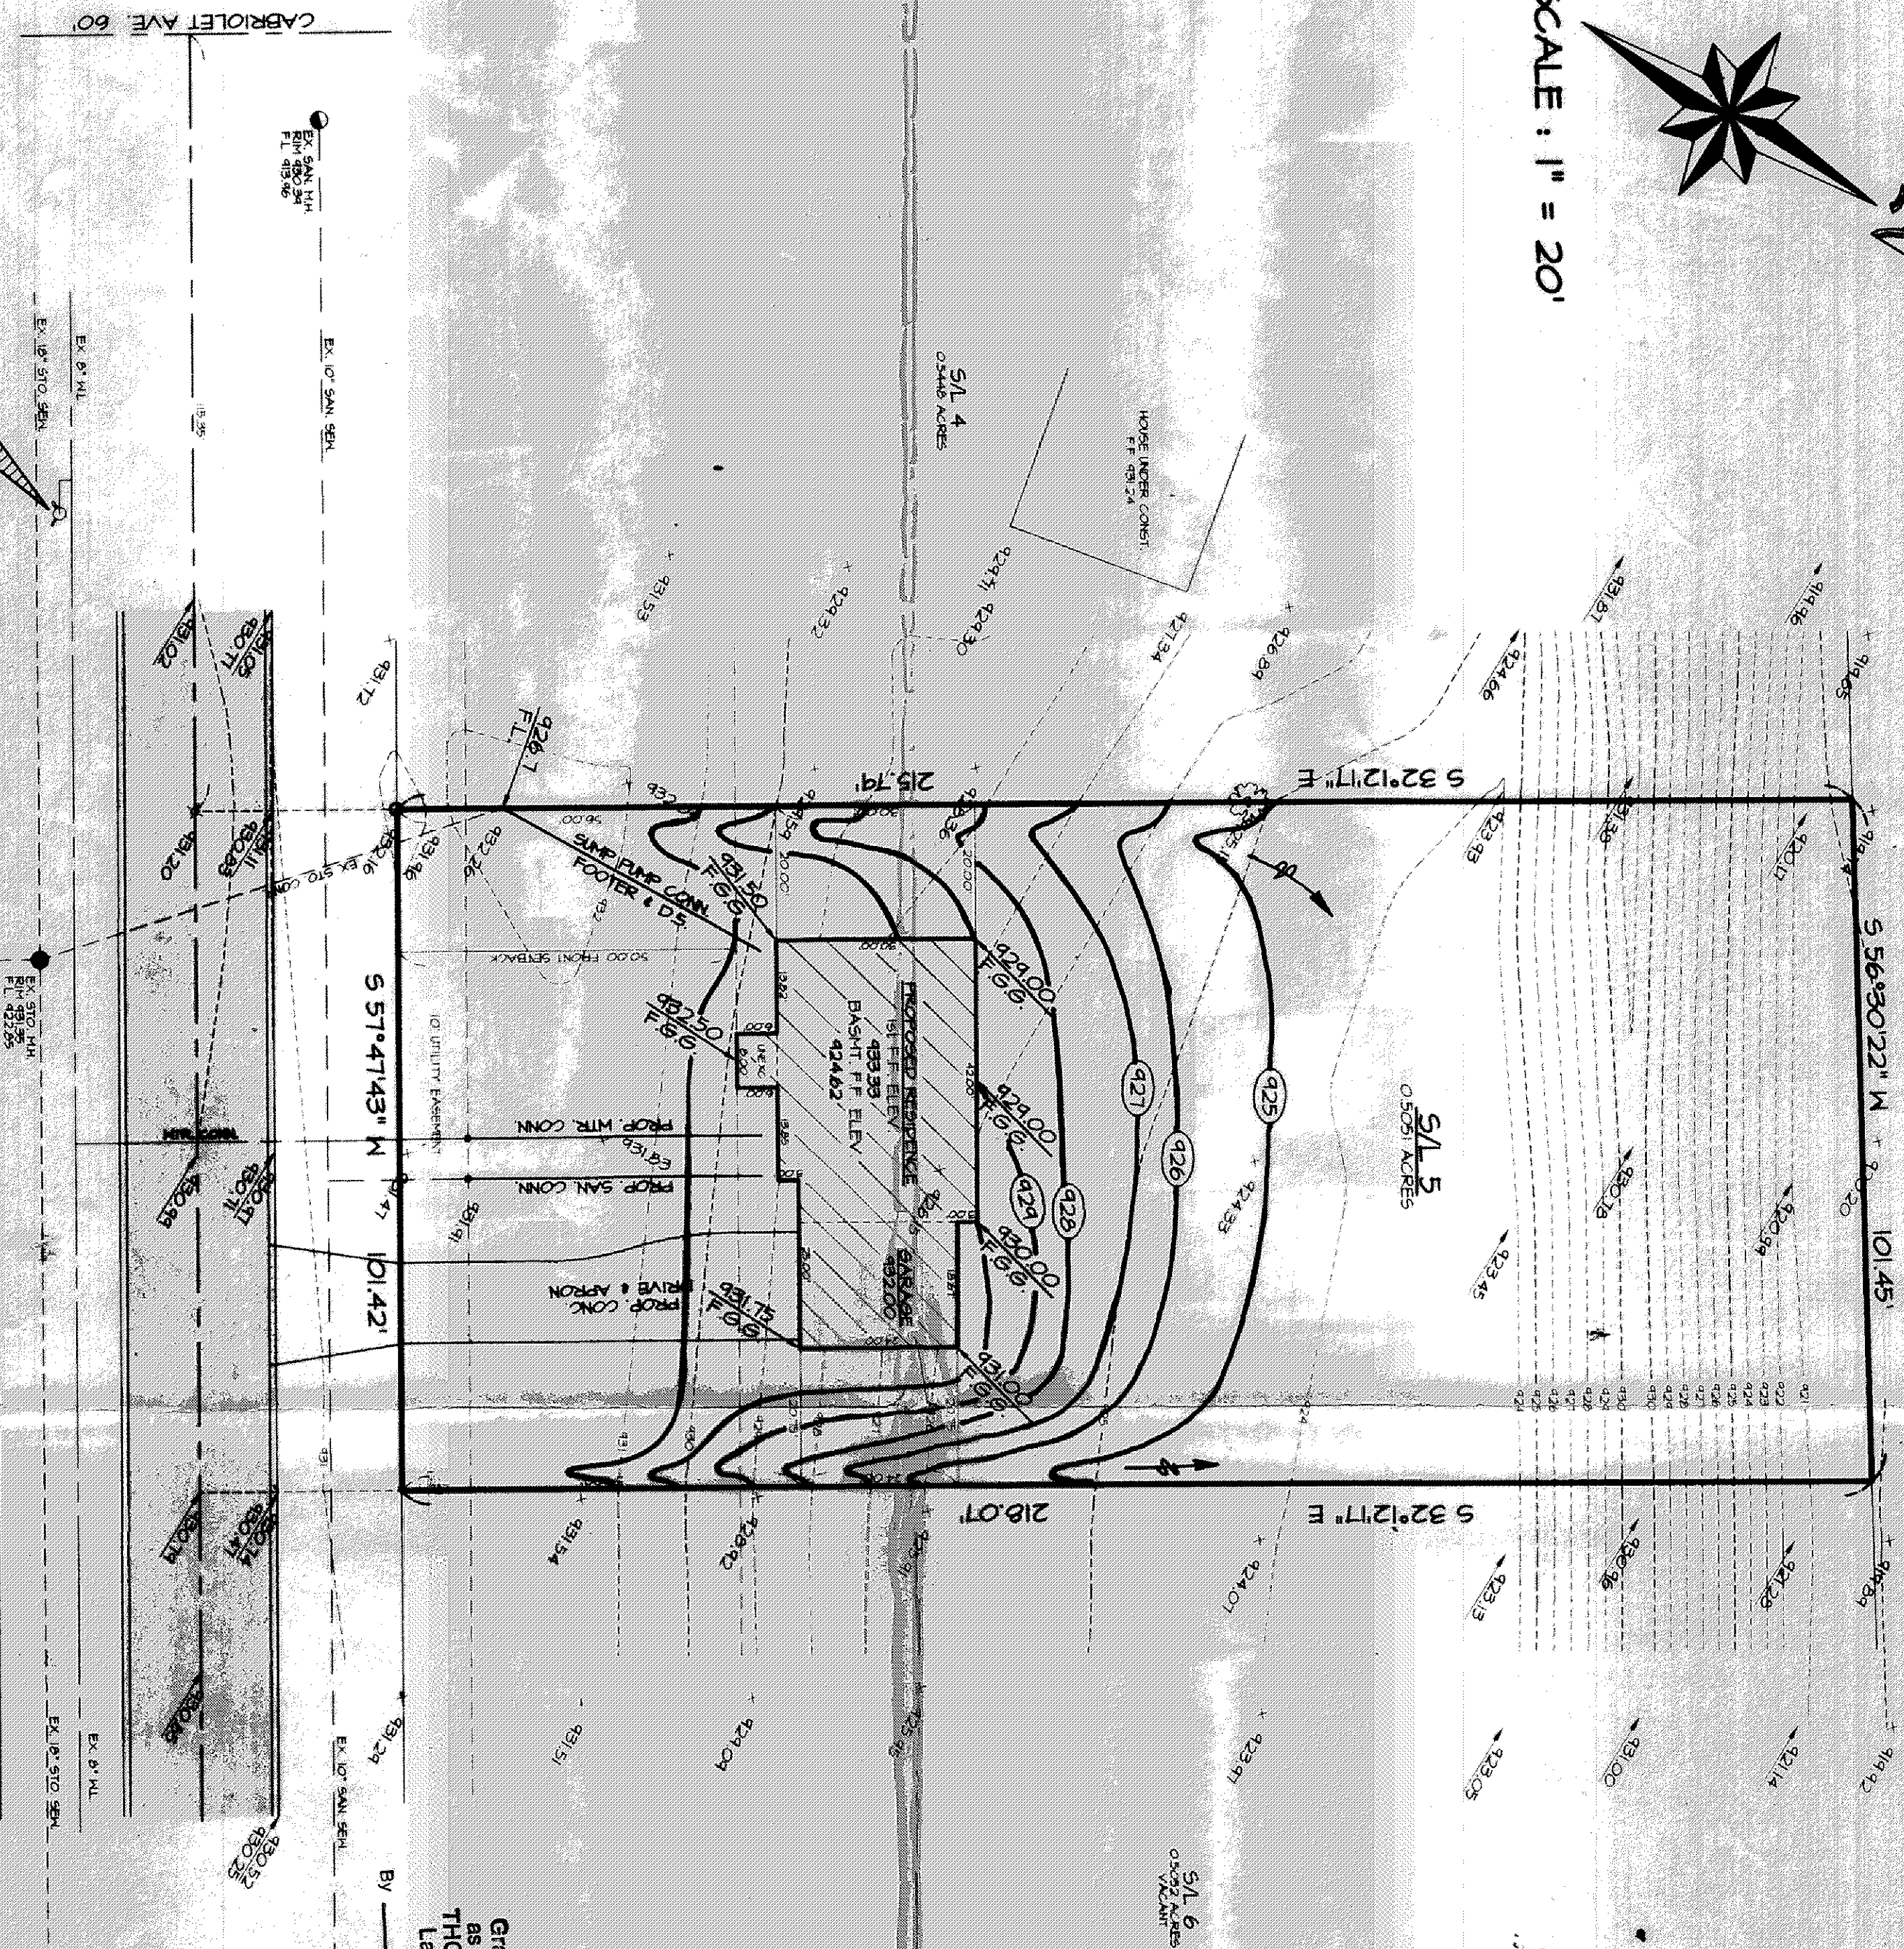

STONE HOLLOW ROAD 60'

C:\N94-105\N94-105 6-30-94 11:48:36 am EST

SITE PLAN

FOR: JIMMY OWENS

ADDRESS: STREET: CITY:

SUBLOT NO. 5 CARRIAGE HILLS NO. 2 VOL. 16 - 35


CONCORD SUBDIVISION NAME TRACT-Lot CONCORD CITY



30601 BUCKLE AVENUE WICKLIFFE, OHIO 44092
PHONE (216) 585-2700 FAX (216) 585-5722

CHECK LIST

LOT DIMENSIONS & BEARINGS
TIE TO NEAREST STREET
SUBLOT NO. (IF APPLICABLE)
BENCHMARKS
SETBACKS
FINISHED GRADES
DRIVE & APRON TYPE, WIDTH, THICKNESS
SIDEWALK TYPE, WIDTH, THICKNESS
CULVERT TYPE, DIAM., LENGTH
WATER MAIN SIZE, LOCATION
SAN SEWER SIZE & GRADE, LOCATION
SAN MH. CAST ELEV. INV. ELEVATION
SAN CON. SIZE & GRADE, LOCATION
STORM MH. CAST ELEV. INV. ELEV.
PAV'T TYPE, GRADE, CURBS
SEWAGE SYSTEM & ISOLATION RADIUS
WELL LOCATION & ISOLATION RADIUS

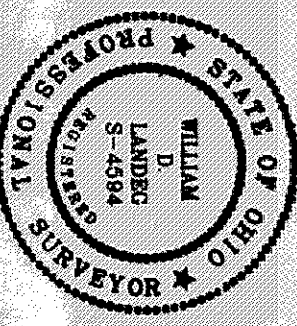

STATE SEAL

DESIGN CERTIFICATION

THIS PLAN WAS PREPARED BY ME, AND IS CORRECT TO THE BEST OF MY KNOWLEDGE AND BELIEF.

William D. Landec
NAME:

LEGEND

STORM MANHOLE
SANITARY MANHOLE
EXISTING CONTOURS
PROPOSED CONTOURS
EXIST. ELEV. 100.0
100.0 PROP. ELEV.
DIRECTION OF SURFACE DRAINAGE

NAME

DRAWN BY: SCALE: 1"=20'

CHECKED BY: DATE: JUNE 24, 1994

JOB NO.

#94-105

Grading Plan Approved
as shown and/or noted
THOMAS P. GILLES, P.E.
Lake County Engineer

By: Date: 7/14

ROOF DRAINS
SHALL DISCHARGE
TO SPLASH BLOCKS.

CONTRACTOR TO VERIFY:
1. FIN. F.L.R. ELEVATIONS & HSE. SIZES
2. LOCATION & ELEVATIONS OF EXIST.
UTILITY CONNECTIONS
BEFORE STARTING CONSTRUCTION

ZONING PERMIT #0794-7683

ISSUED 7-7-94

SUBJECT TO APPROVAL BY:

Lake County Sanitary Eng. ☐
Lake County Eng. Dept. ☒
Lake County Planning Comm. ☐
Lake County Bldg. Dept. ☒

PRINTED
JUN 30 1994
LAKE INC.

#94-105