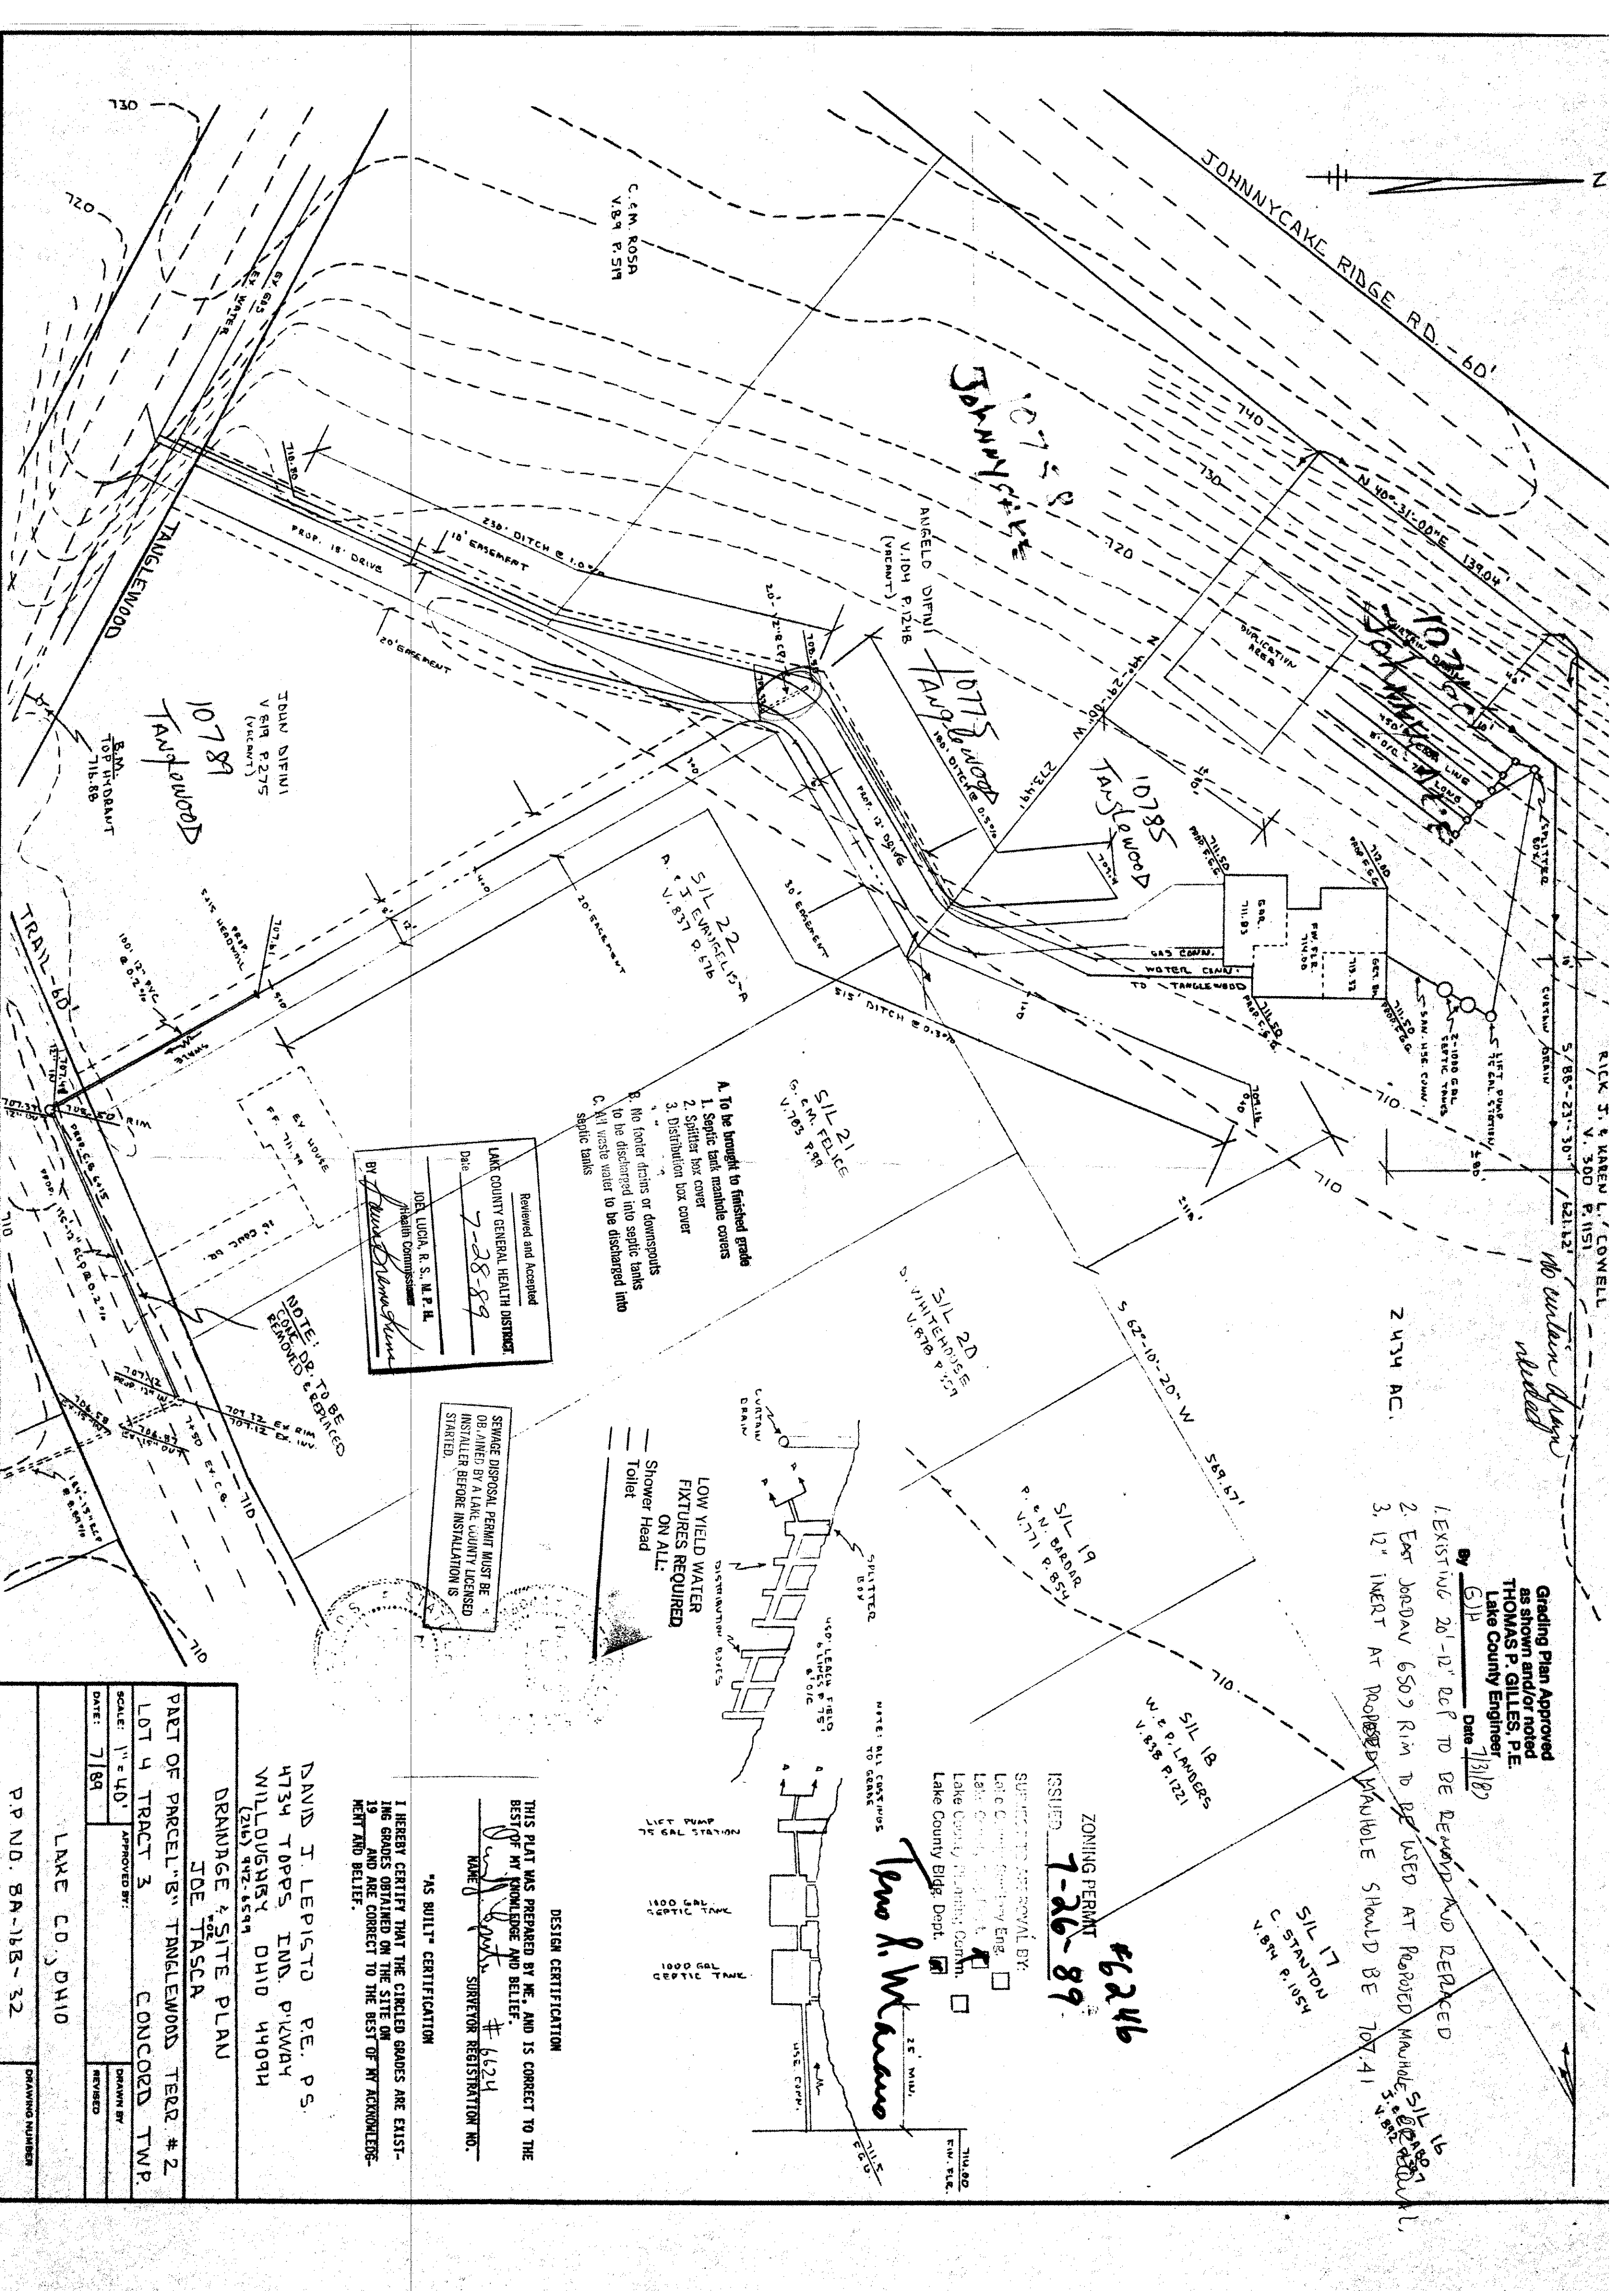


JOHNNYCAKE RIDGE RD. - 60'

JOHNNYCAKE

ANGLED DIFINI
V. 104 P. 1248
(VACANT)

10173
Tanglewood

10785
Tanglewood

10786
Tanglewood

10789
Tanglewood

TOWN DIFINI
V. 819 P. 275
(VACANT)

END
TOP HYDRAULT
716.88


TRAIL - 60'

- A. To be brought to finished grade
1. Septic tank manhole covers
 2. Sifter box cover
 3. Distribution box cover
- B. No footer drains or downspouts
to be discharged into septic tanks
- C. All waste water to be discharged into
septic tanks

Reviewed and Accepted
LAKE COUNTY GENERAL HEALTH DISTRICT
Date: 7-28-89
JOE LUCIA, R.S., M.P.E.
Health Commissioner
BY: [Signature]

NOTE: DR. TO BE REPAIRED
BEFORE RECORDING

SEWAGE DISPOSAL PERMIT MUST BE
OBTAINED BY A LAKE COUNTY LICENSED
INSTALLER BEFORE INSTALLATION IS
STARTED.

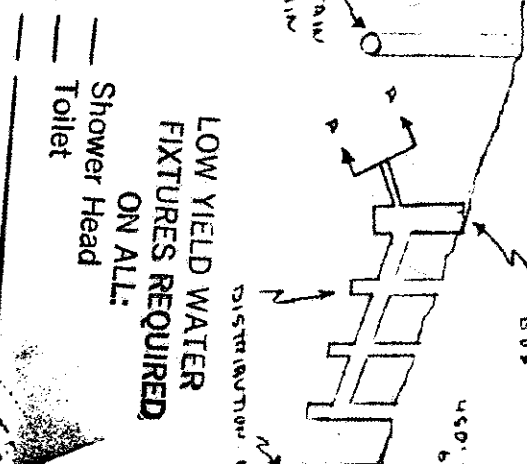

NOTE: ALL CONTAINERS
TO GRADE

25' MIN.

SUBMITTED FOR APPROVAL BY:
☐ Lake County Health Dept. Eng.
☐ Lake County Planning Comm.
☒ Lake County Bldg. Dept.

ISSUED
ZONING PERMIT
7-26-89

66246

- EXISTING 20'-12" RCP TO BE REPAIRED AND REPLACED
2. East JOHNNY 6509 RIM TO BE USED AT REPAIRED MANHOLE
 3. 12" INERT AT REPAIRED MANHOLE SHOULD BE 70741

Grading Plan Approved
as shown and/or noted
THOMAS P. GILLES, P.E.
Lake County Engineer
Date: 7/26/89

No water shown
included

DESIGN CERTIFICATION
THIS PLAN WAS PREPARED BY ME, AND IS CORRECT TO THE
BEST OF MY KNOWLEDGE AND BELIEF.
NAME: [Signature] # 6624
SURVEYOR REGISTRATION NO. [blank]
"AS BUILT" CERTIFICATION
I HEREBY CERTIFY THAT THE CIRCLED GRADES ARE EXIST-
ING GRADES OBTAINED ON THE SITE ON
19 [blank] AND ARE CORRECT TO THE BEST OF MY KNOWLEDGE-
MENT AND BELIEF.

DAVID J. LEPISTO P.E. P.S.
4734 TOPPS IND. PARKWAY
WILLOUGHBY OHIO 44094
(216) 942-6594
DRAINAGE & SITE PLAN
JOE TASCA
PART OF PARCEL "B" TANGLEWOOD TRACT # 2
LOT 4 TRACT 3 CONCORD TWP.
SCALE: 1" = 40'
DATE: 7/89
APPROVED BY: [Signature]
DRAWN BY: [Signature]
REVIEWED: [Signature]
LAKE CO. DAVID
P.P. NO. 8A-16B-32
DRAWING NUMBER