

Colcord Township, Lake County, Ohio

for: 20th Century Construction
CLIENT _____ OWNER _____

CLIENT **DINNER**

[illegible]

LOT	TRACT
VOLUME	PAGE
STREET	STREET
PREM. PARCEL NO.	
STREET	
VOL. - PG.	
10-12	
RESUBDIVISION	NAME
5	South Hollywood Hills No. 2
SUBJ. OF NO.	

LEGEND

SANITARY MANHOLE ———— 1
 STORM MANHOLE ———— 2
 INLET OR CATCH BASIN ————
 HYDRANT ———— 3
 EXISTING CONTOURS ————
 PROPOSED CONTOURS ————
 EXIST. ELEV. 100.0
 100.0 PROP. ELEV.
 WATER VALVE (GAS) ————
 WATER METER (GAS) ————
 AS BUILT ELEVATION ————
 INDICATES
 DIRECTION OF
 SURFACE DRAINAGE
 100.0

REMARKS

ALL BOUNDARY DATA SHOWN WAS OBTAINED FROM (DEEDS, RECORDED SUBDIVISION PLAT OR OTHER PUBLIC RECORDS)

LOCATIONS AS SHOWN OF ADJACENT WELLS AND SEPTIC TANKS OBTAINED FROM LAKE COUNTY HEALTH DEPARTMENT

DESIGN CERTIFICATION

THIS PLAT WAS PREPARED BY ME, AND IS CORRECT
TO THE BEST OF MY KNOWLEDGE AND BELIEF

NAME	SURVEYOR	REGISTRATION	NO.
------	----------	--------------	-----

 
CHECK LIST

NO. OF BEDROOMS DIMENSIONS BEARINGS THE TO NEAREST STREET SUBLOT NO. PARCEL NO. SURROUNDING OWNERS BLDG. DIMENSIONS: FIN. GR. BLDG. TIES P.L.R. GRADES APRON TYPE WIDTH THICKNESS SIDEWALK TYPE WIDTH THICKNESS CULVERT TYPE DIA. LENGTH ROCK OUTCROPPINGS	WATER MAIN SIZE, LOCATION SAN. SEWER SIZE % GR. LOC. SAN. INV. CAST ELEV. INV. ELEV. SAN. CONN. SIZE, LOC. DEPTH STORM SEWER SIZE % GR. LOC. STORM INV. CAST ELEV. INV. ELEV. PAV'T TYPE GRADE CURBS GAS LINE LOC. SIZE PRESSURE SEPTIC TANK LOCATION & DUFFICATION AREA WELL, LOCATION ISOLATION RADIIUS FROM WELL
1	
2	
3	
PLAN PREPARED BY:

BABCOCK • JONES & ASSOCIATES, INC.

110

DRAWN BY  SCALE 1" = 20' PHONE NO. 357-1811

9

CREW
CHIEF
APP'D. *[Signature]*
6-5
89-247-5

"AS BUILT" CERTIFICATION

I, HEREBY CERTIFY THAT THE CIRCLED GRADES ARE EXISTING
FINISH GRADES CHECKED IN THE FIELD ON _____, 19____
AND ARE CORRECT TO THE BEST OF MY KNOWLEDGE AND BELIEF.

REGISTERED SURVEYOR

REG. NO.

$T_{B.M.} = \lim_{S \rightarrow \infty} S M M H$

0257, = 856.77


Zone 1 #5853

6-27-88

[illegible]

☐ Other
☐ County of ...
☐ City of ...
☐ State of ...

Ben J. Mearns

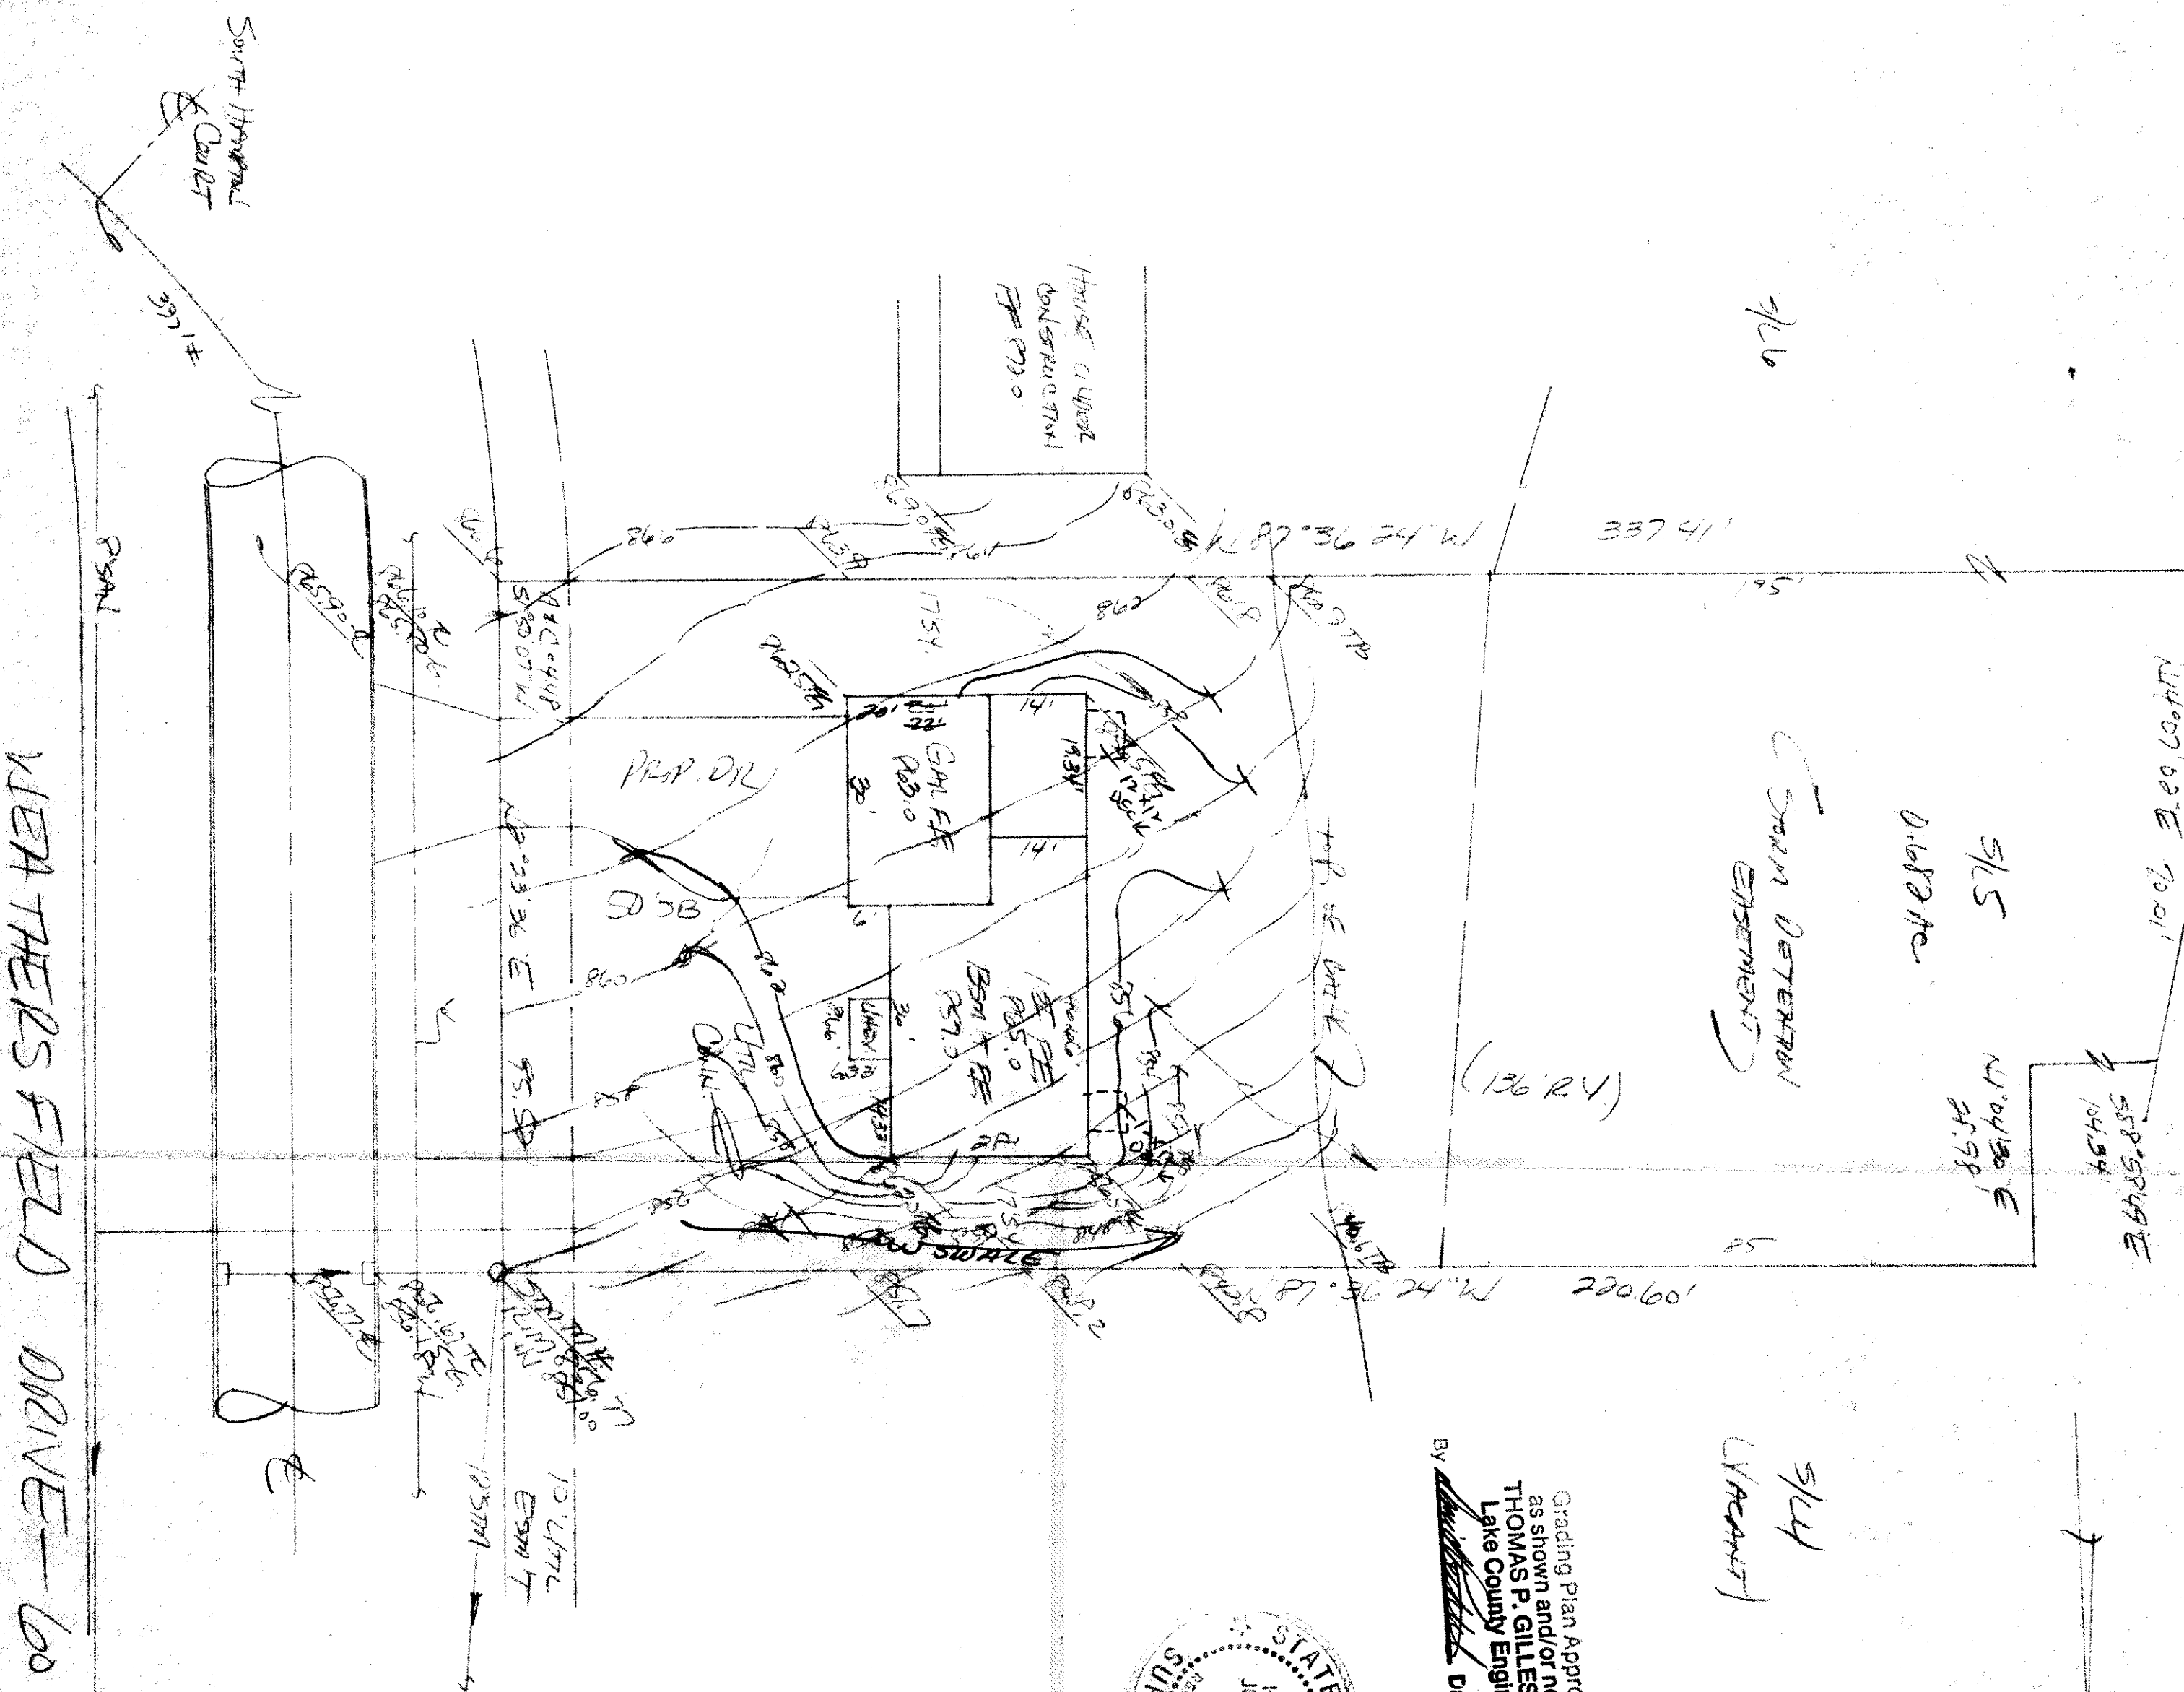

Grading Plan Approved
as shown and/or noted
THOMAS P. GILLES, P.E.
Lake County Engineer

By  Date 7/2/14

