


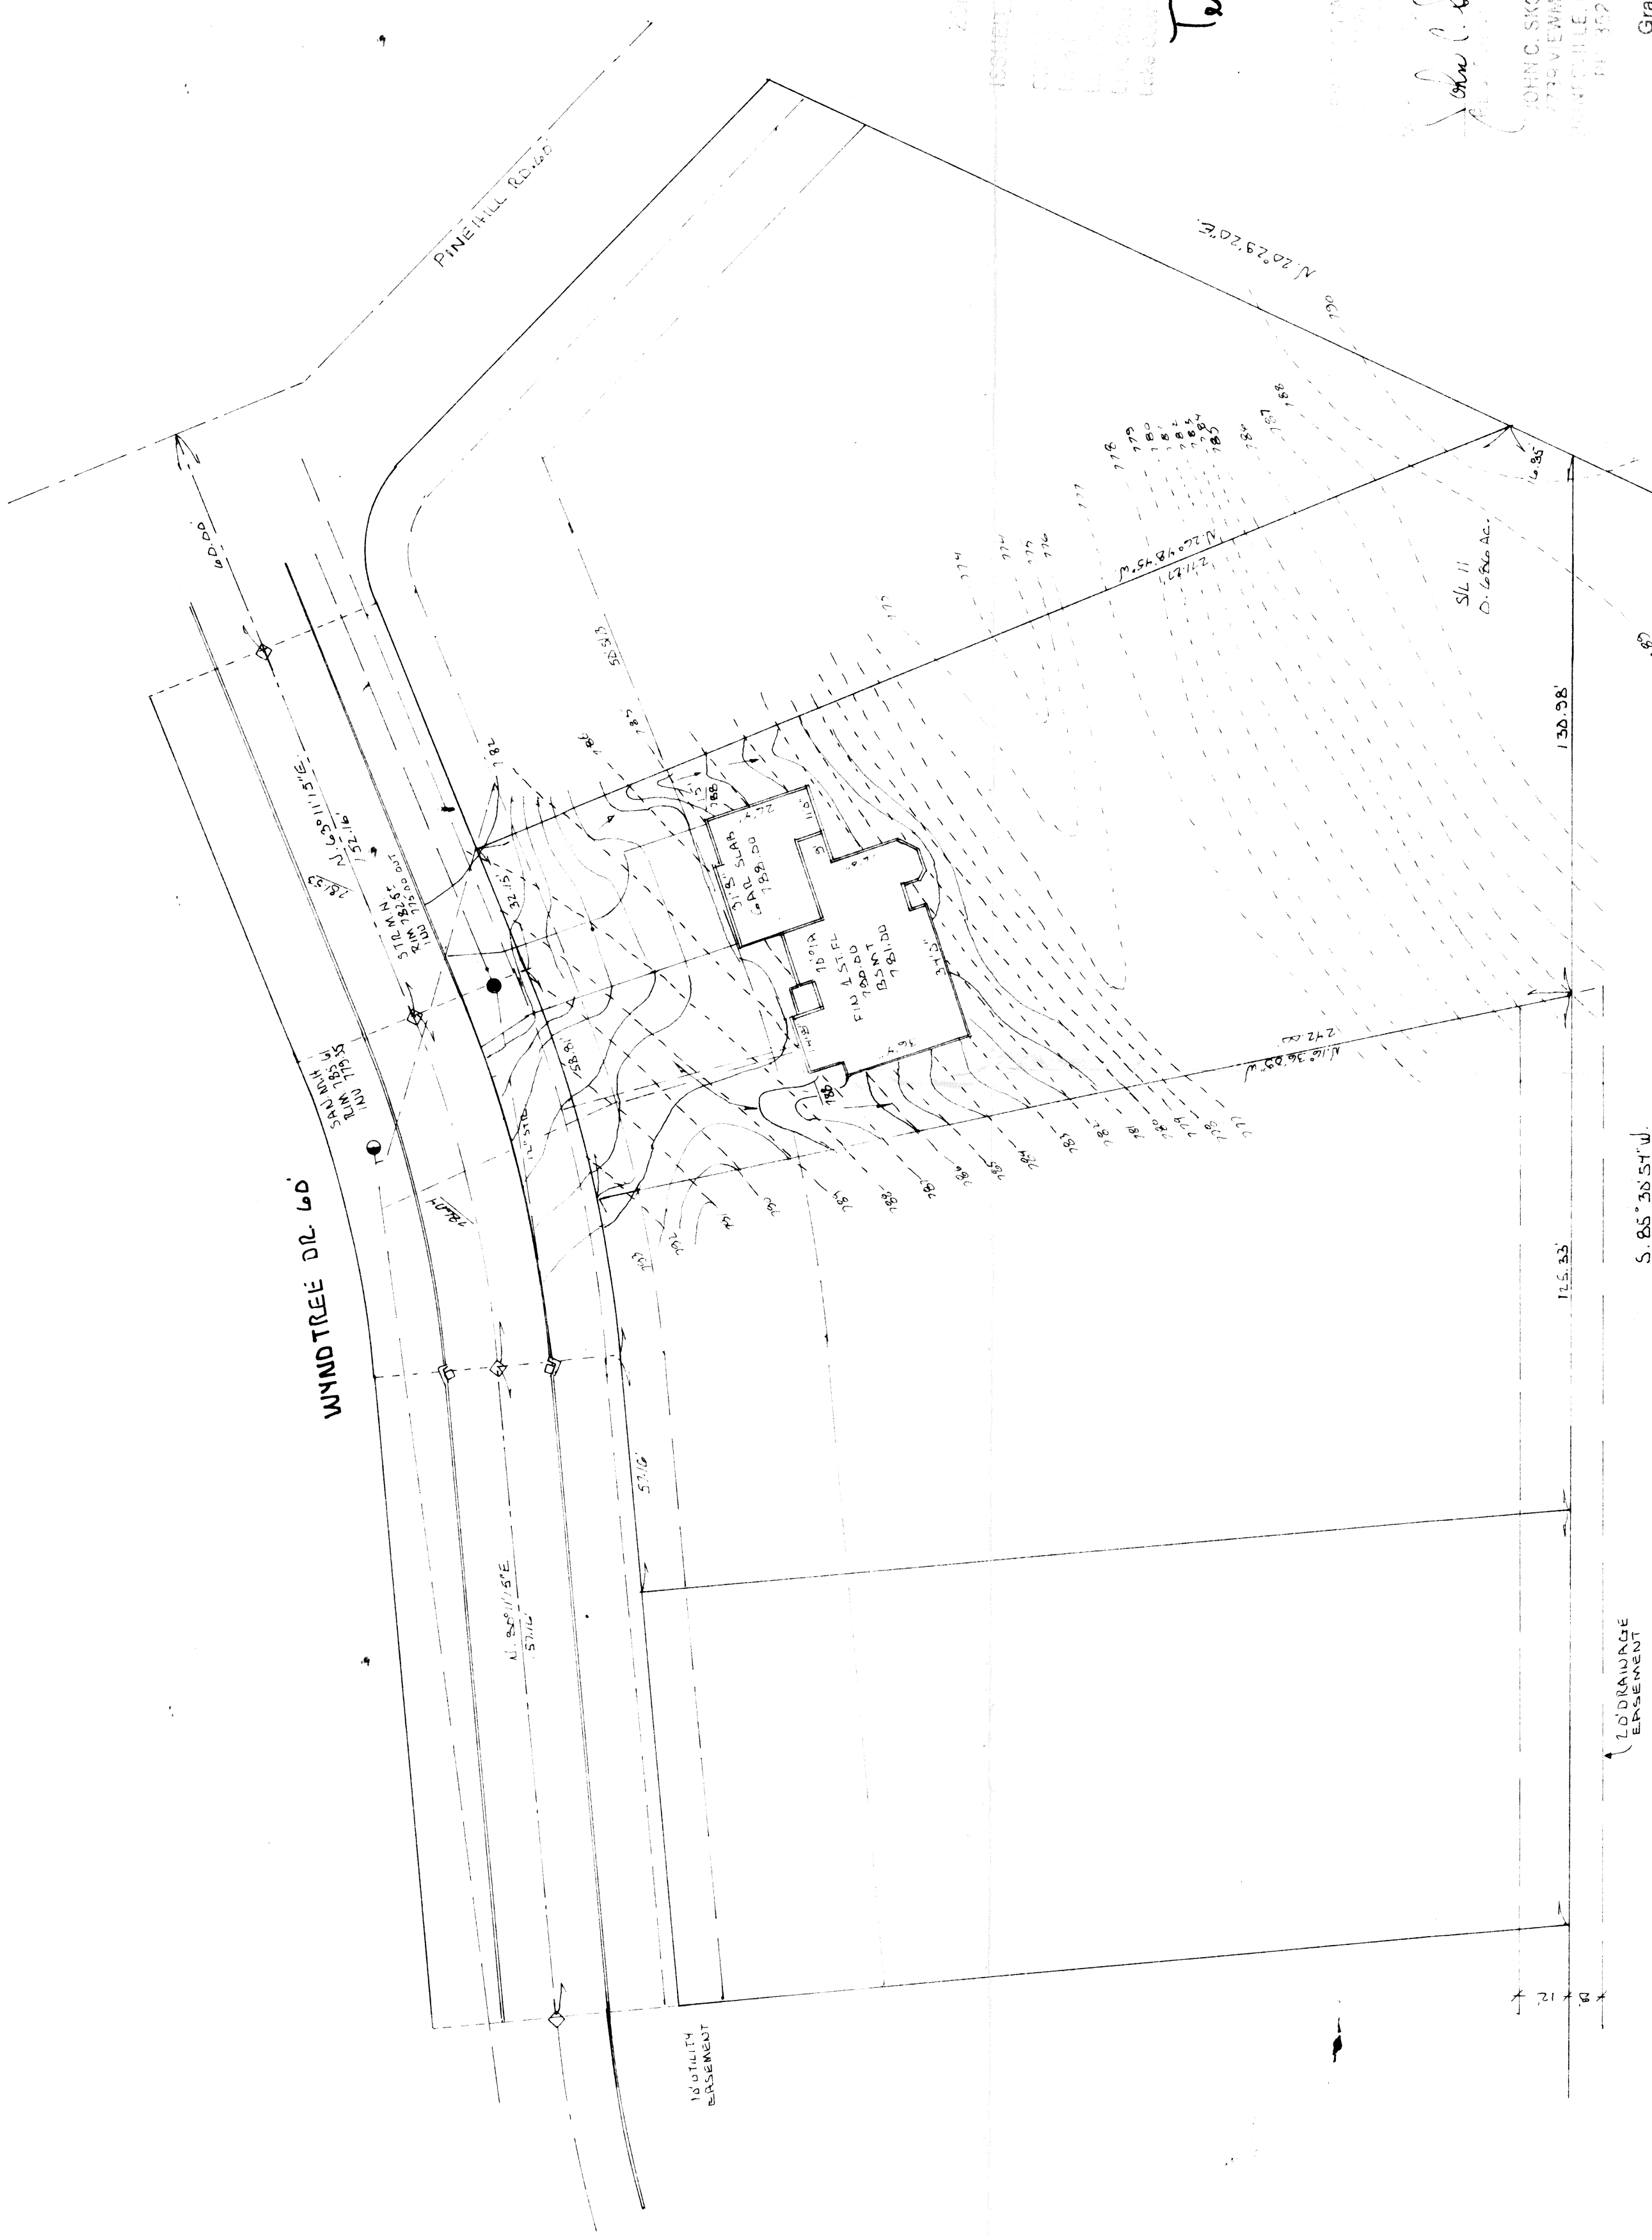

#5468

4-9-87

Teno S. Marans

JOHN C. SKONCANY
7719 VEWALKER RD.
MANTOLLO, OHIO 44130
PH: 352-7742

JOHN C. SKONCANY
7719 VEWALKER RD.
MANTOLLO, OHIO 44130
PH: 352-7742

Grading Plan Approved
as shown and/or noted
THOMAS P. GILLES, P.E.
Lake County Engineer
By *[Signature]* Date 4-13-87

EXISTING GRADES
FLOORED

SITE PLAN FOR:
IDEAL AMERICAN HOMES INC.

SCALE: 1"=30'	APPROVED BY: <i>[Signature]</i>	DRAWN BY: JCL
DATE: APR. 87		PLAT: 13-B-1
BEING SUBLOT 10, 11, 12 & 13 IN THE WINDTREE SUBDIVISION		
TOWNSHIP OF COALCOED COUNTY OF LAKE STATE OF OHIO		
DRAWING NUMBER: 27-536		

NOTE: DRIVE LOCATION SHOULD
BE CHANGED 50' TO AVOID
SW. SW. MH.

JOB Nos.
S/L 10 27-611
S/L 11
S/L 12
S/L 13