
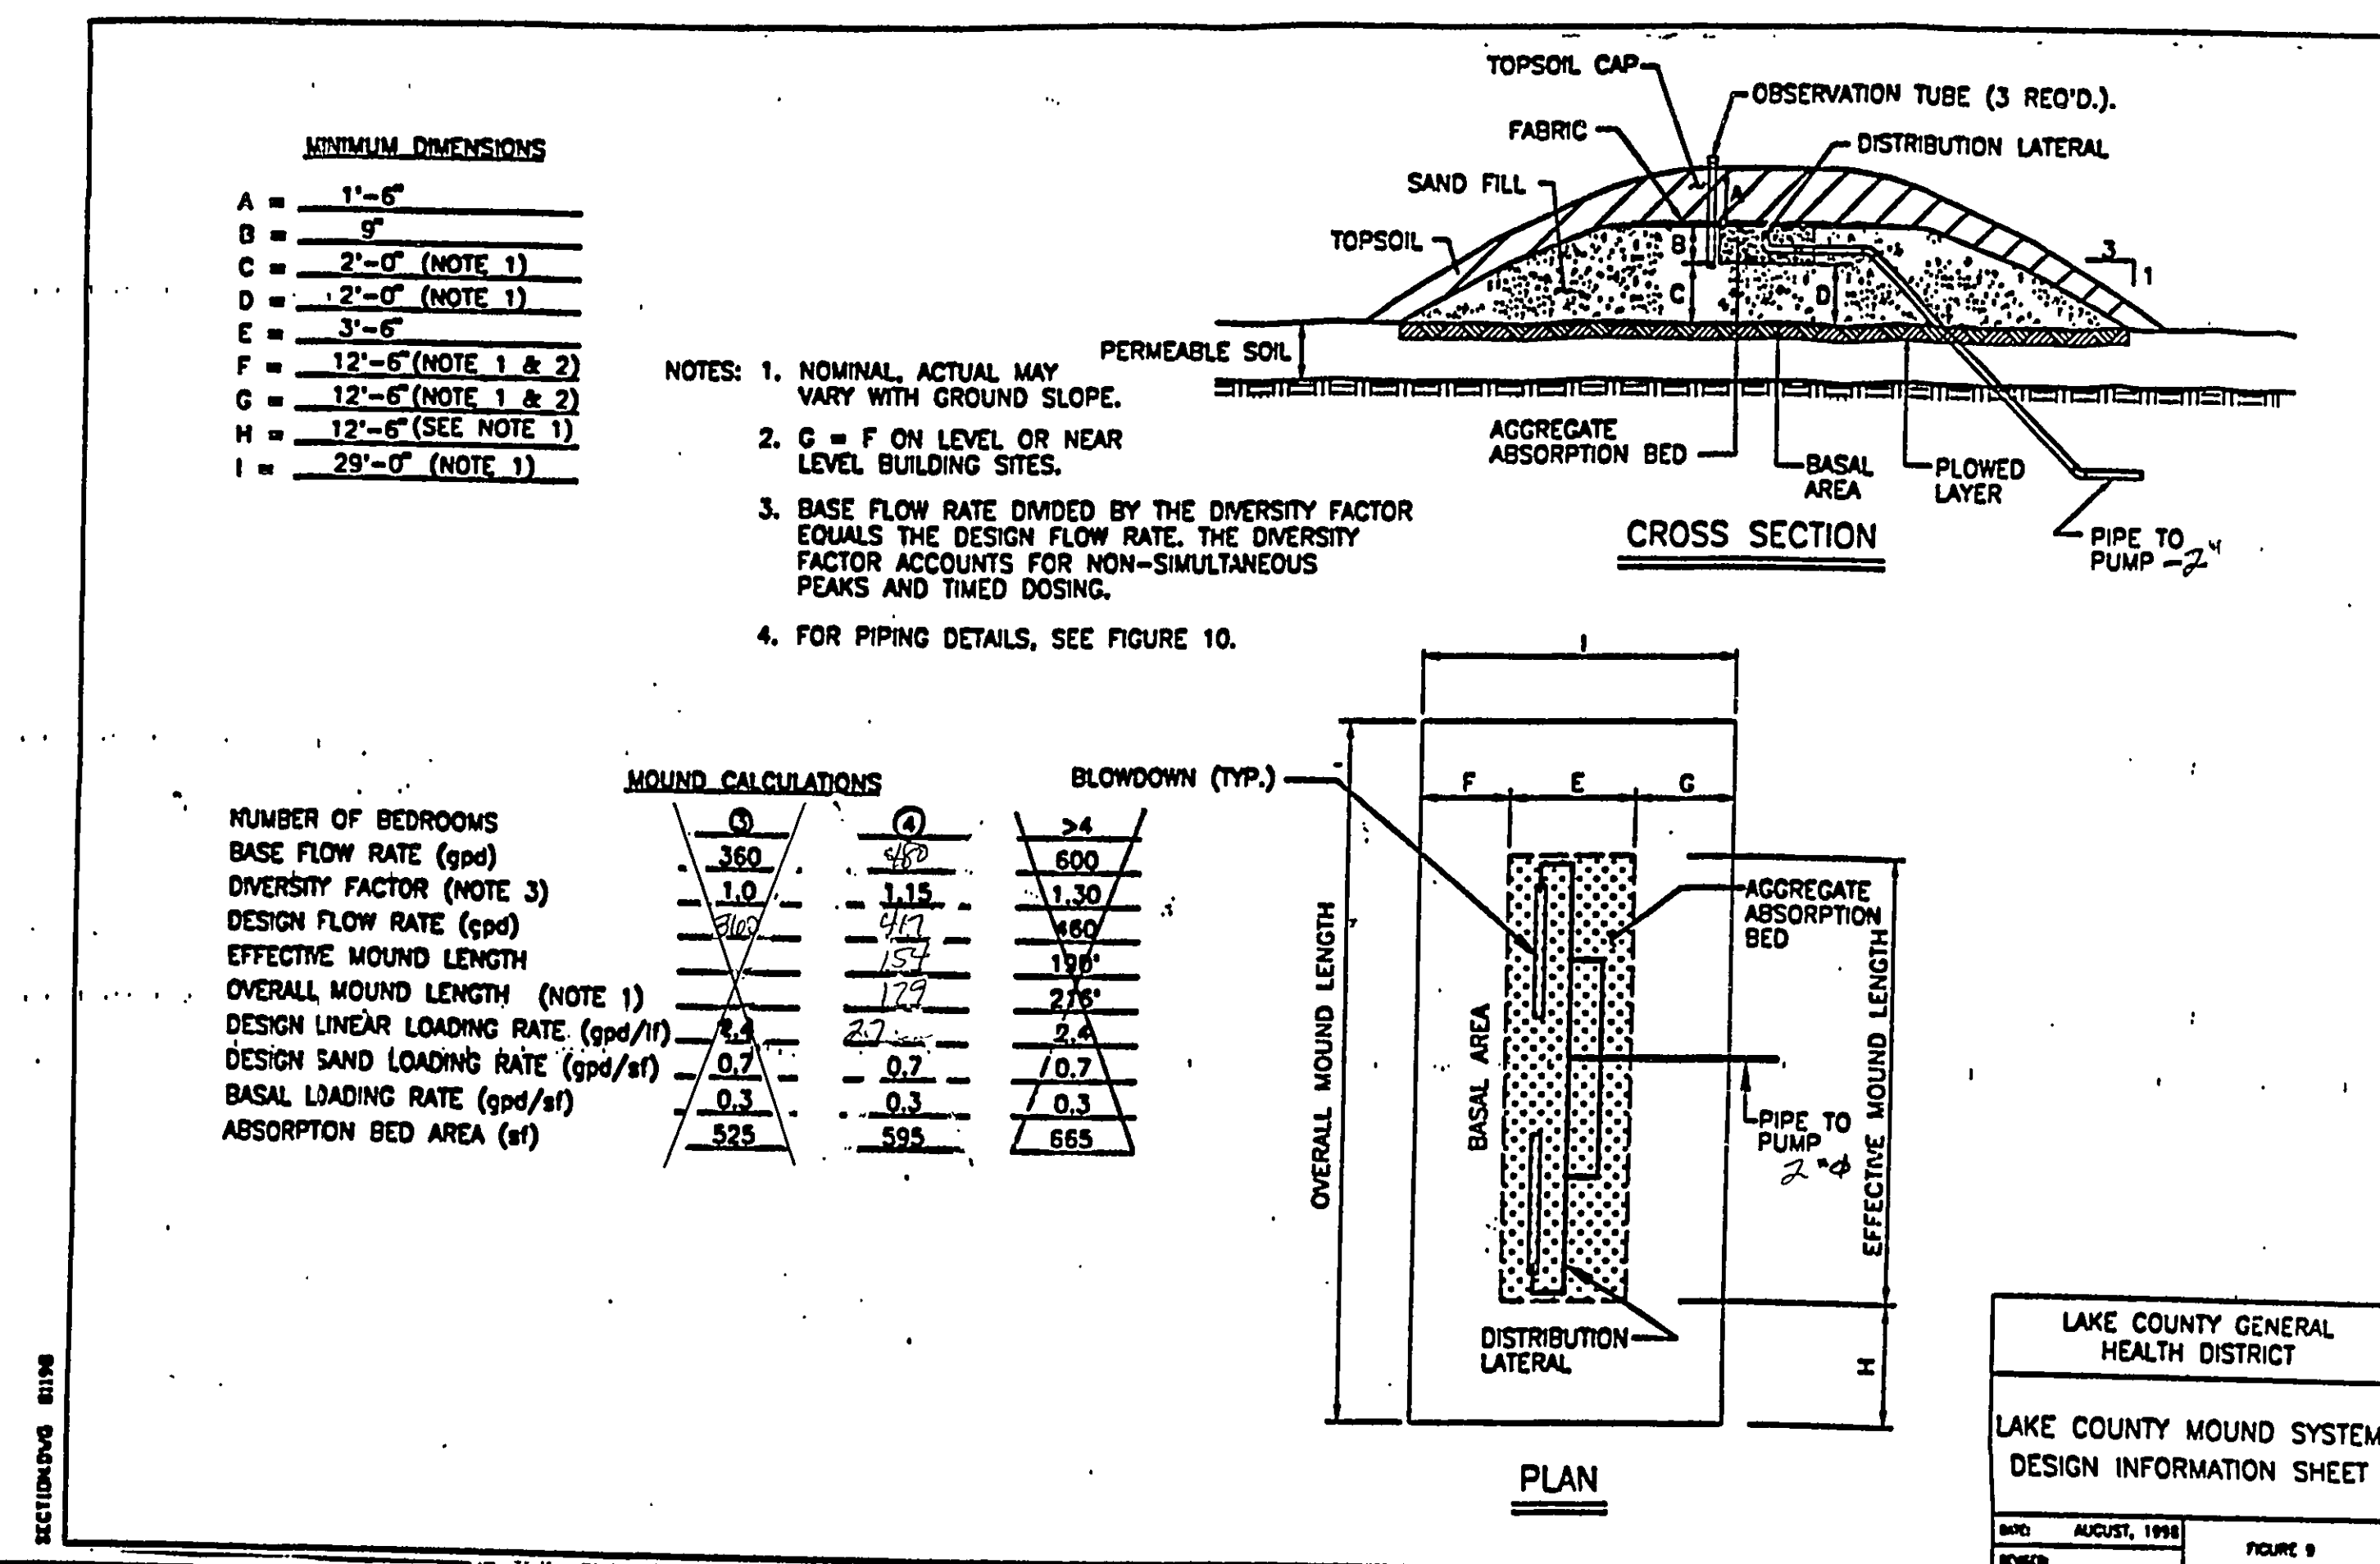
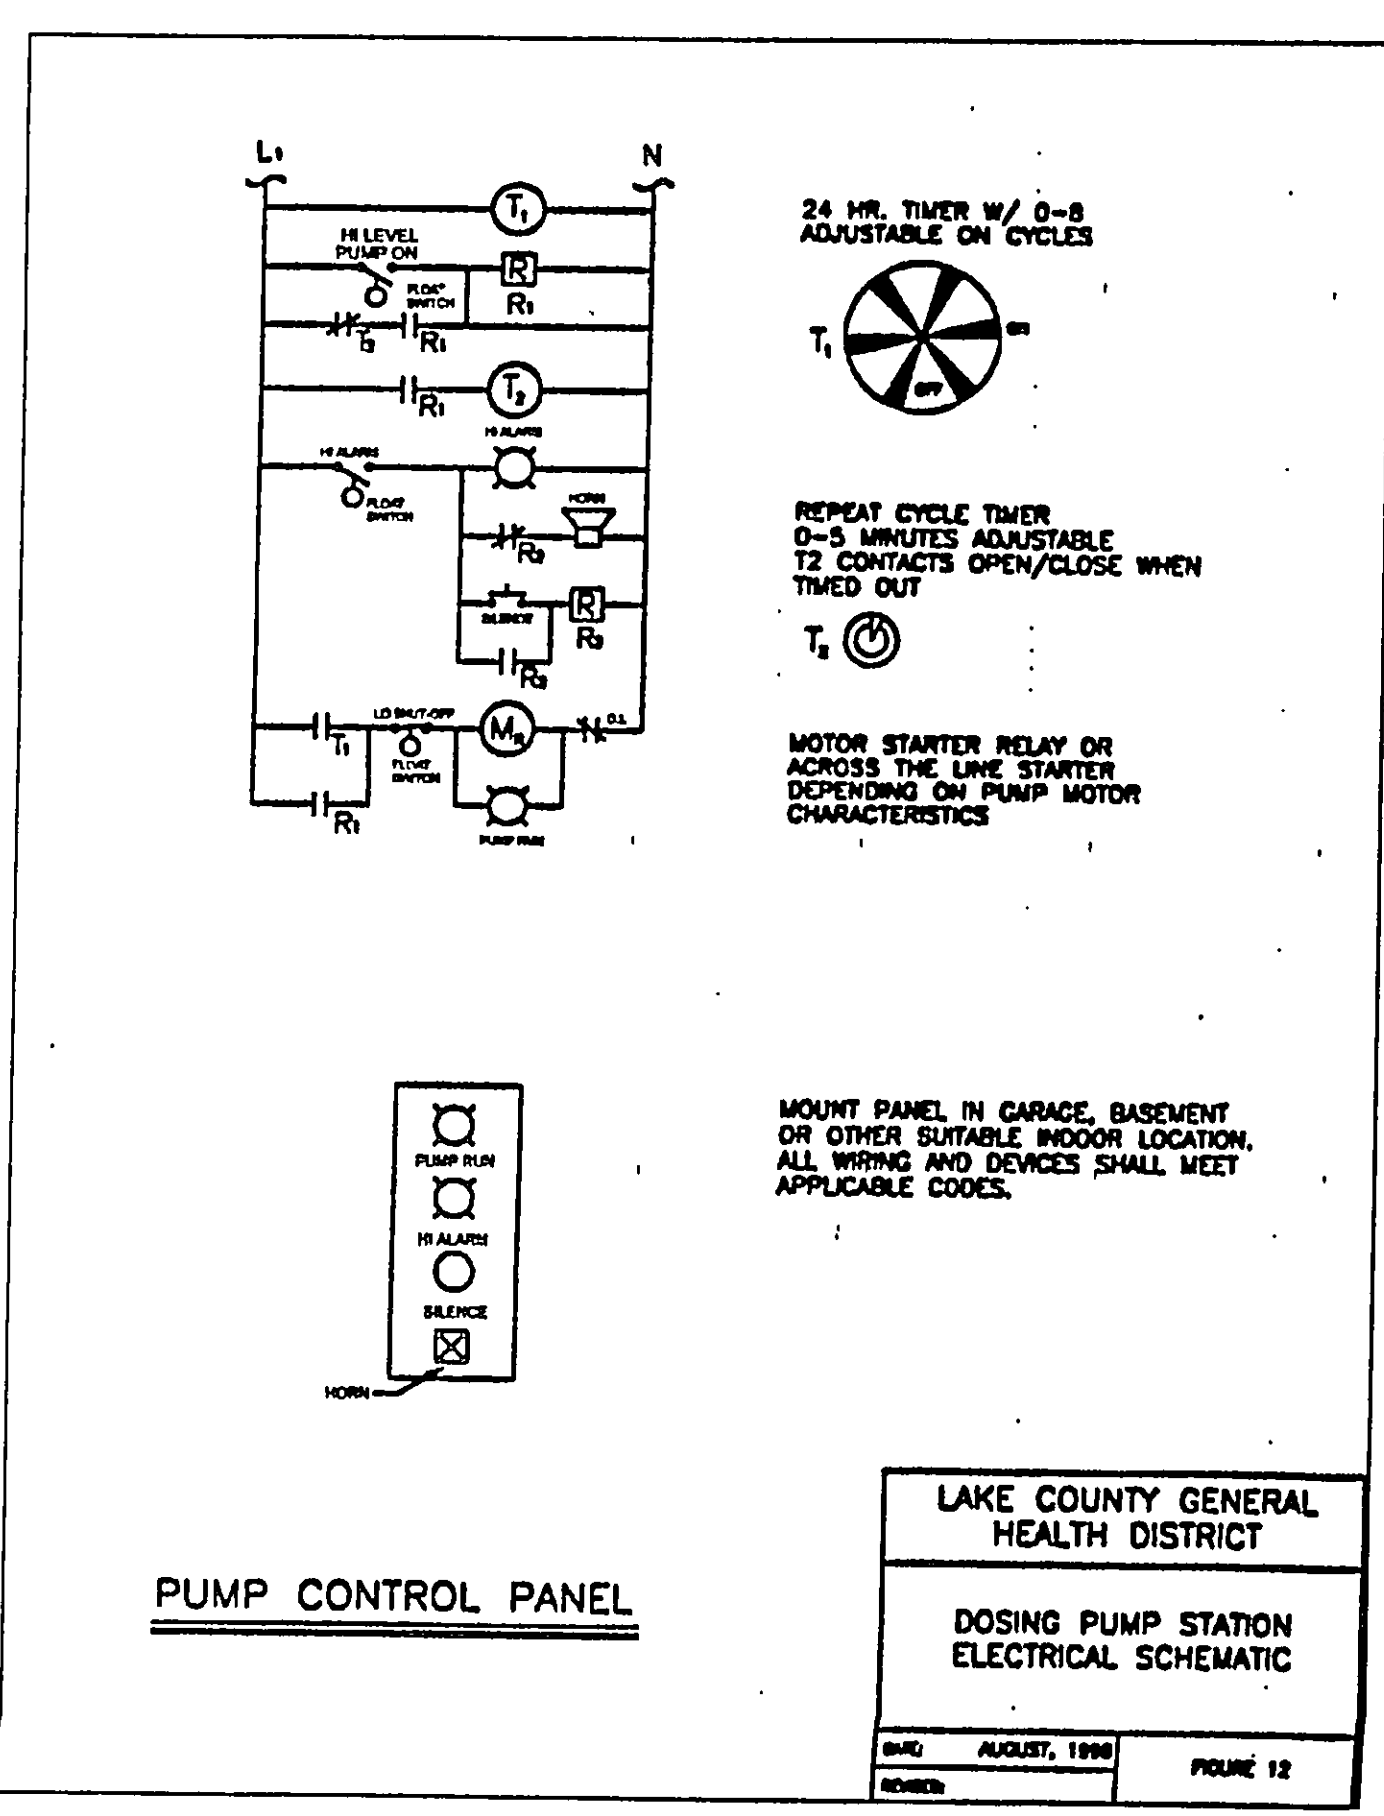
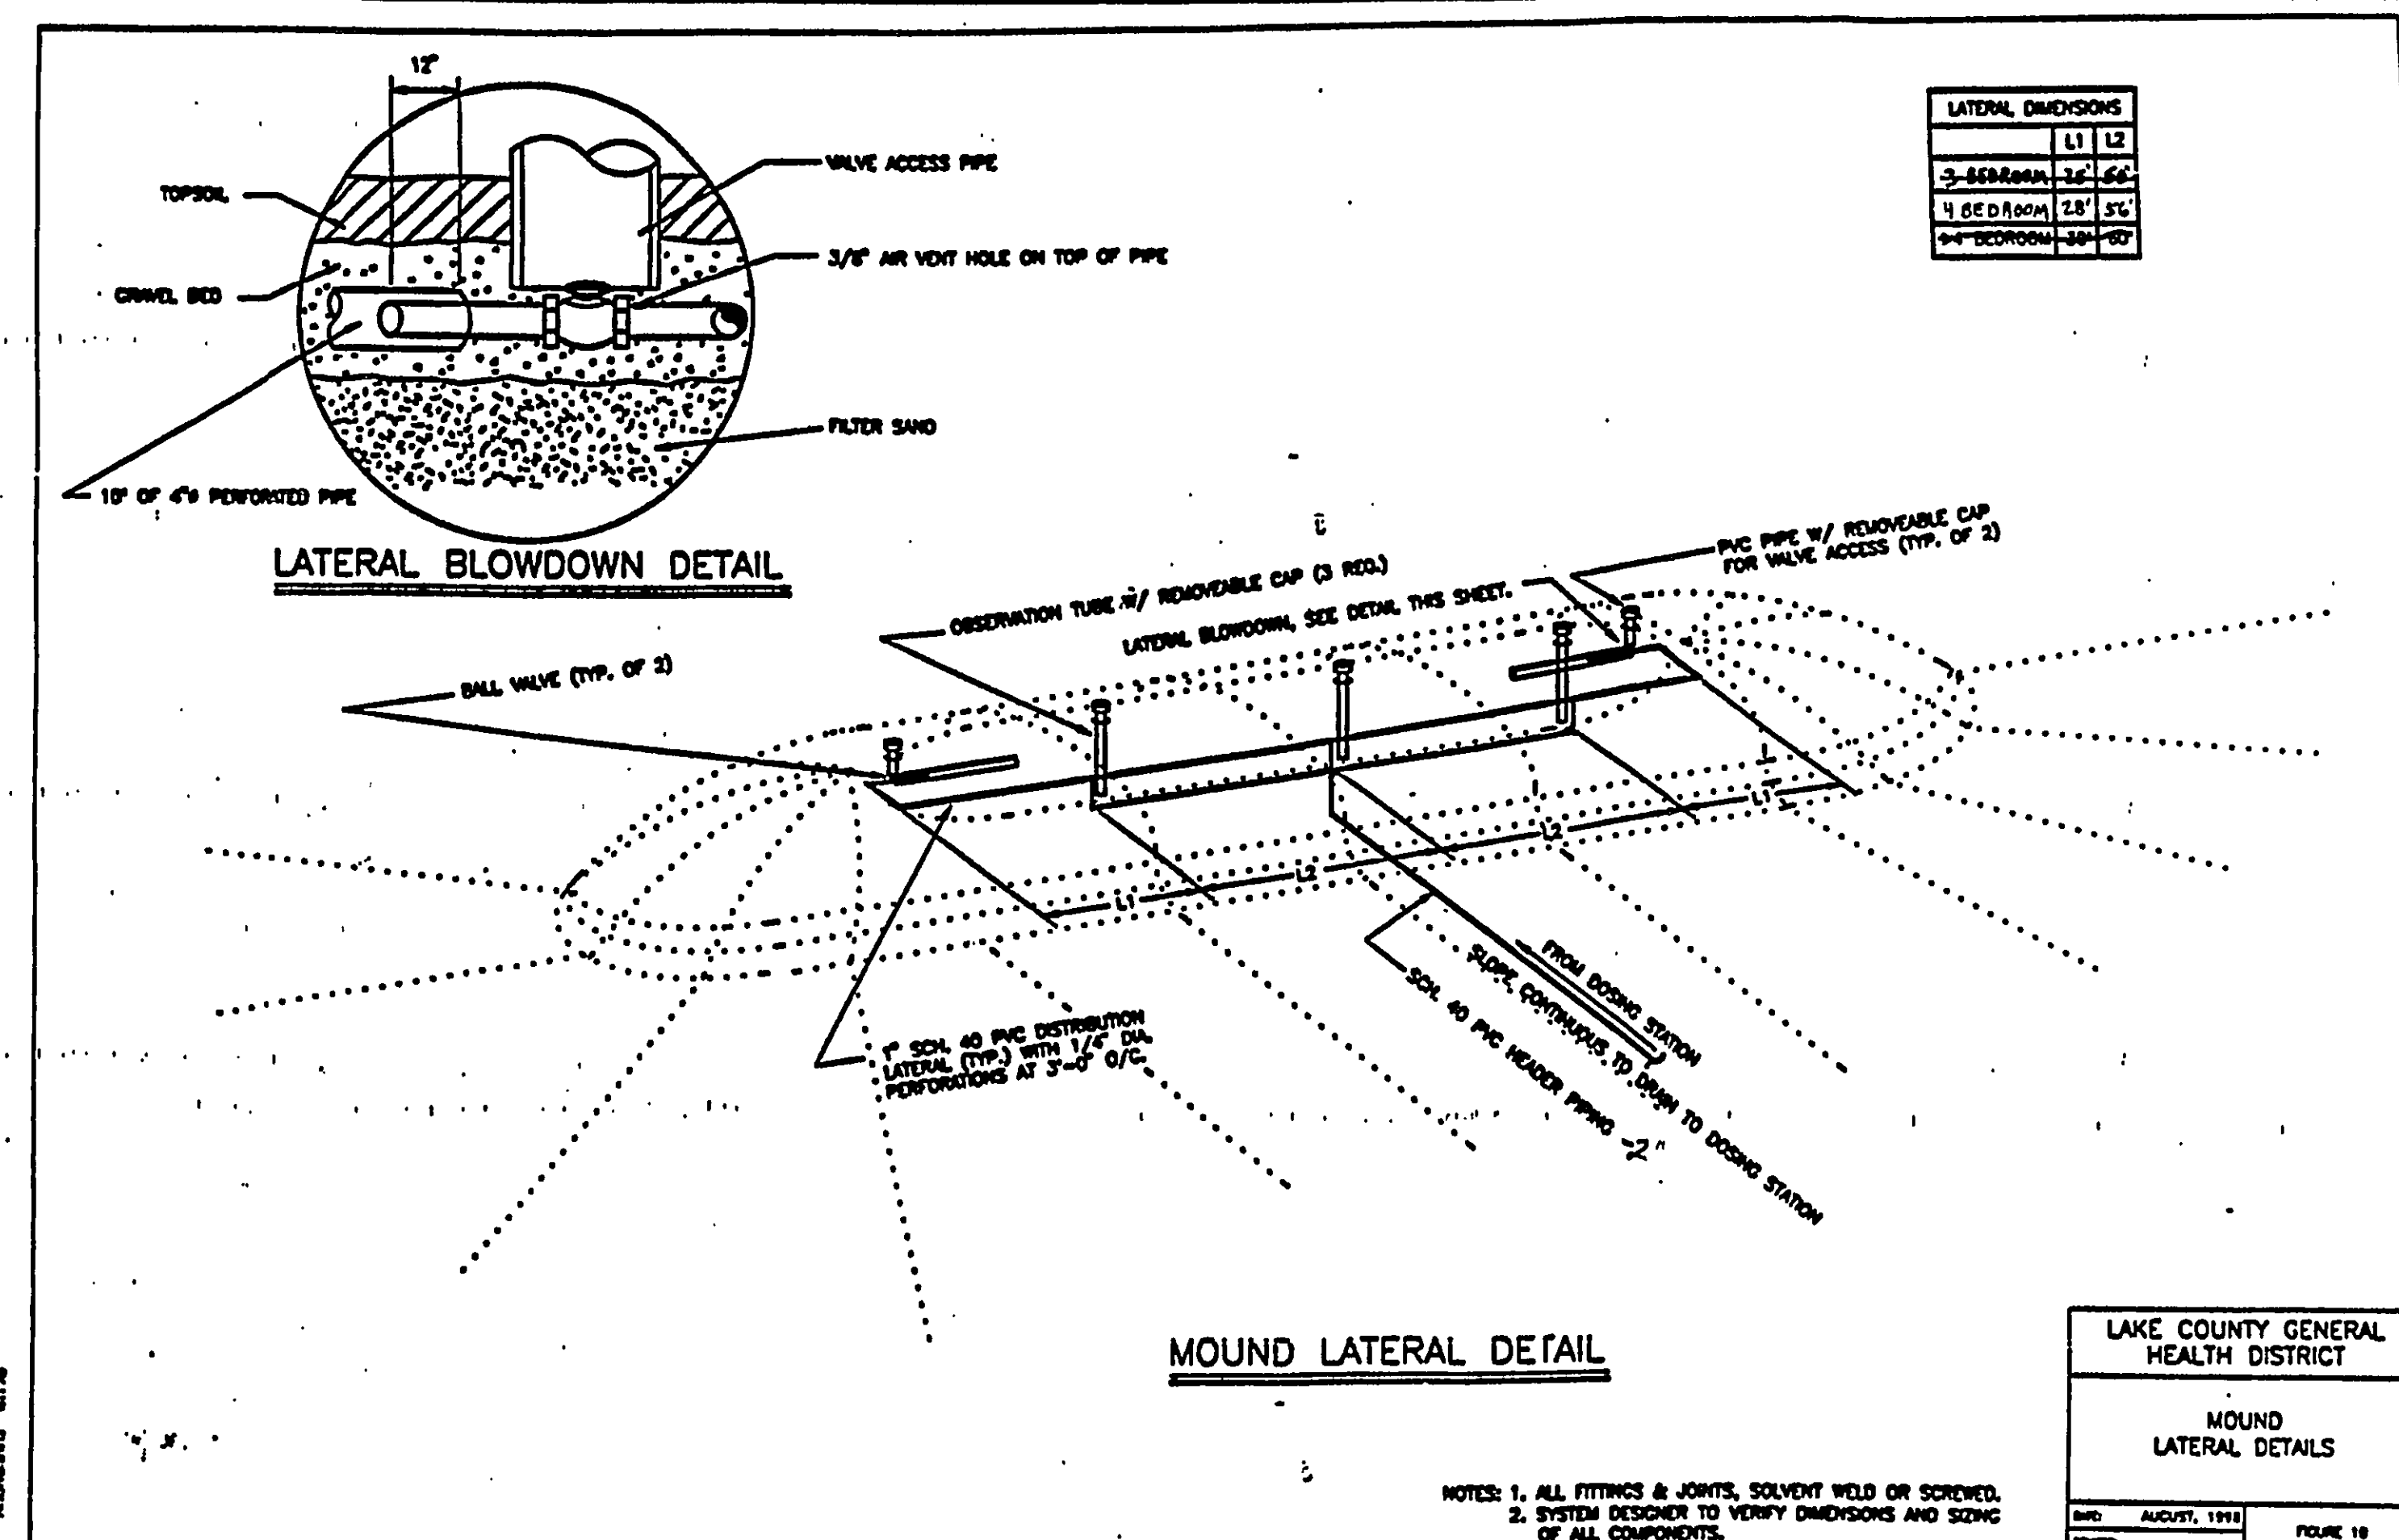


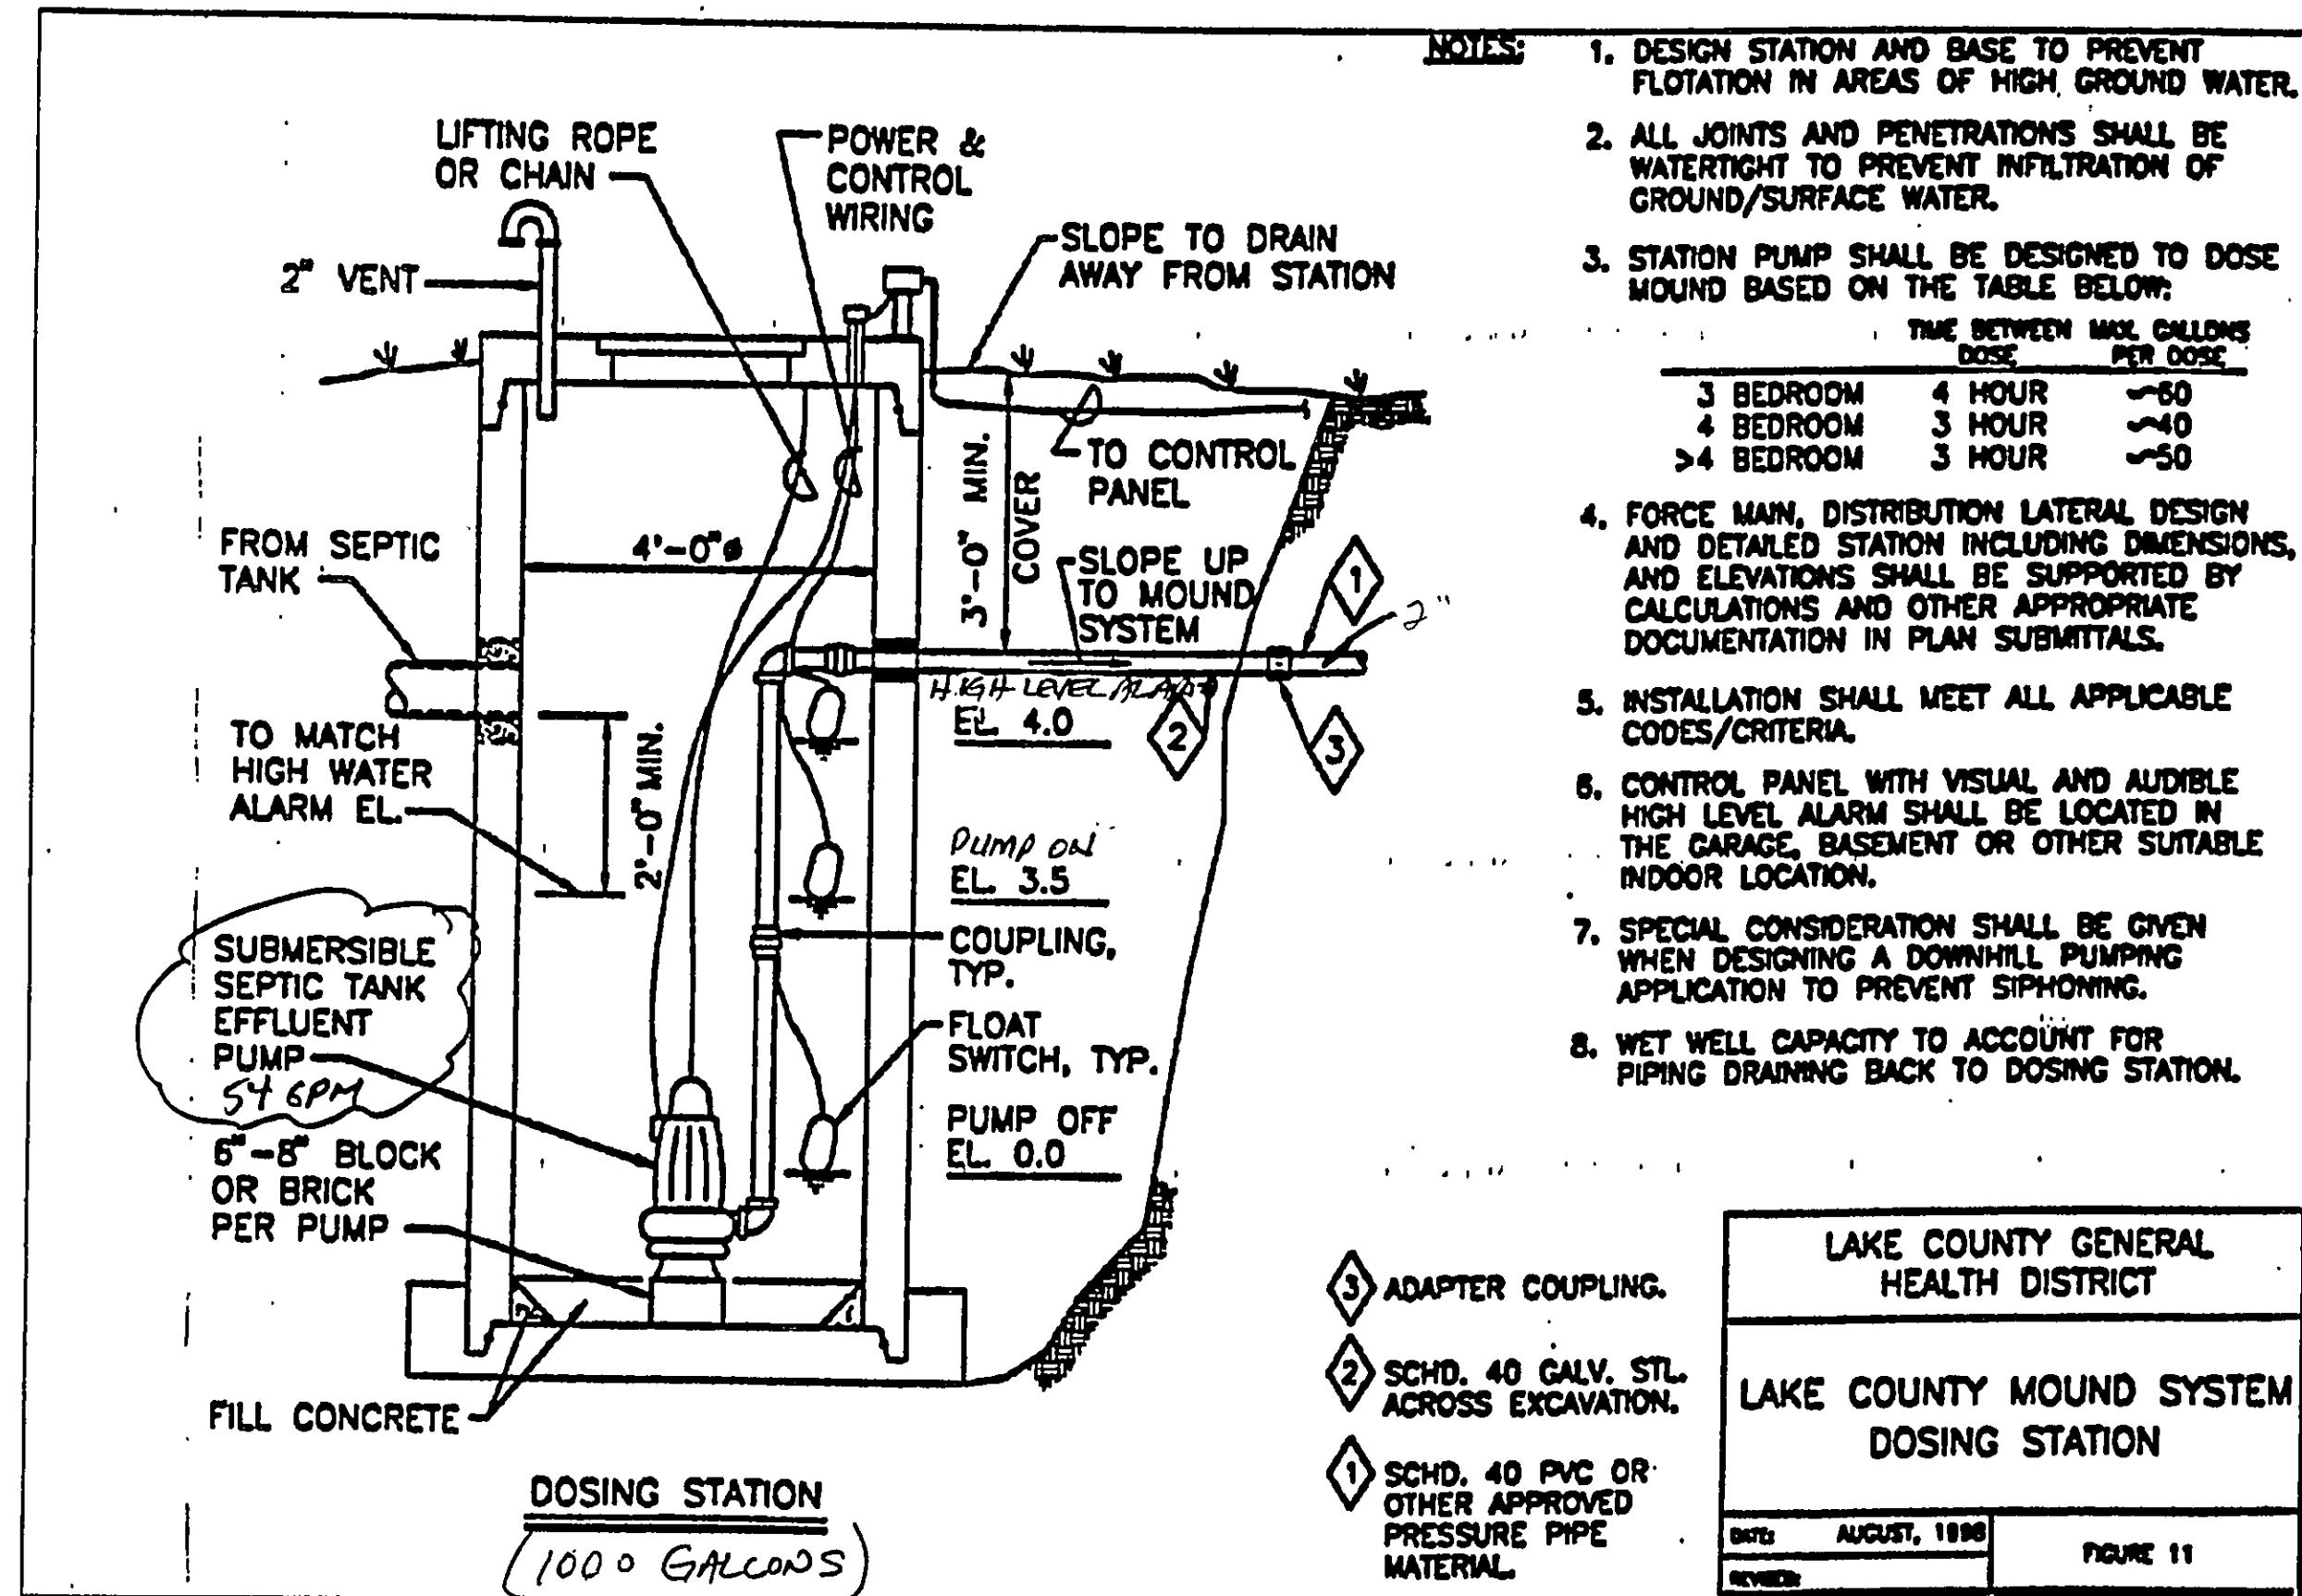

REV. NO.	DESCRIPTION	DATE	BY	CHK'D

babcock, jones and associates, inc
 CIVIL ENGINEERS - SURVEYORS - LAND PLANNERS
 PAINESVILLE OHIO 44067
 440-357-1871 (6) 440-857-9735 (E)

DATE: 3/16/04
 DESIGN BY: H.J.
 DRAWN BY: T.R.
 APPROVED BY: H.J.

SITE PLAN FOR
 KERL BUILDINGS
 5155 FOXWOOD FOREST SUB
 CITY OF KIRTLAND
 LAKE COUNTY

SCALE: None
 SHEET 2 OF 2